



This document and the design it covers are the property of PARSONS. They are loaned only with the borrower's expressed written agreement that they will not be reproduced, copied, loaned, exhibited, or used in any other way, except by written consent from PARSONS to the borrower.

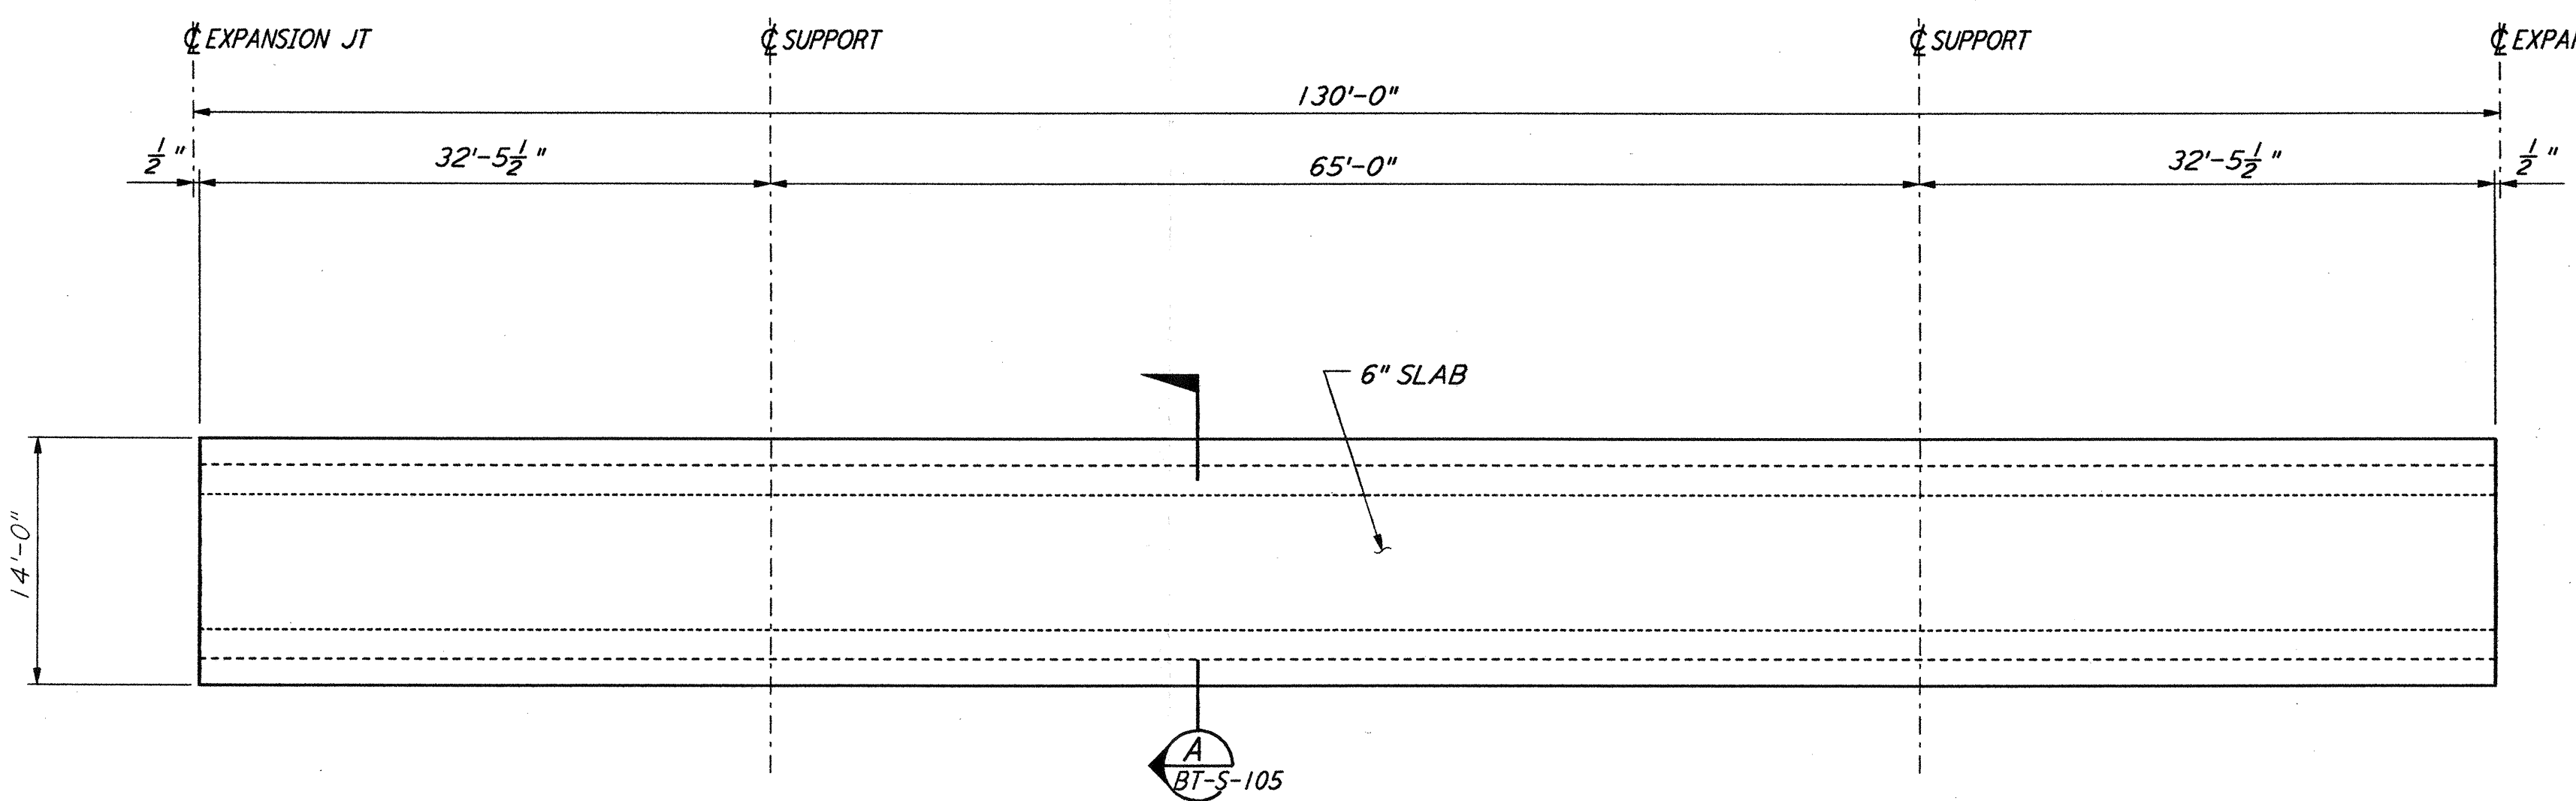


TYPICAL SLAB BETWEEN EXPANSION JOINTS

DETAIL 1 REF  
 $\frac{1}{8}'' = 1'-0''$  BT-S-106 BT-S-104

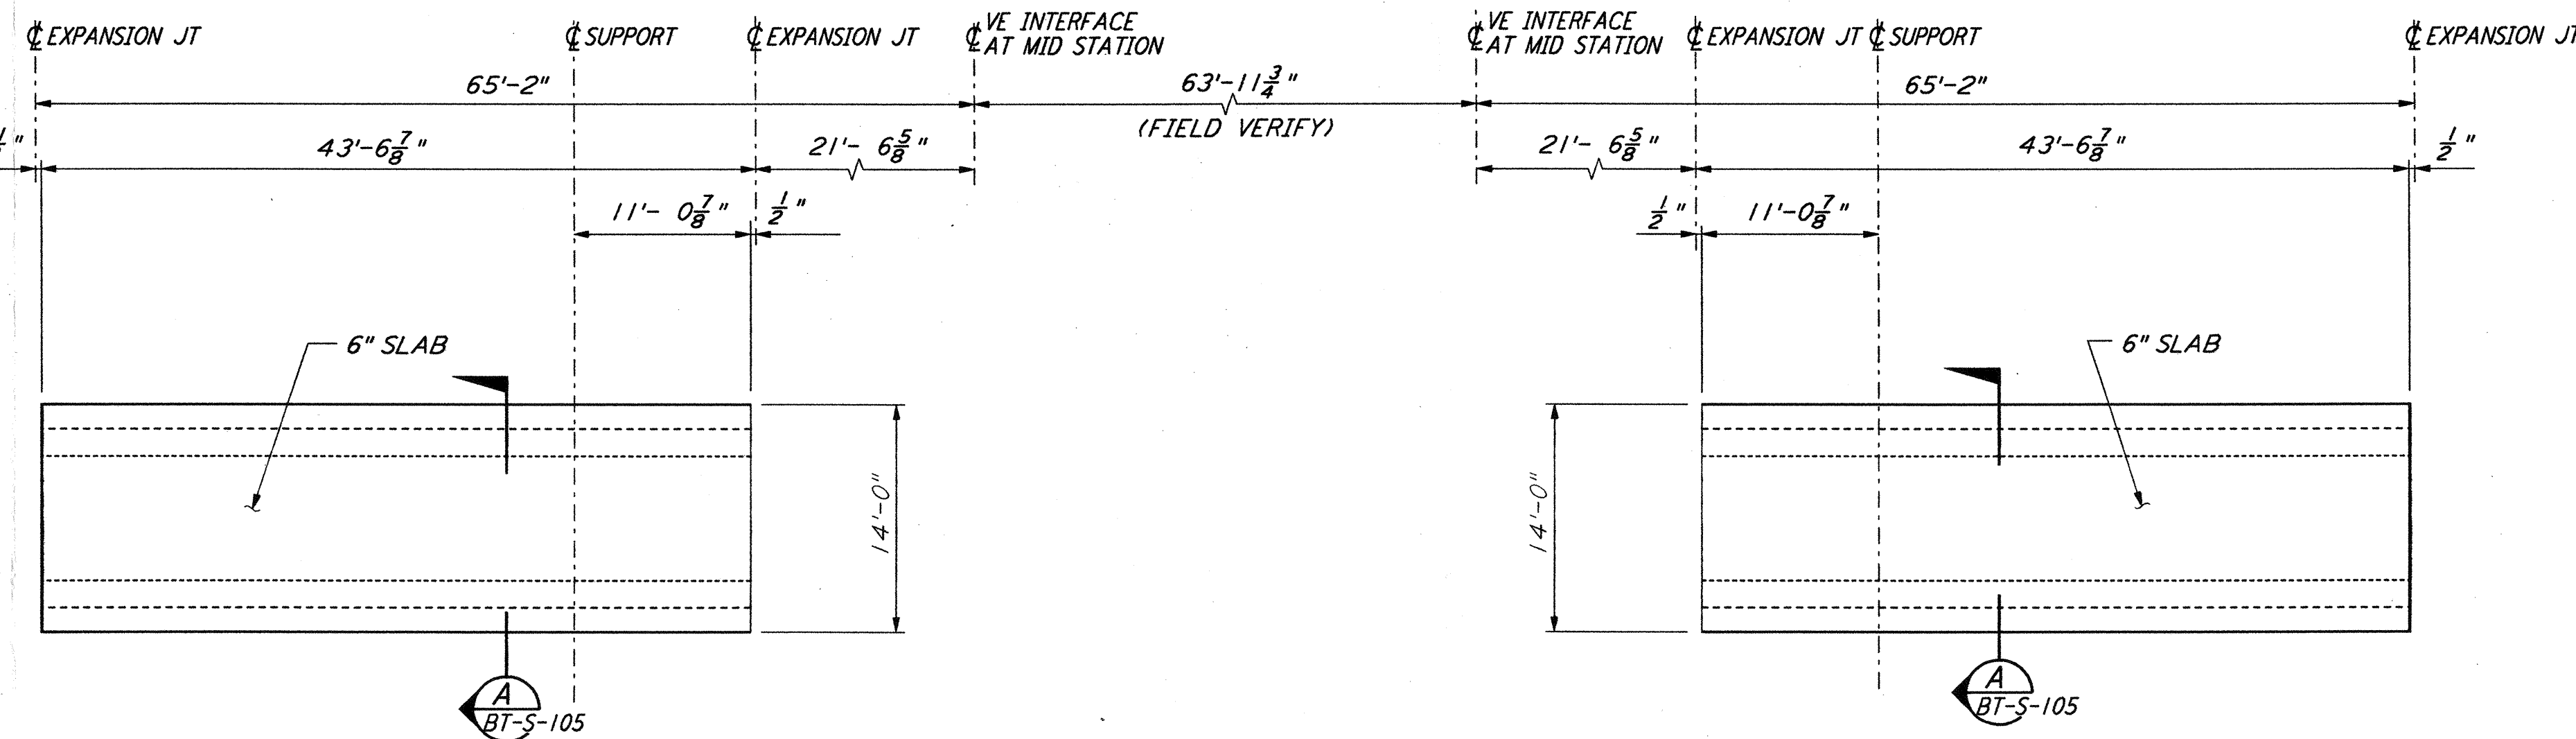


TYPICAL SLAB AT MID STATION

DETAIL 2 REF  
 $\frac{1}{8}'' = 1'-0''$  BT-S-106 BT-S-104 BT-S-105

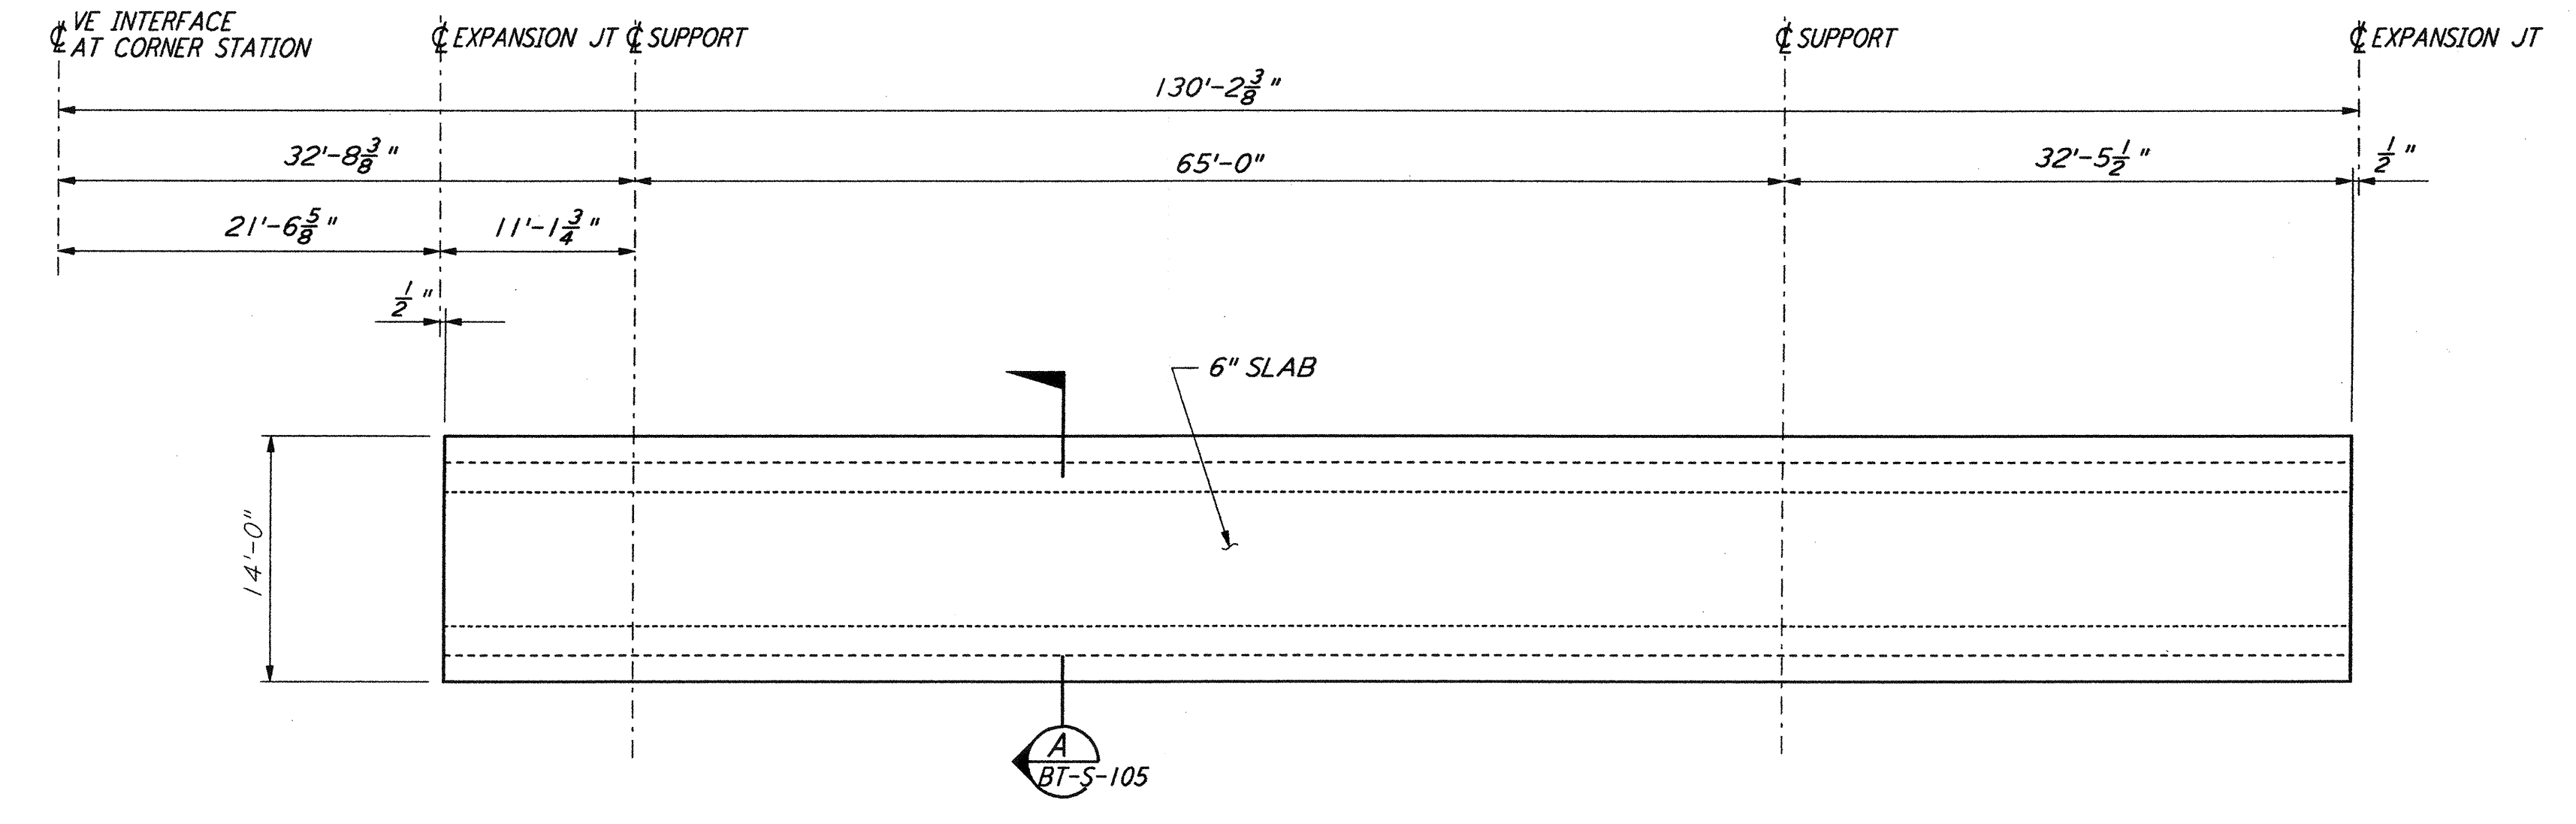


TYPICAL SLAB AT CORNER STATION

DETAIL 3 REF  
 $\frac{1}{8}'' = 1'-0''$  BT-S-106 BT-S-104 BT-S-105

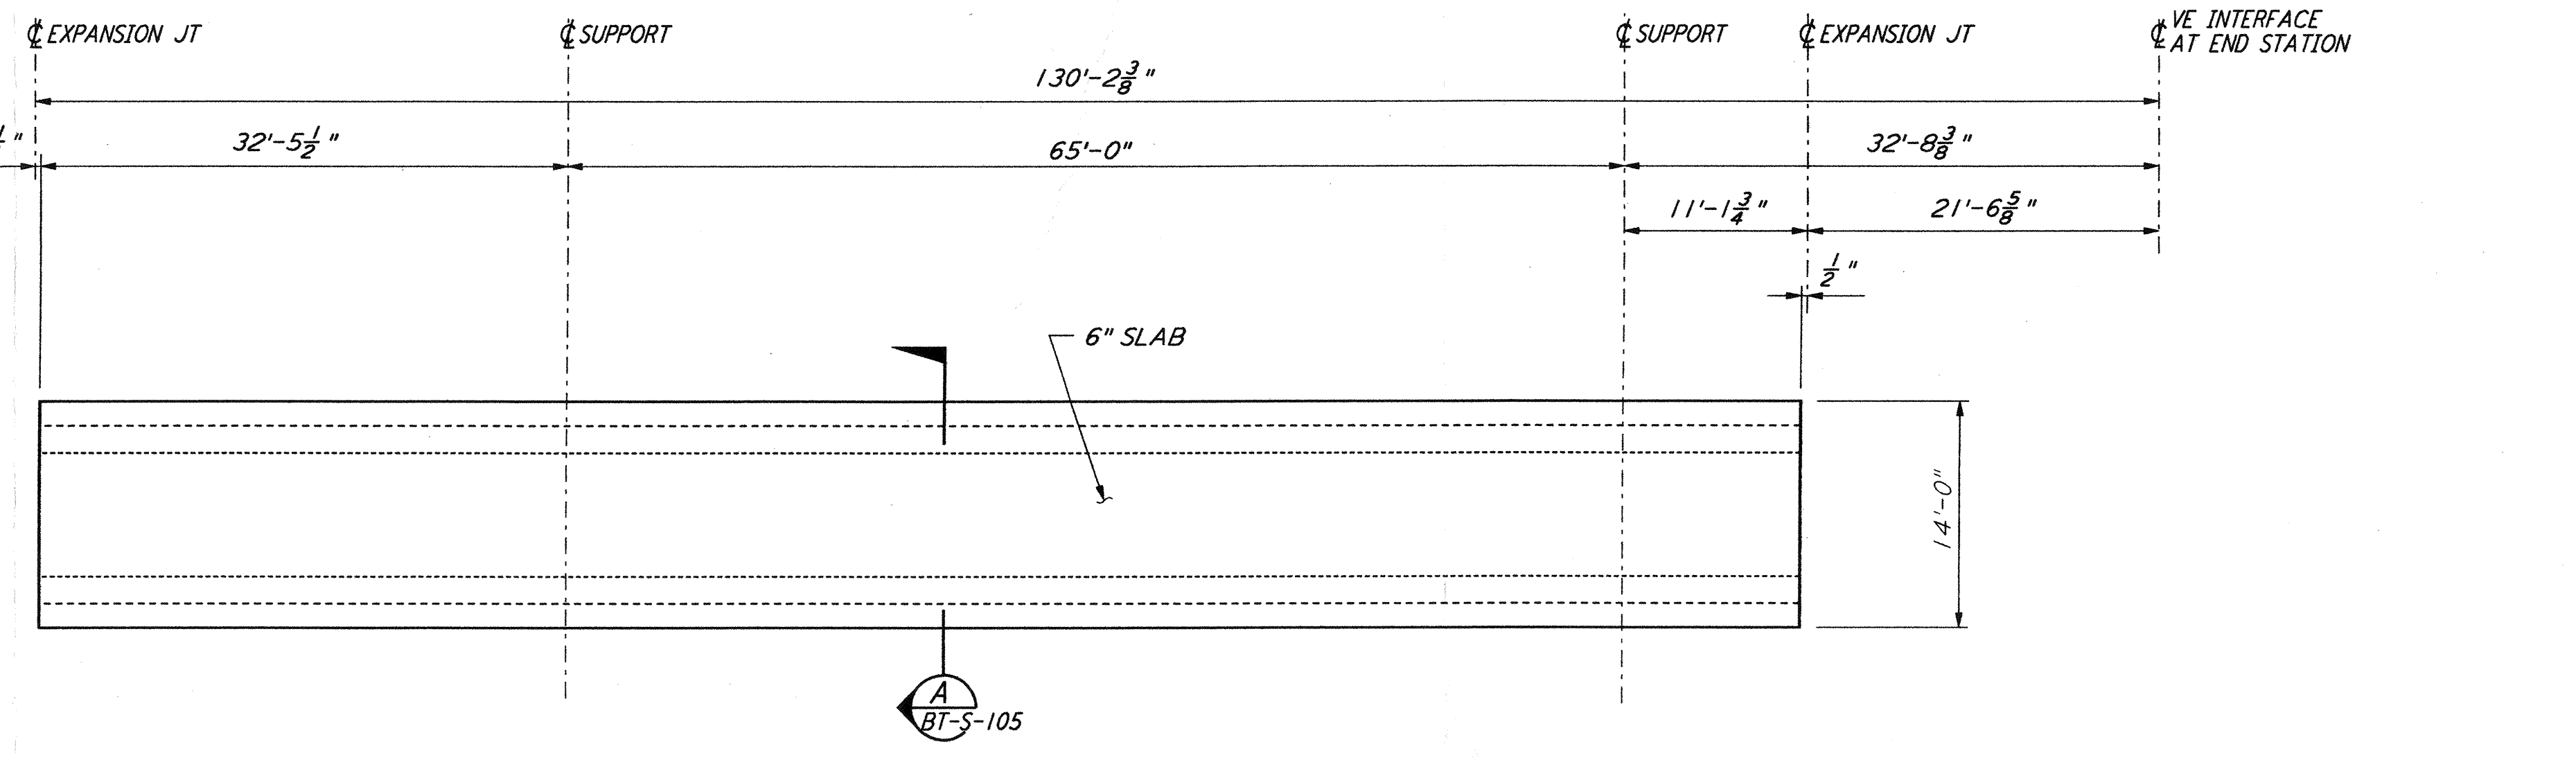


TYPICAL SLAB AT END STATION

DETAIL 4 REF  
 $\frac{1}{8}'' = 1'-0''$  BT-S-106 BT-S-104 BT-S-105

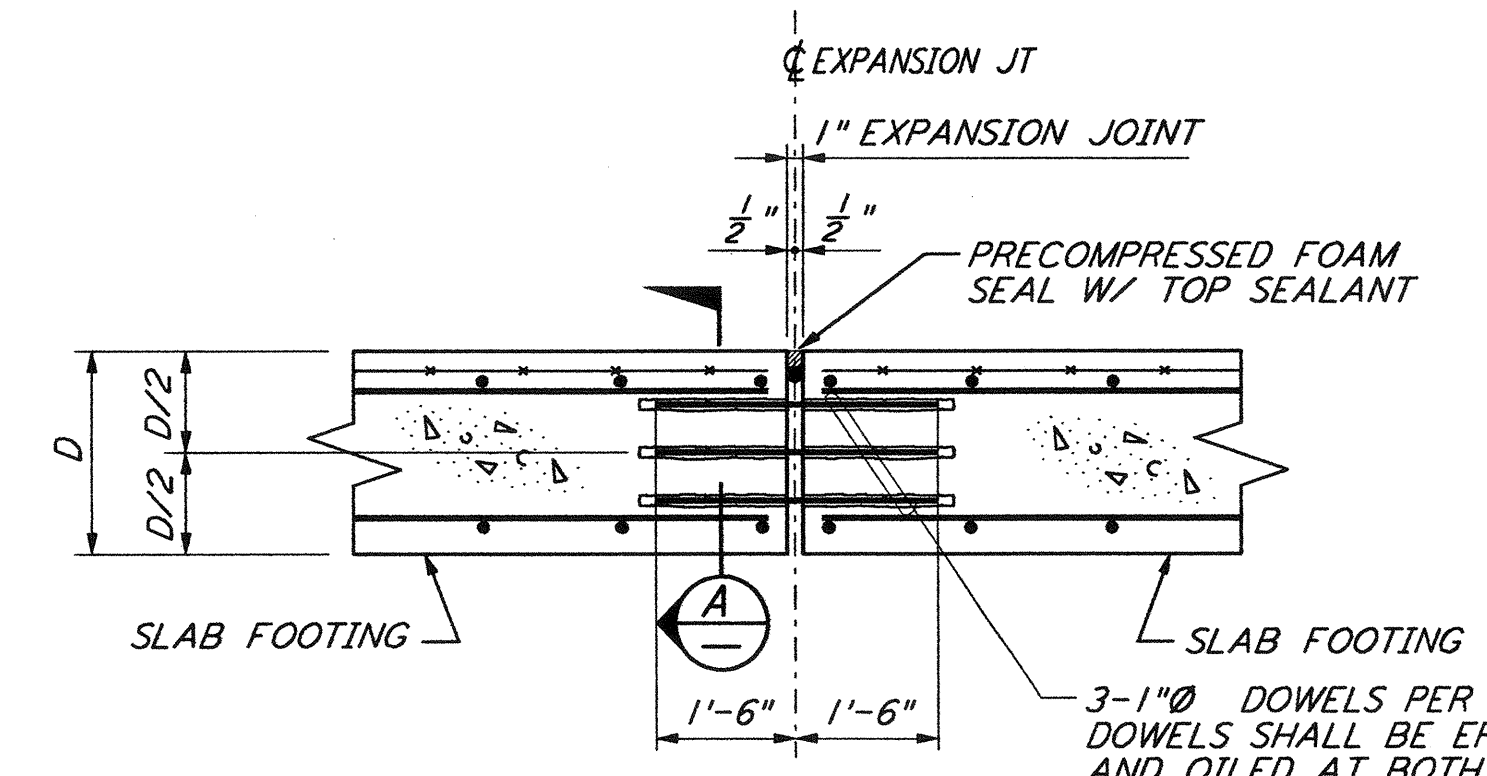


TYPICAL EXPANSION JOINT AT SLAB FOOTING

DETAIL 5 REF  
 $\frac{1}{2}'' = 1'-0''$  BT-S-106 BT-S-104

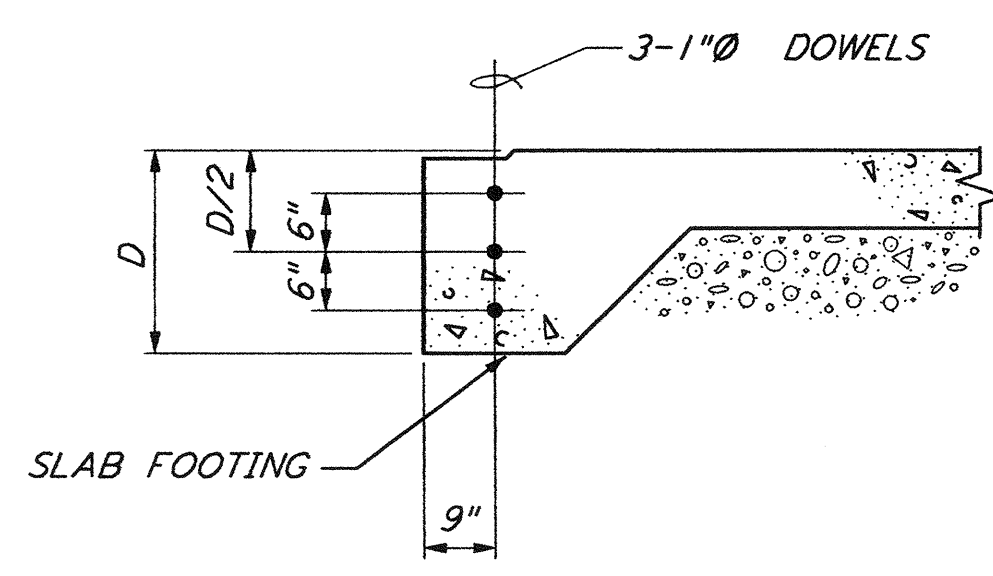


NOTE:  
 FOR INFORMATION NOT SHOWN SEE SECTION A-A BT-S-105

SECTION A REF  
 $\frac{1}{2}'' = 1'-0''$

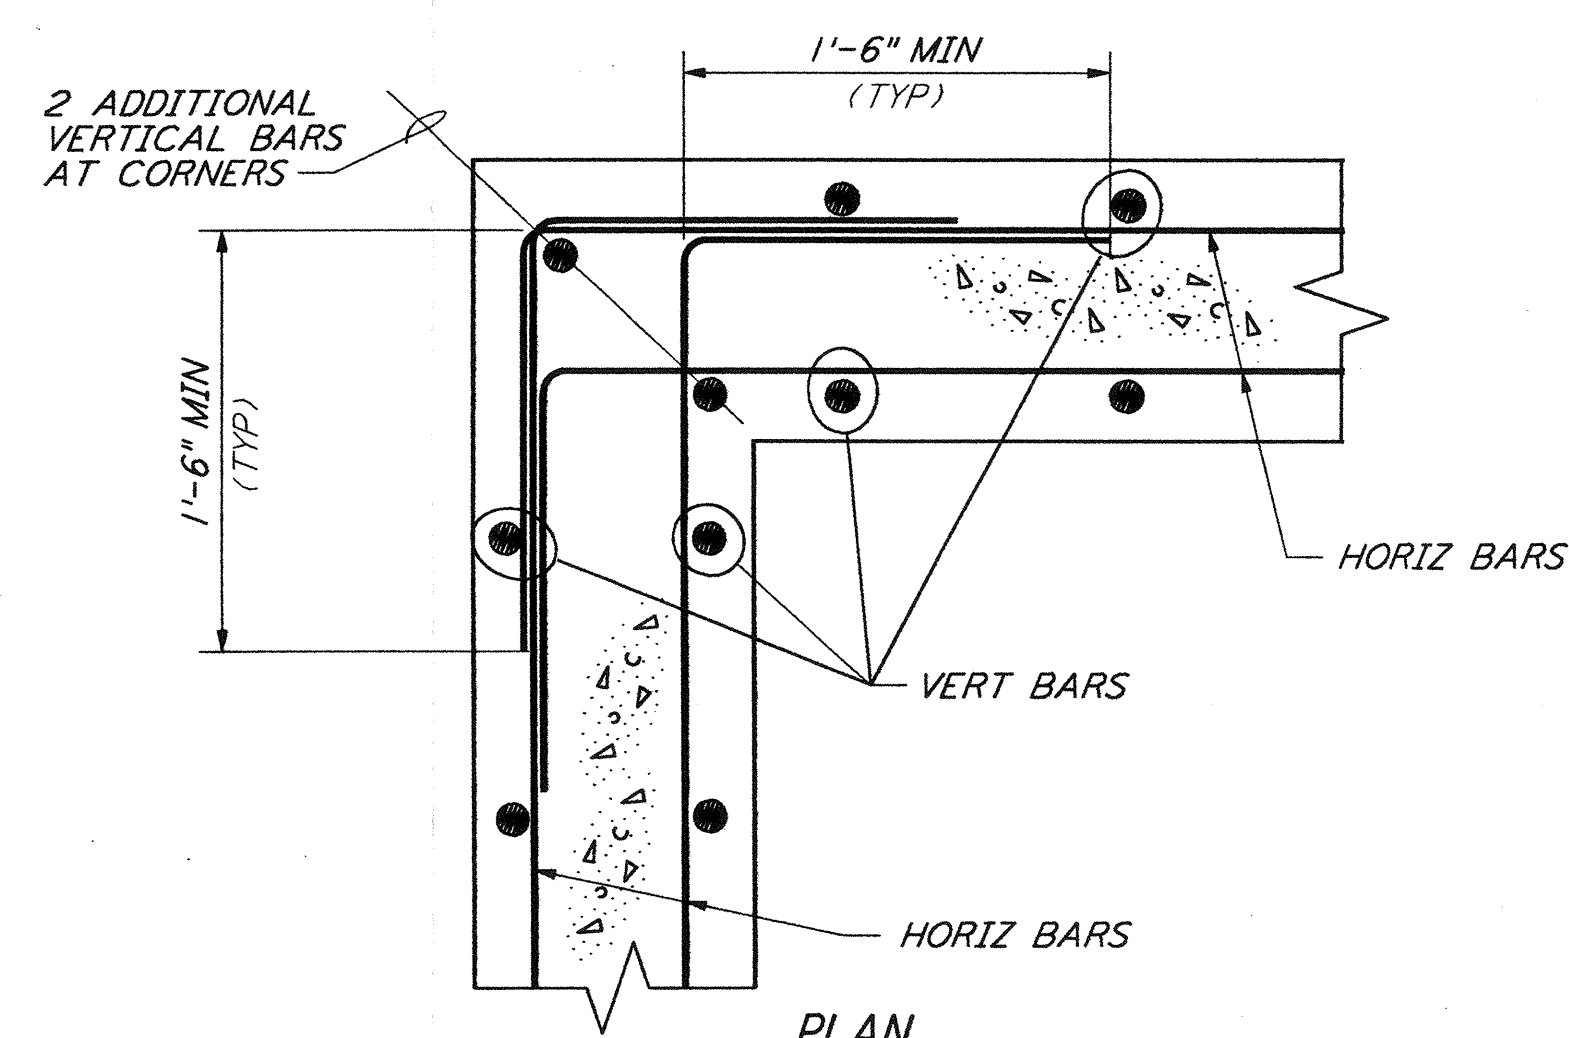

DETAIL 6 REF  
 $\frac{1}{2}'' = 1'-0''$  BT-S-106 BT-S-105

NOTE:  
 1. FOR GENERAL NOTES, ABBREVIATIONS AND LEGEND SEE DRAWING BT-S-101.

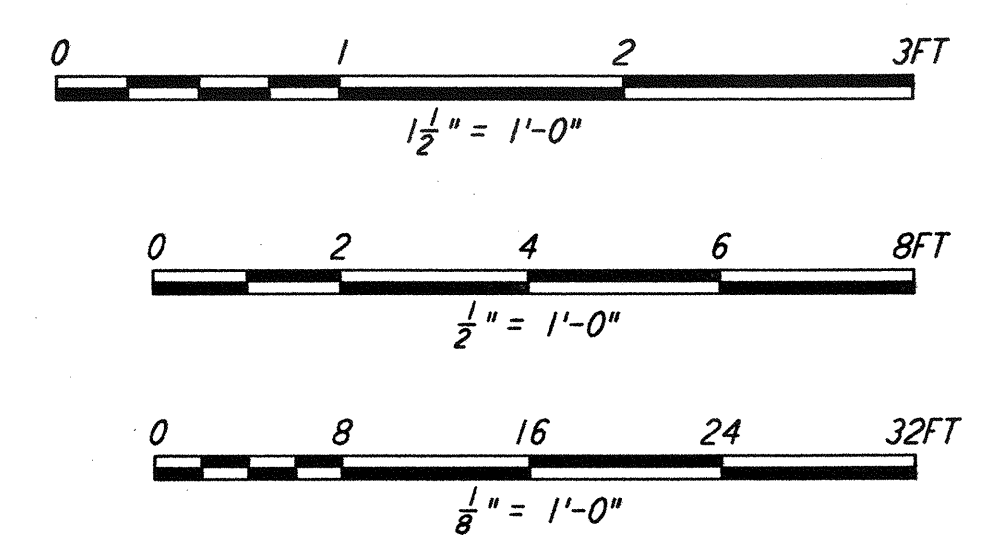

FOR REFERENCE ONLY

LIGO-D961583-00-0

NO.	DATE	BY	CHKD	ENGR	PROJ	DESCRIPTION
0	1-22-99	MEI	--	--	MDW	ISSUED FOR AS BUILT
A	5-10-96	MCS				ISSUED FOR BID

DRAWN	MCS
CHECKED	
ENGINEER	
PROJ	
<b>AS-BUILT DRAWINGS</b>	

**PARSONS**  
 100 WEST WALNUT STREET  
 PASADENA, CALIFORNIA

**LIGO**  
 CALIFORNIA INSTITUTE OF TECHNOLOGY  
 MASSACHUSETTS INSTITUTE OF TECHNOLOGY

LASER INTERFEROMETER  
 GRAVITATIONAL-WAVE OBSERVATORY  
 BTE INSTALLATION - HANFORD, WA

TITLE	STRUCTURAL BEAM TUBE ENCLOSURE SECTIONS & DETAILS SHEET 2	SHEET NUMBER	AS NOTED PPI50969	PROJECT NUMBER	8094
BT-S-106					