


REVISIONS			
REV.	DESCRIPTION	APPROVED	DATE
A	RELEASED	ZH	1-22-96
B	ADDED NOTES		
C	ITEM 2 WAS COTTER PIN; REMOVED HOLES IN ITEM 1	AJL	9-6-96
D	REDRAWN	AJL	11-4-96

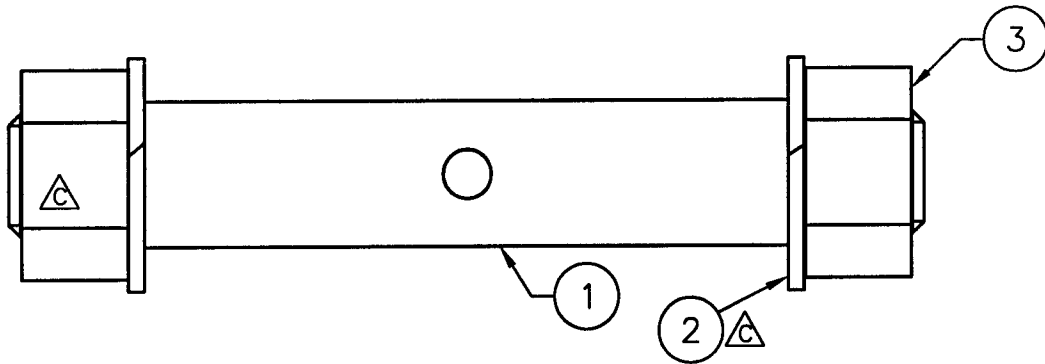

DEC 19 1996

DWG # V049-8-171

ITEM	QTY.	PART NO.	DESCRIPTION
3	2		SILVER PLATED SST HEX NUT, 5/8-11 UNC
2	2		SST 5/8" SPLIT LOCK WASHER
1	1	A103847	LINK PIN

PART LIST		MATERIAL SPECIFICATION: 304 SST		
UNLESS OTHERWISE SPECIFIED DIMENSIONS ARE IN INCHES TOLERANCES ARE: DECIMALS ANGLES FINISH .XX ± .01 ± 1° 32/ .XXX ± .005 UNSPECIFIED FILETS: R.015 BREAK EDGES .010 ± 45° REMOVE ALL BURRS THIRD ANGLE PROJECTION 	CONTRACT OR SALES ORDER NO.		GNB Corporation SCIENTIFIC AND INDUSTRIAL EQUIPMENT 30971 San Benito Ct. HAYWARD, CALIFORNIA 94544 (510) 441-1900 FAX: (510) 441-0939	
	APPROX. WT.			TITLE ASSEMBLY, LINK PIN G44, G48
	APPROVALS			
	DRAFTER	DATE		
CHECKER				
ENGINEER				
DO NOT SCALE DRAWING		A DWG. NO. 103235		
CADD FILE NAME		SCALE: NONE	SHEET 1 OF 1	

B103254
USED ON

A103235D

REV. D
A
DWG. NO. 103235