


NOTE:
 1. FOR GENERAL NOTES, ABBREVIATIONS AND LEGEND SEE DRAWING LA-S-501.

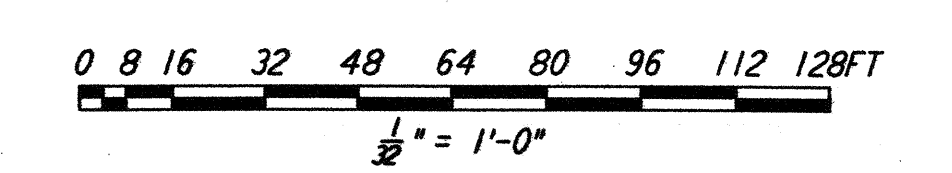

LIGO-D970101-01-O

NO.	DATE	BY	CHKD	ENGR	PROJ	DESCRIPTION
1	1-15-99	MEI	--	--	MDW	ISSUED FOR AS BUILT

ISSUED FOR CONSTRUCTION	
DRAWN	GGP 02-28-97
CHECKED	
ENGINEER	
PROJ	
AS-BUILT DRAWINGS	

PARSONS
 100 WEST WALNUT STREET
 PASADENA, CALIFORNIA

LIGO
 CALIFORNIA INSTITUTE OF TECHNOLOGY
 MASSACHUSETTS INSTITUTE OF TECHNOLOGY

LASER INTERFEROMETER
 GRAVITATIONAL-WAVE OBSERVATORY
 BEAM TUBE ENCLOSURE - LIVINGSTON, LA

TITLE	SCALE	CONTRACT NUMBER	PROJECT NUMBER
STRUCTURAL	AS NOTED	PP150969	8094
SOUTHEAST ARM BEAM TUBE ENCLOSURE FDN & PARTIAL ENLARGED PLANS	SHEET NUMBER	REVISIONS	
LA-S-504A			

This document and the design it covers are the property of PARSONS. They are loaned only with the borrower's expressed written agreement that they will not be reproduced, copied, loaned, exhibited, or used in any other way, except by written consent from PARSONS to the borrower.

The Jan 14 15:23:55 1999 C:\PLOT\QUE\53-19682.DWG 52085 K:\V3862\53-04eb.prf LIGOLF.BDR