


As built layout of OMC REFL QPD sled

05/08/2012 V. Frolov and C. Guido

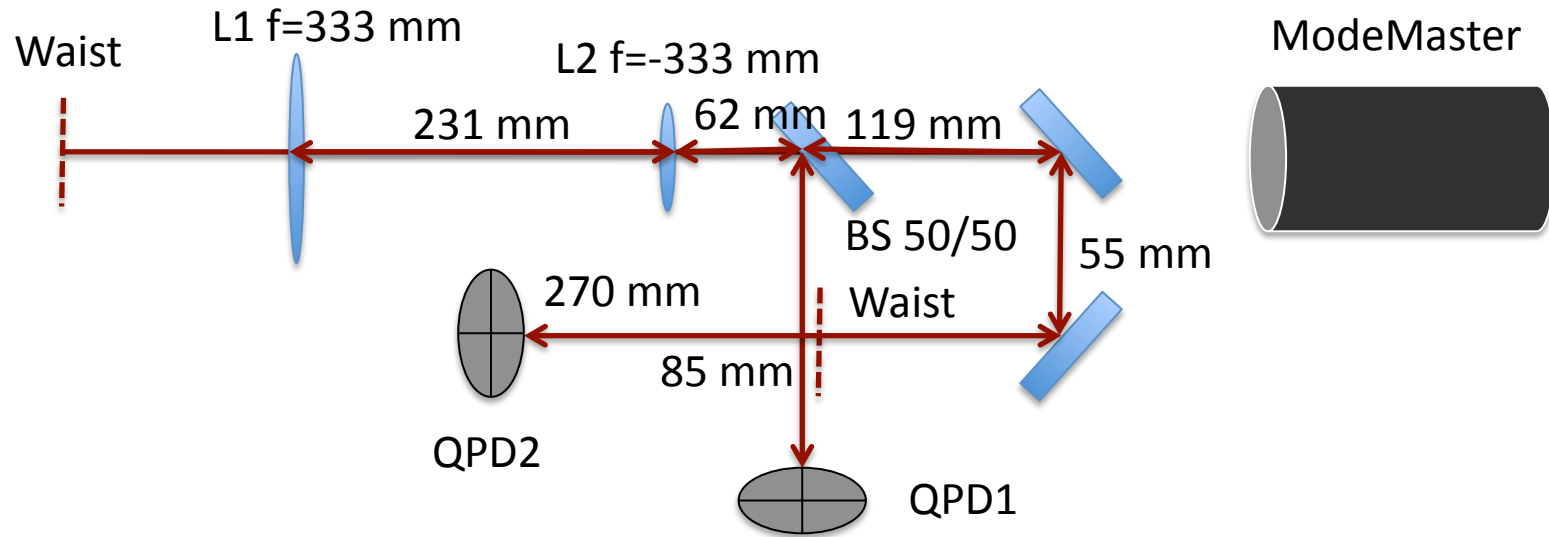

Input mode

| | Alignment laser setup (ModeMaster) | Nominal |
|---------------------|------------------------------------|---------|
| Z_o wrt to L1 (m) | -1.7 | -1.5 |
| w_o (mm) | 0.50 | 0.50 |
| Z_R (m) | 12.1 | 12.2 |
| M^2 | 0.99 | - |

Output mode

| | Alignment laser setup (ModeMaster) | Alignment (expected) |
|----------------------|------------------------------------|----------------------|
| Z_o wrt to L2 (mm) | 340 | 330 |
| w_o (mm) | 0.23 | 0.22 |
| Z_R (mm) | 170 | 163 |
| M^2 | 2.0 | - |