




SHP PC	MARK	ASSN PC	DESCRIPTION	LENGTH MM	SPEC	ID
9950	15-1		BAR SK X 5 (3/16)		M3	Ac
9874	15-1		BAR SK X 5 (3/16)		M3	Ac
			M3 = SEE SPEC C-VAC-1 (SA240-TP304L)			

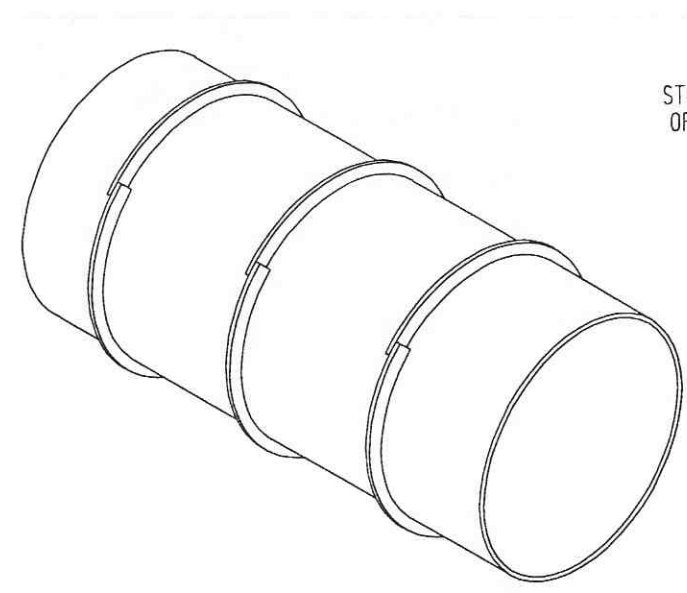


TYP STIFFENER LAYOUT
SEE SUB-ASSEMBLY DRAWING #4 FOR EXACT SPACING

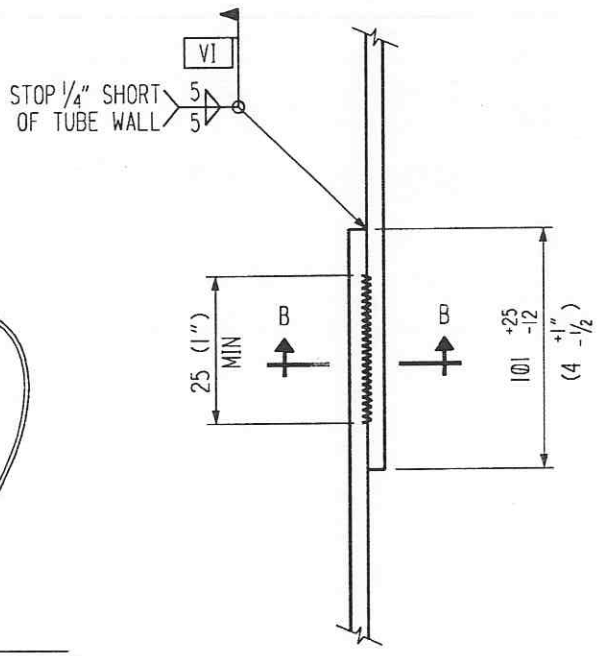


DETAIL - A
TYP LAP WELD

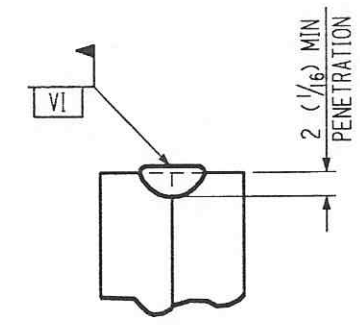

SECTION B-B

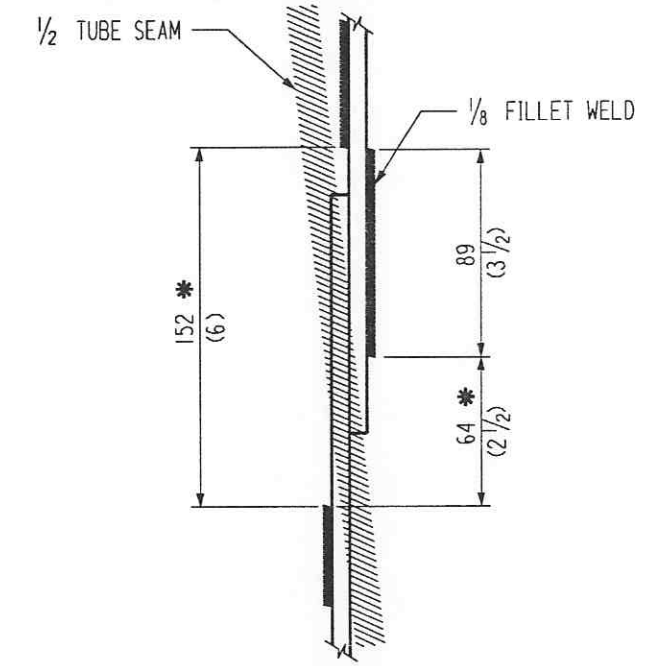


DETAIL - C
FILLET WELD GAP

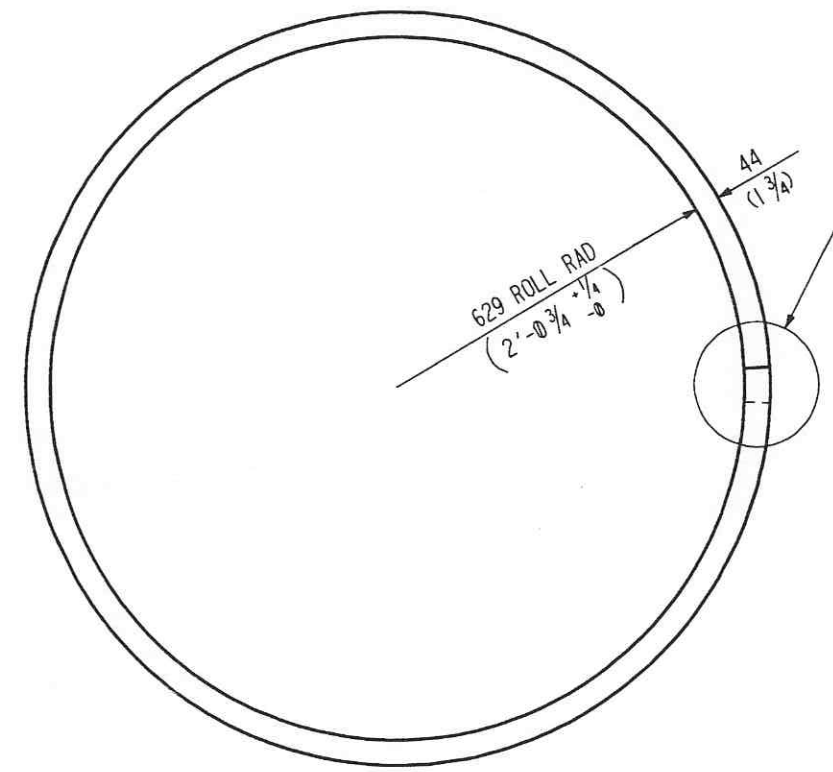

VACUUM STIFFENER 1

NOTE 4

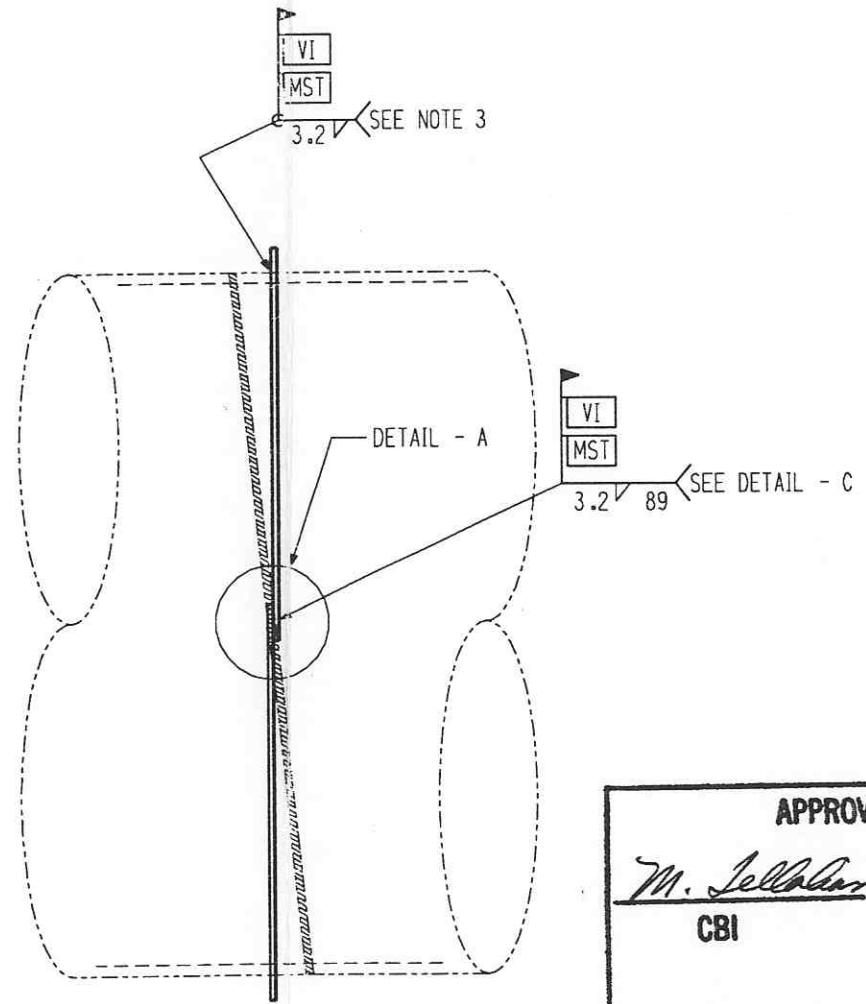

INDICATES CHANGE FROM PREVIOUS ISSUE

NOTES:

1. STIFFENERS TO BE A SINGLE CONTINUOUS PIECE FORMED BY ROLLING 3/16 X 1 3/4 FLATS; ONLY THE ENDS OF THE STIFFENER TO BE CUT EDGES.
 2. STIFFENERS ARE TO BE INSTALLED BY EXPANDING OVER THE TUBE AND RELEASING INTO PLACE WITH A TIGHT FIT AROUND THE TUBE.
 3. DISCONTINUE FILLET WELD WHERE STIFFENER CROSSES TUBE SPIRAL WELD. SEE DETAIL - C.
 4. ALLOW EXTRA LENGTH FOR FORMING SO THAT THE ENDS OF THE STIFFENERS ARE ROLLED TO 622 (2'-0 1/2 +1/4, -0) RADIUS. STIFFENERS NOT FORMED AT ENDS MAY BE REJECTED.
 5. WORK THIS DRAWING WITH DRAWING #4.
- * UNWELDED AREA MAY BE DECREASED BY LOCATING SPLICE CAREFULLY WITH LAP ON RIGHT SIDE.

APPROVED	
<i>M. Jellison</i>	6-28-96
CBI	DATE
CALTECH	DATE

REV. QUANTITY AND CONTRACT #		REVISIONS		REMARKS	
BY	DATE	BY	DATE		
CHKD	DATE	CHKD	DATE		
DATE	DATE	DATE	DATE		
SUPPLIER'S / PURCHASER'S NO CBI LIGO BEAM TUBE HANFORD, WA & LIVINGSTON, LA VACUUM STIFFENER DETAILS				CUSTOMER'S NO BY KJR CHKD DET DATE 3-14-94 M.J. TELLALIAN ENGINEERING ASSIGNED	
CONTRACT NO 953571				DWG 15 REV 4D SHT	
LIGO-D950040-04-B					

55710015.DGN