
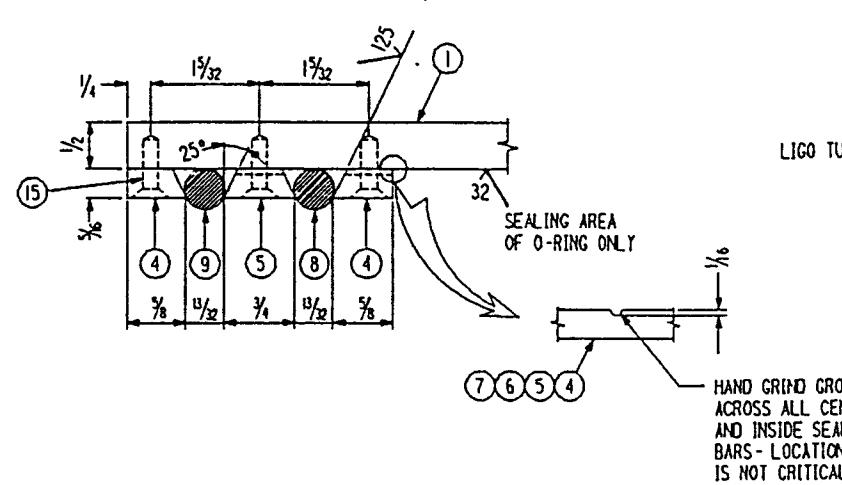


Date Rec'd	LIGO-D950079-04-B	TIME#	
Confidentiality	CONFIDENTIAL	Approved:	/ /
Date:		TDM:	

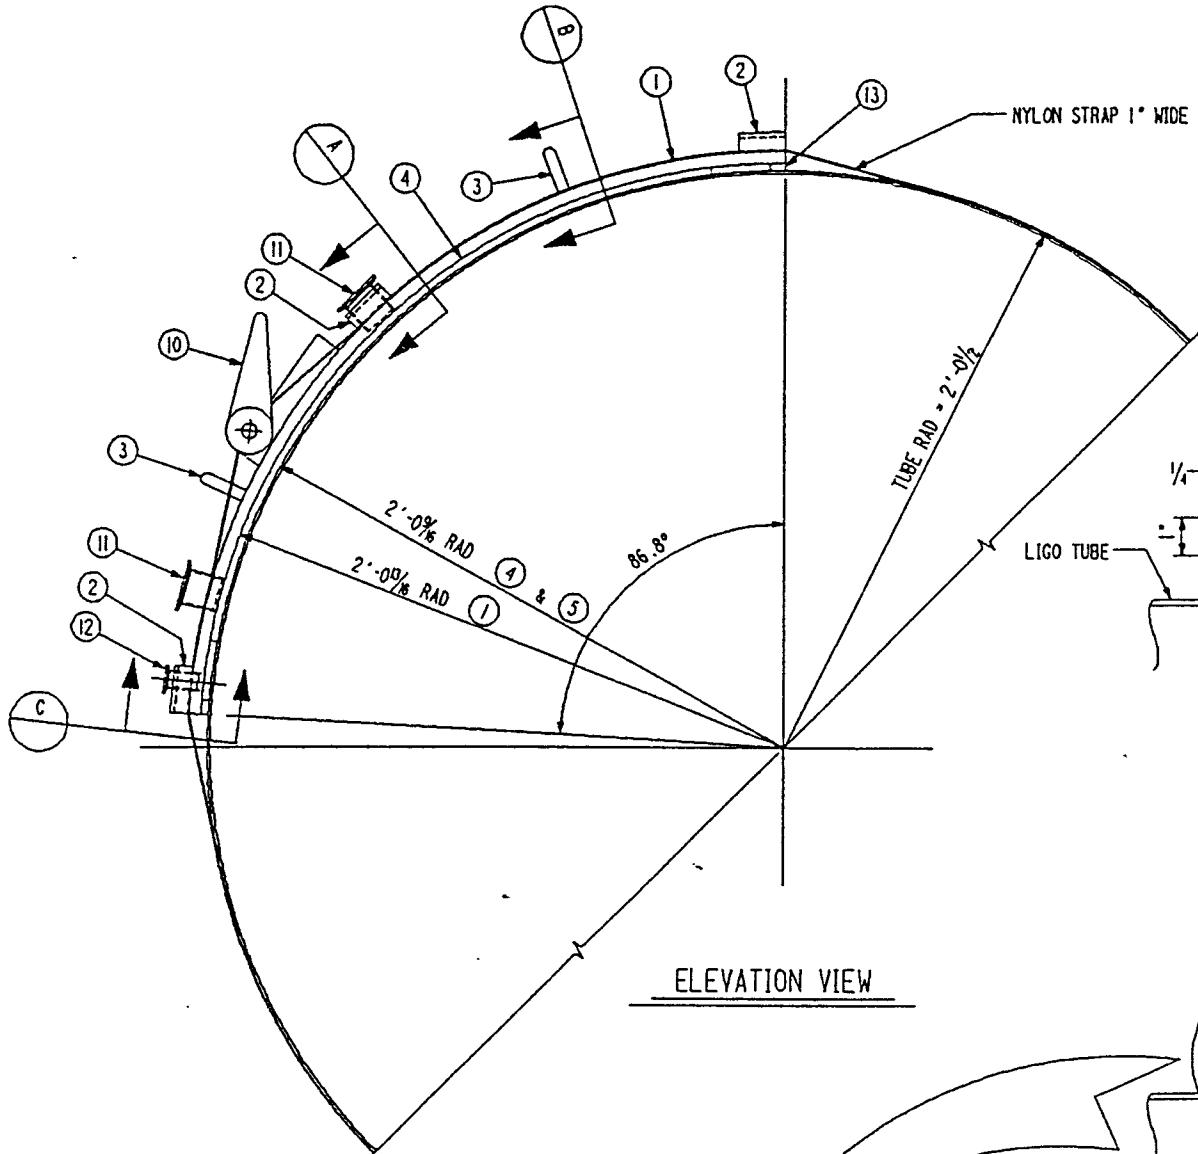

APPROVED

M. Tellalian
CBI





11/10/95

ROLLED EASY WAY

J. Jones
CBI

11/10/95

ROLLED EASY WAY

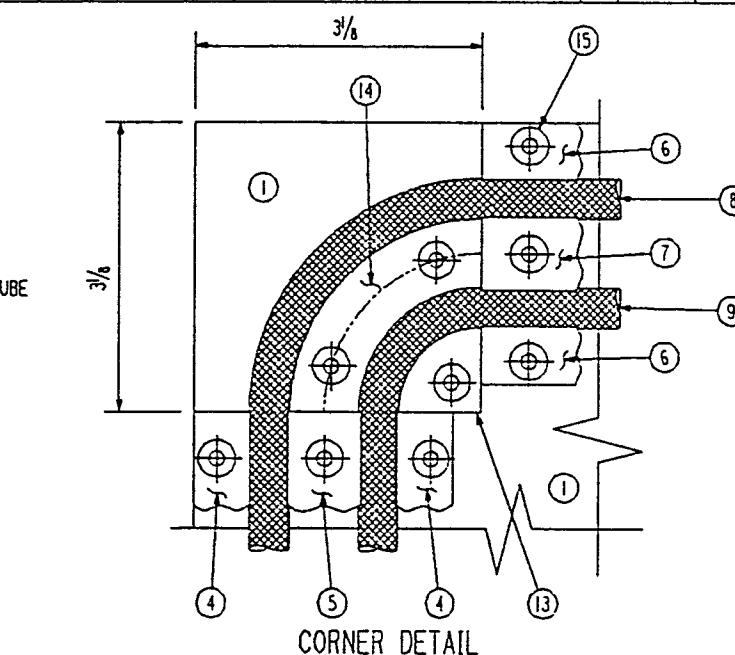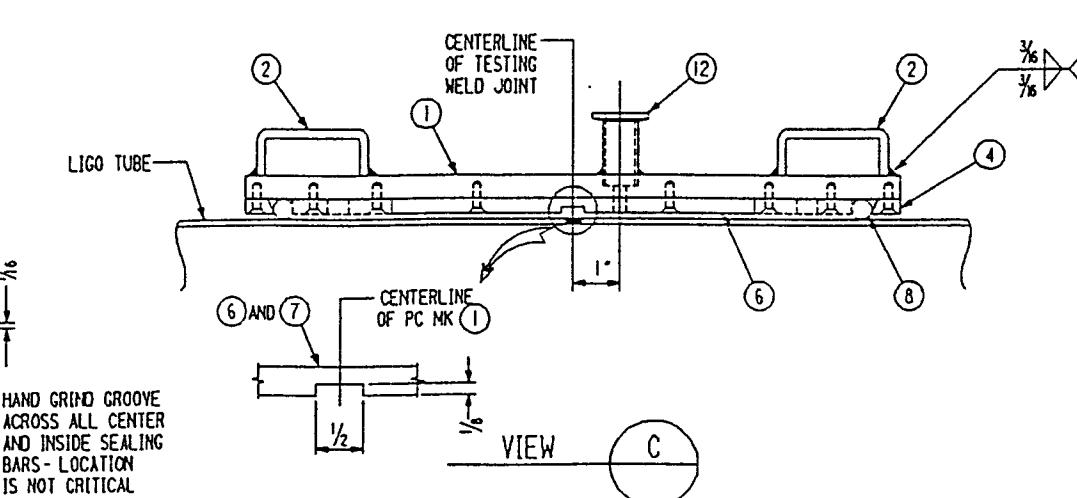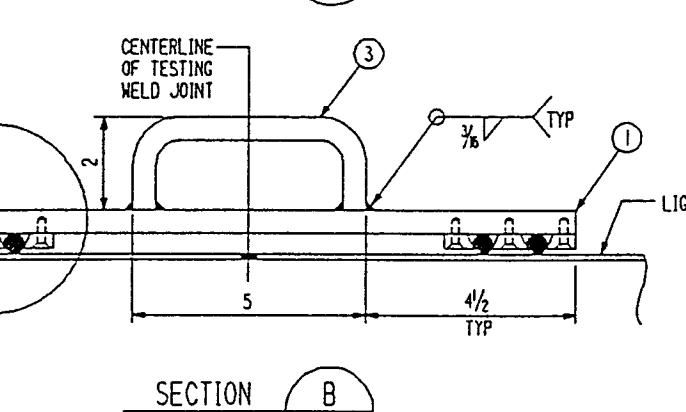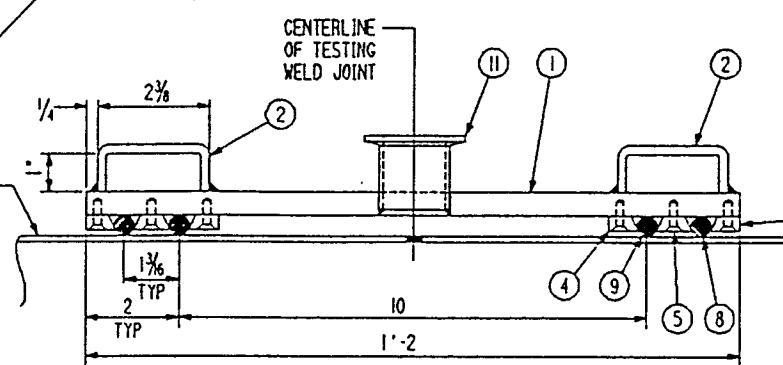

NOTES:

1. WORK THIS DWG WITH DWG ER-122 (FORMERLY ER-123).

Supplier's/Purchaser's No.	
CBI	
LIGO PROJECT	
CIRCUMFERENTIAL LEAK TEST BOX	
(FORMERLY ER-122)	
Customer's No. By RWP Chkd CWS Date 6-1-94 J. L. RINGELSTETTER Engineering Supervisor	Contract No. 930212ER Rev. 4
1-12-93 RWP CWS 6-1-94 B1 RWS 5-16-95 Revisions	1-12-93 RWP CWS 6-1-94 B1 RWS 5-16-95 Change Drawing Number Remarks

► INDICATES CHANGE FROM PREVIOUS ISSUE