

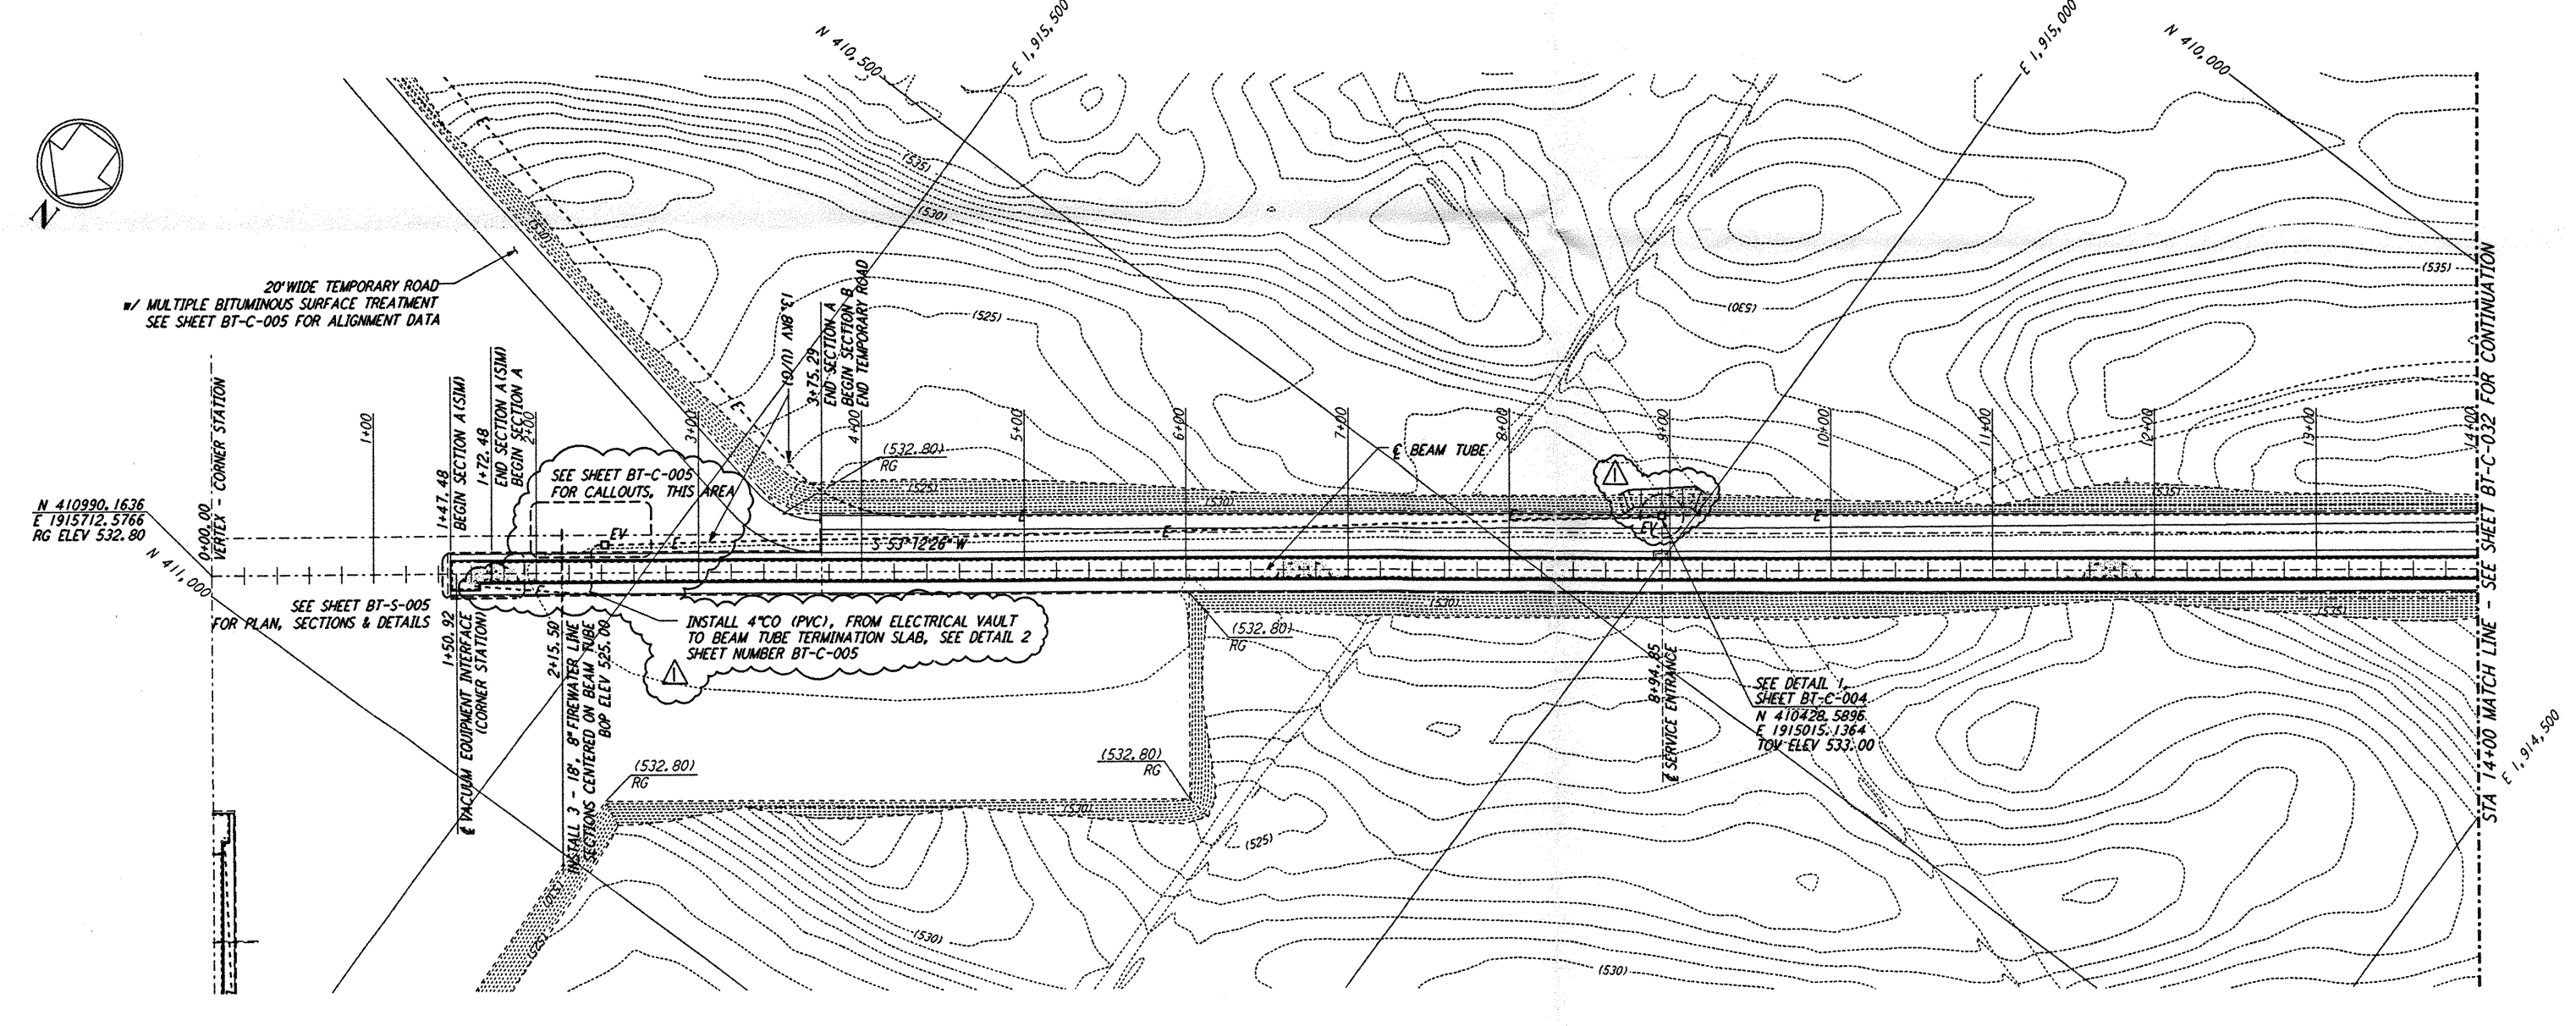


- NOTES:**
1. SEE SHEET BT-C-002 FOR GENERAL NOTES, LEGEND AND ABBREVIATIONS.
 2. SEE SHEET BT-C-004 FOR TYPICAL SECTIONS AND DETAILS.

PROFILE
 SCALES: HORIZ: 1" = 50'
 VERT: 1" = 5'

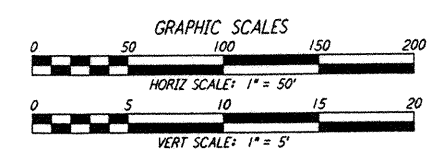

PLAN
 SCALE: 1" = 50'

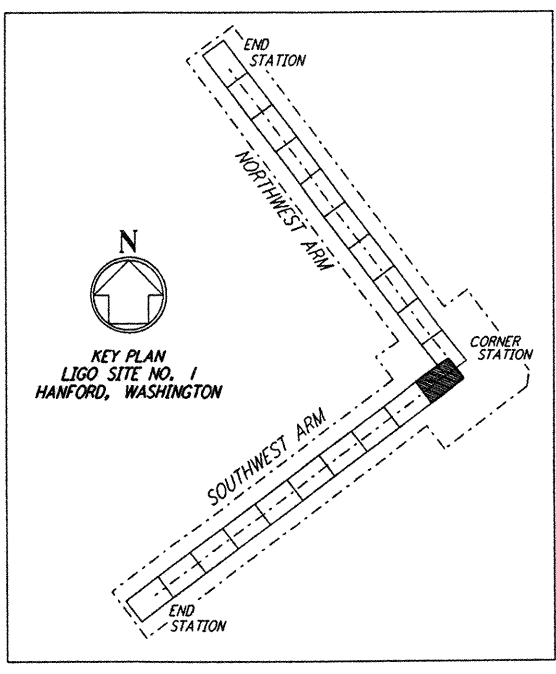




not be reproduced, copied, loaned, exhibited, or used in any other way, except by written consent from PARSONS to the borrower.

This document and the design it covers are the property of PARSONS. They are loaned only with the borrower's expressed written agreement that they will

NO.	DATE	BY	CHKD	ENGR	PROJ	DESCRIPTION
1	2-29-96	WRB				CHANGE ORDER NO. 2

ISSUED FOR CONSTRUCTION	DRAWN	CHECKED	ENGINEER	PROJ
	WRB	MP	JB	MDW

100 WEST WALNUT STREET PASADENA, CALIFORNIA
--

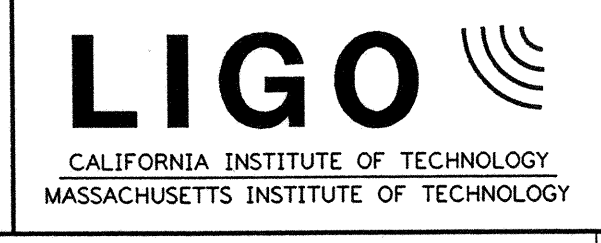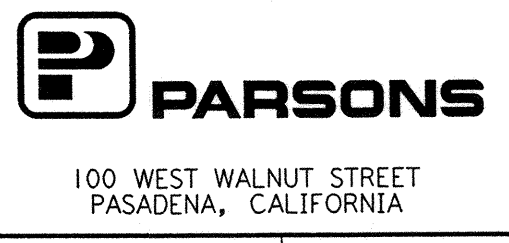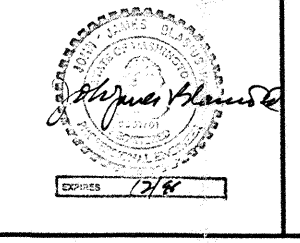

LASER INTERFEROMETER GRAVITATIONAL-WAVE OBSERVATORY BTE SITework & FABRICATION - HANFORD, WA			
TITLE	SCALE	PROJECT NUMBER	REVISIONS
CIVIL SOUTHWEST ARM PLAN AND PROFILE STA 0+00 TO STA 14+00	AS NOTED	PP150969	8094
SHEET NUMBER		BT-C-031	

LIGO D960176-01-D 1