This document and the design it covers are the property of PARSONS. They are loaned only with the borrower's expressed written agreement that they will not be reproduced, copied, loaned, exhibited, or used in any other way, except by written consent from PARSONS to the borrower.

Fri Sep 11 12:29:48 1998 c:\plot\wsf\S3-36.cpf N:\DUEJES\SITE2082\ST8005.PRF

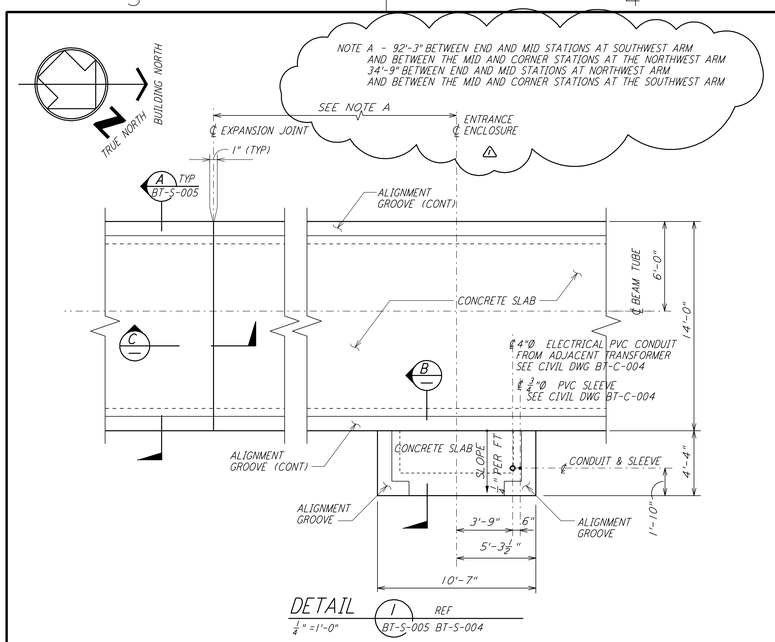

DETAIL 1 REF BT-S-005 BT-S-004
1/4" = 1'-0"

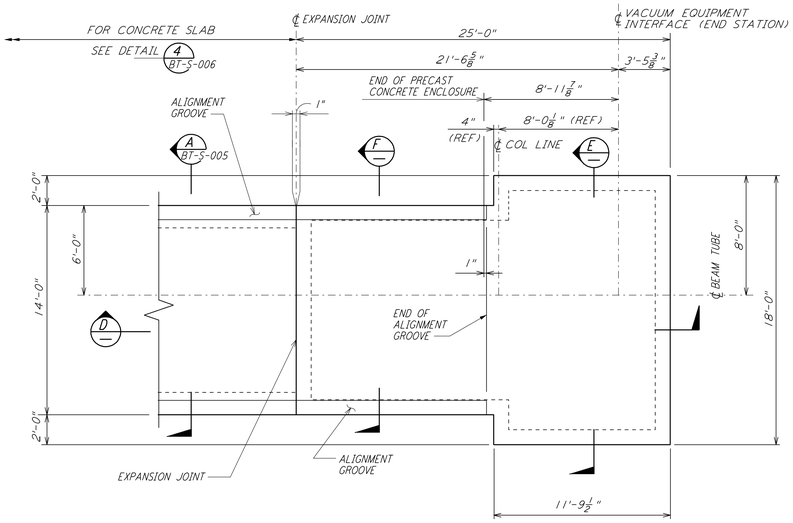

DETAIL 2 REF BT-S-005 BT-S-004
1/4" = 1'-0"

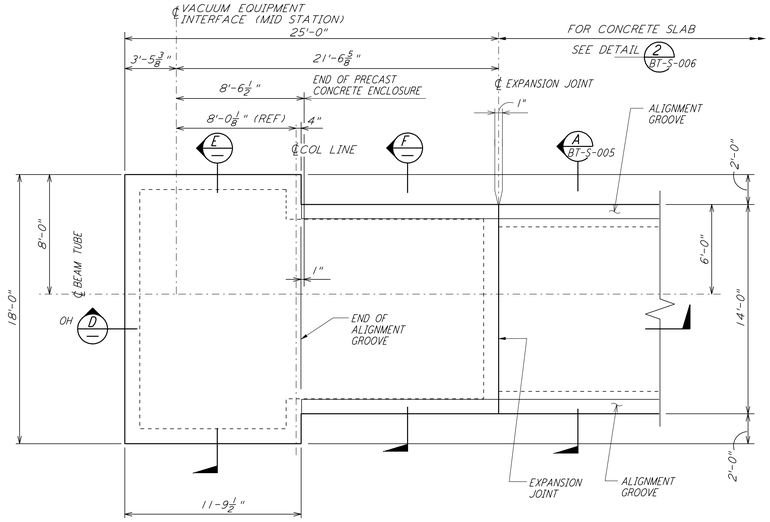

DETAIL 3 REF BT-S-005 BT-S-004
1/4" = 1'-0"

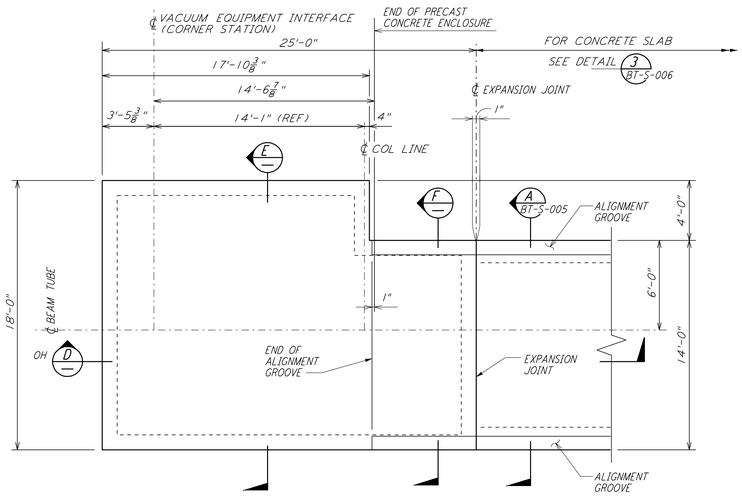

DETAIL 4 REF BT-S-005 BT-S-004
1/4" = 1'-0"

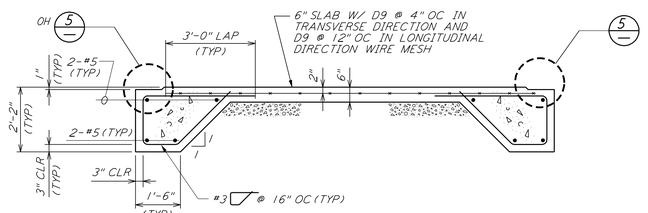

TYPICAL BEAM TUBE ENCLOSURE SLAB

SECTION A REF BT-S-005 BT-S-006
1/2" = 1'-0"

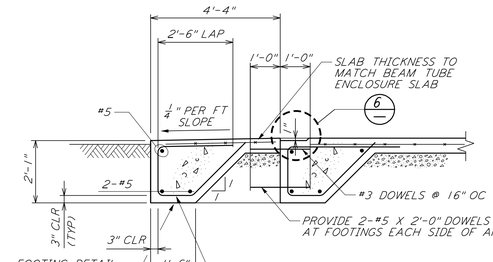

SECTION B
1/2" = 1'-0"

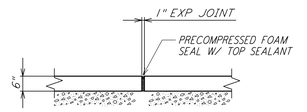

SECTION C
1/2" = 1'-0"

NOTE:
1. FOR GENERAL NOTES, ABBREVIATIONS AND LEGEND SEE DRAWING BT-S-001.

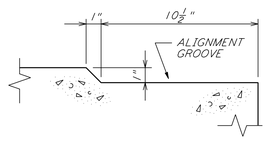

DETAIL 5 REF BT-S-005 BT-S-006
3" = 1'-0"

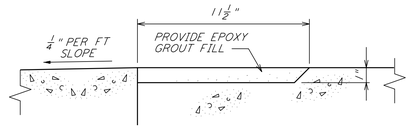

DETAIL 6
3" = 1'-0"

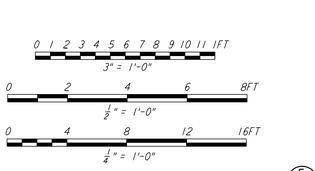

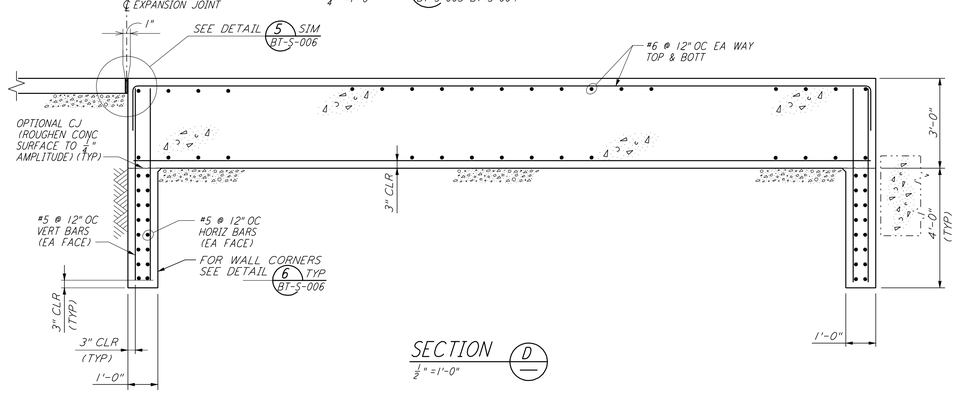

SECTION D
1/2" = 1'-0"

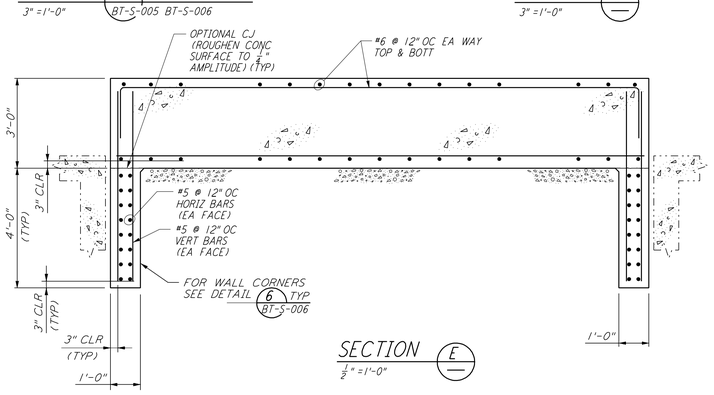

SECTION E
1/2" = 1'-0"

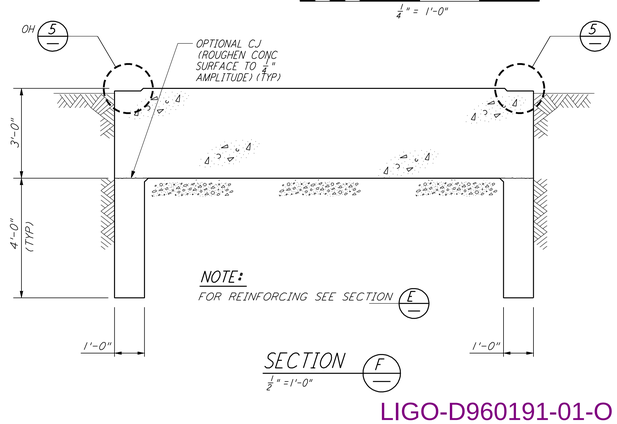

NOTE:
FOR REINFORCING SEE SECTION E

SECTION F
1/2" = 1'-0"

LIGO-D960191-01-O

REFERENCES		REVISIONS						
DRAWING NO.	DESCRIPTION	NO.	DATE	BY	CHKD	ENGR	PROJ	DESCRIPTION
		1	3-25-96	TM	BP	TM		CHANGE ORDER #3

ISSUED FOR CONSTRUCTION		
DRAWN	SH	1-19-96
CHECKED	RM	1-19-96
ENGINEER	FD	1-19-96
PROJ	MW	1-19-96

PARSONS
100 WEST WALNUT STREET
PASADENA, CALIFORNIA

LIGO
CALIFORNIA INSTITUTE OF TECHNOLOGY
MASSACHUSETTS INSTITUTE OF TECHNOLOGY

LASER INTERFEROMETER GRAVITATIONAL-WAVE OBSERVATORY
BTE SITEWORK & FABRICATION - HANFORD, WA

TITLE: STRUCTURAL BEAM TUBE ENCLOSURE SECTIONS & DETAILS SHEET 1

SCALE	CONTRACT NUMBER	PROJECT NUMBER
AS NOTED	PP150969	8094

SHEET NUMBER: BT-S-005
REVISIONS: 1

LIGOBTF.BDR