
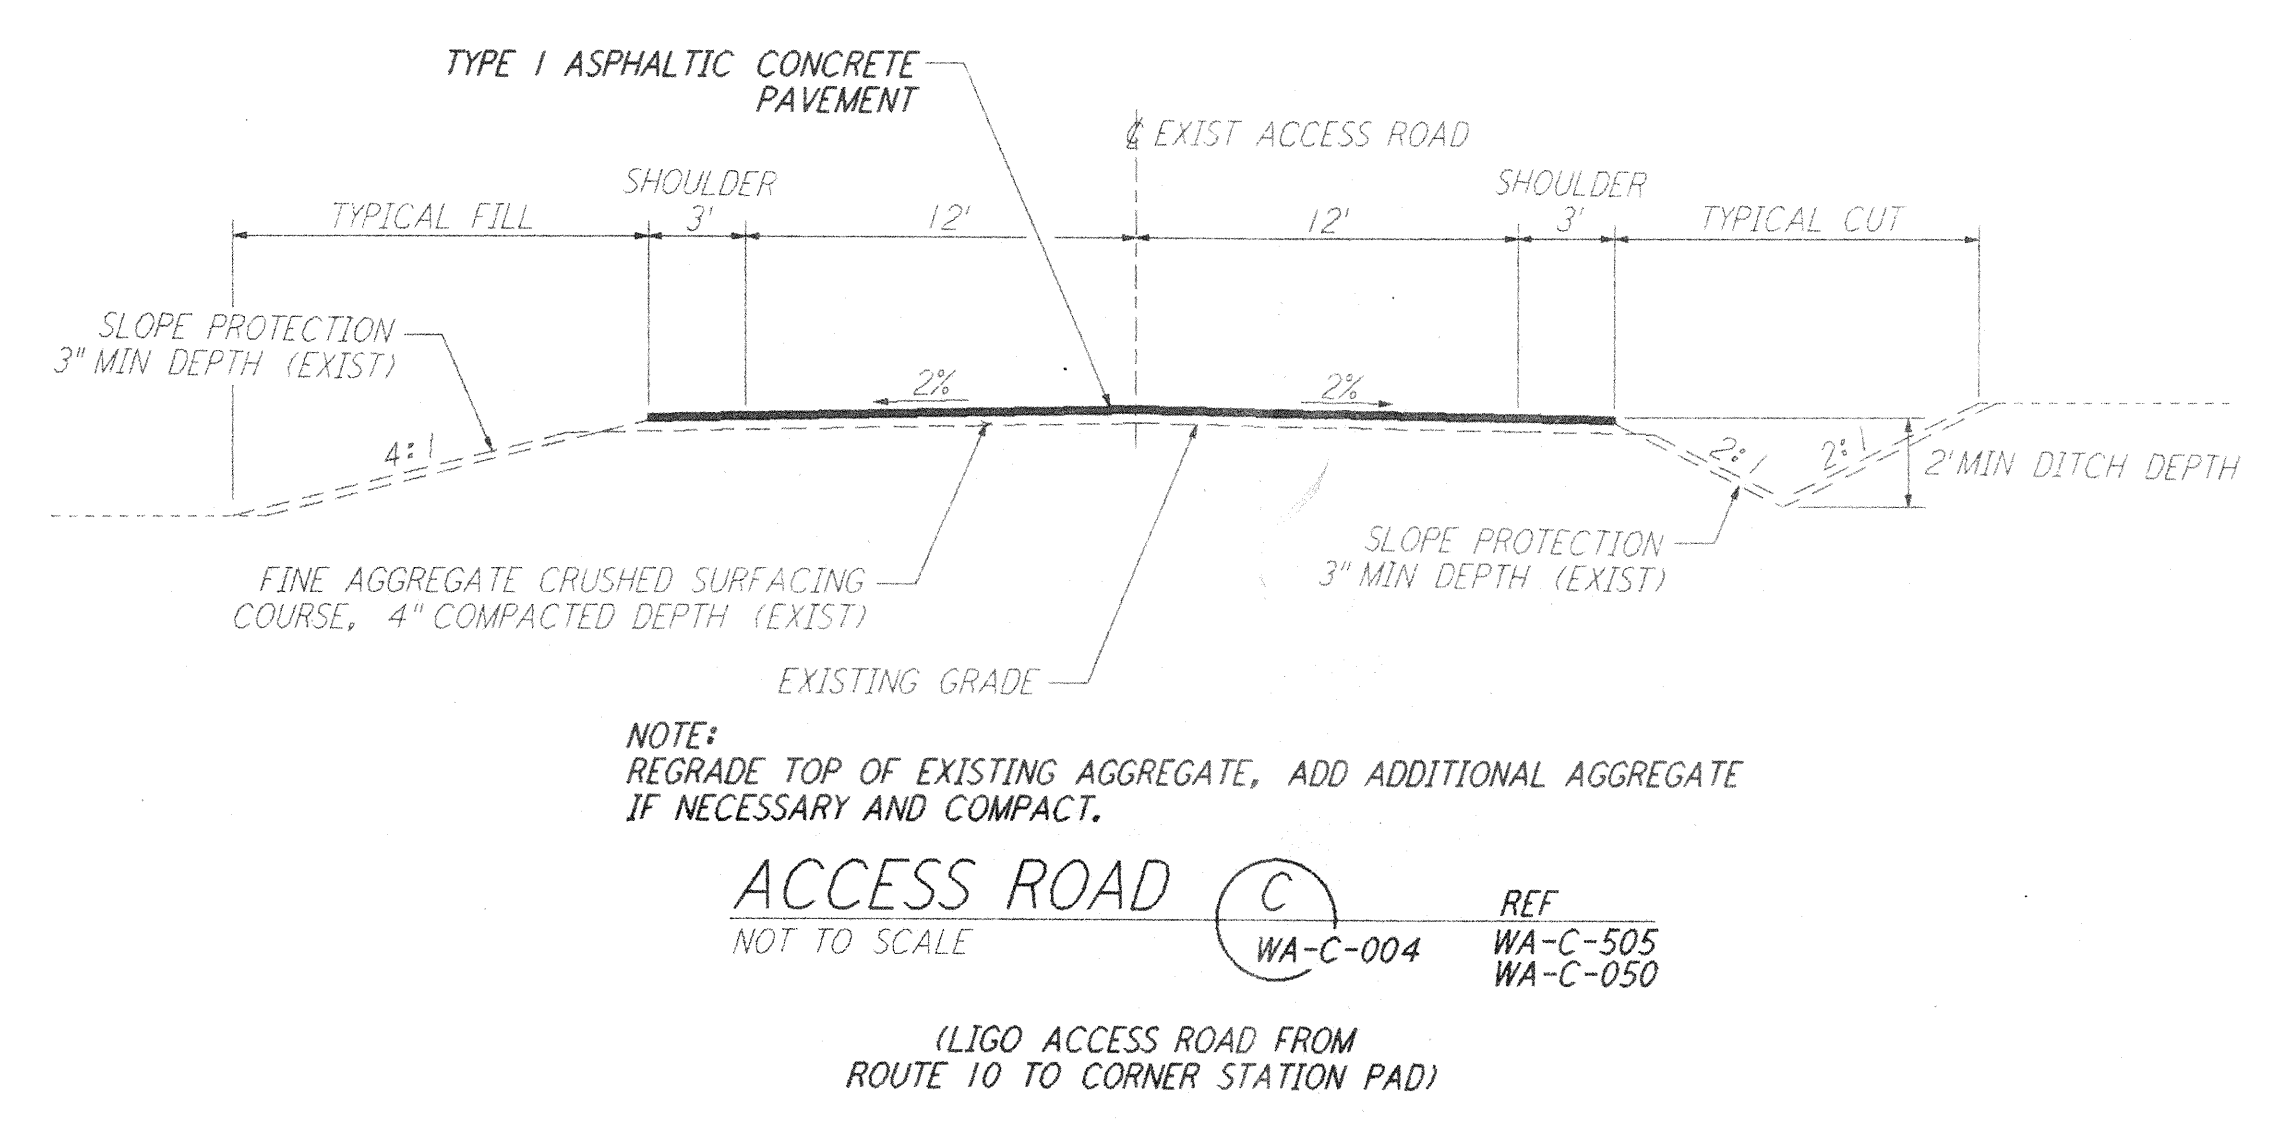
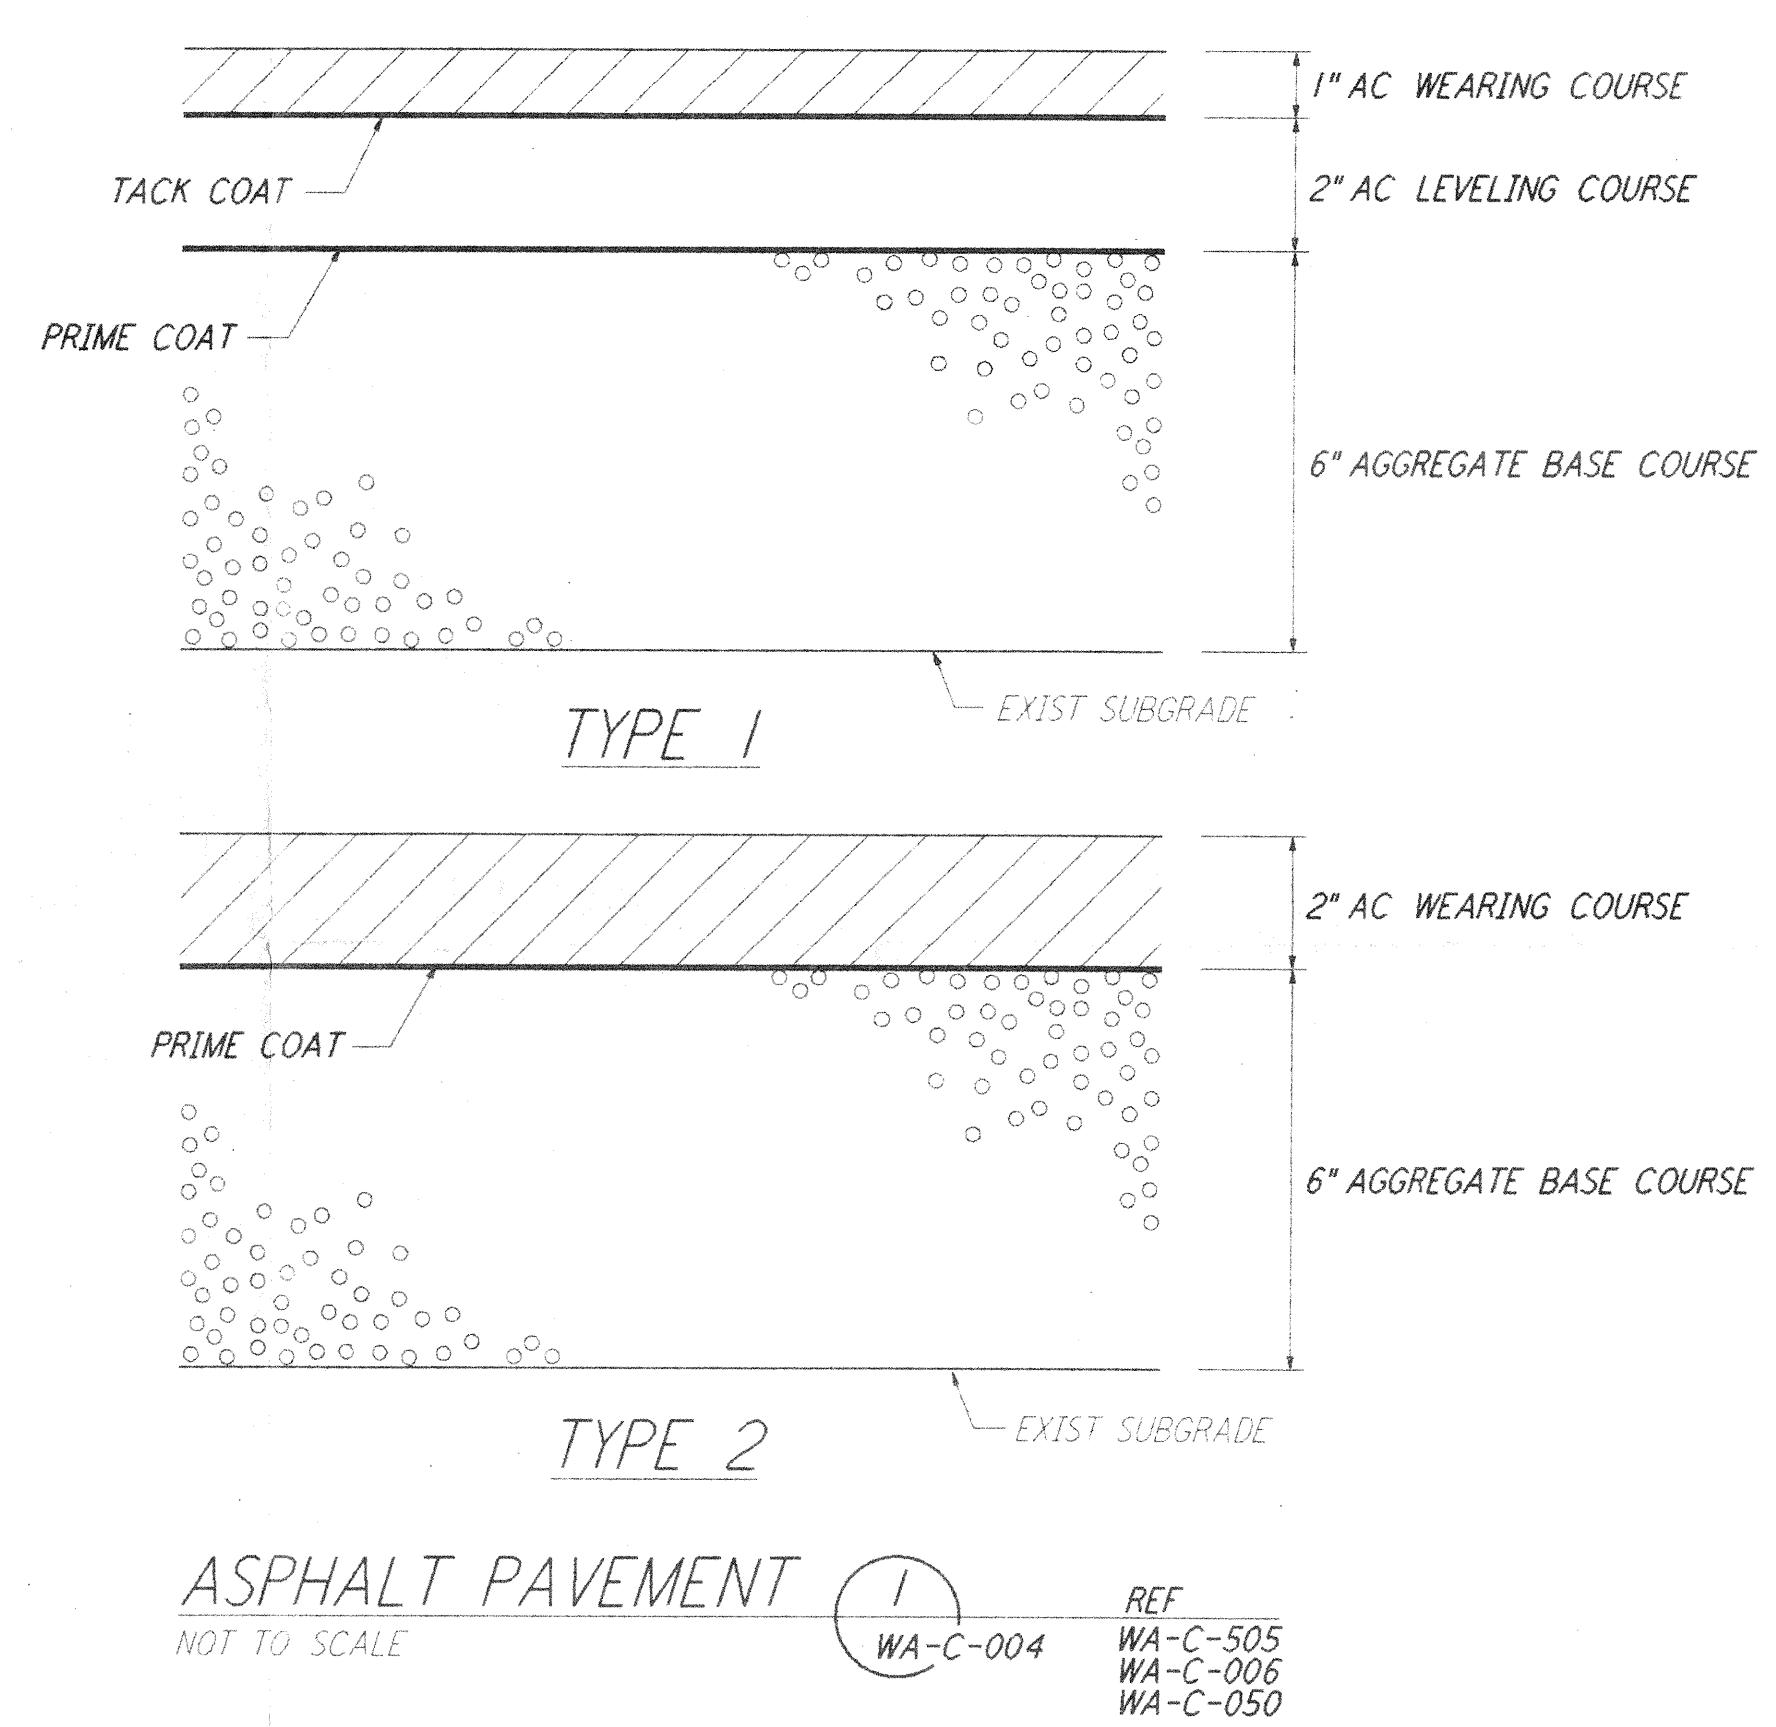
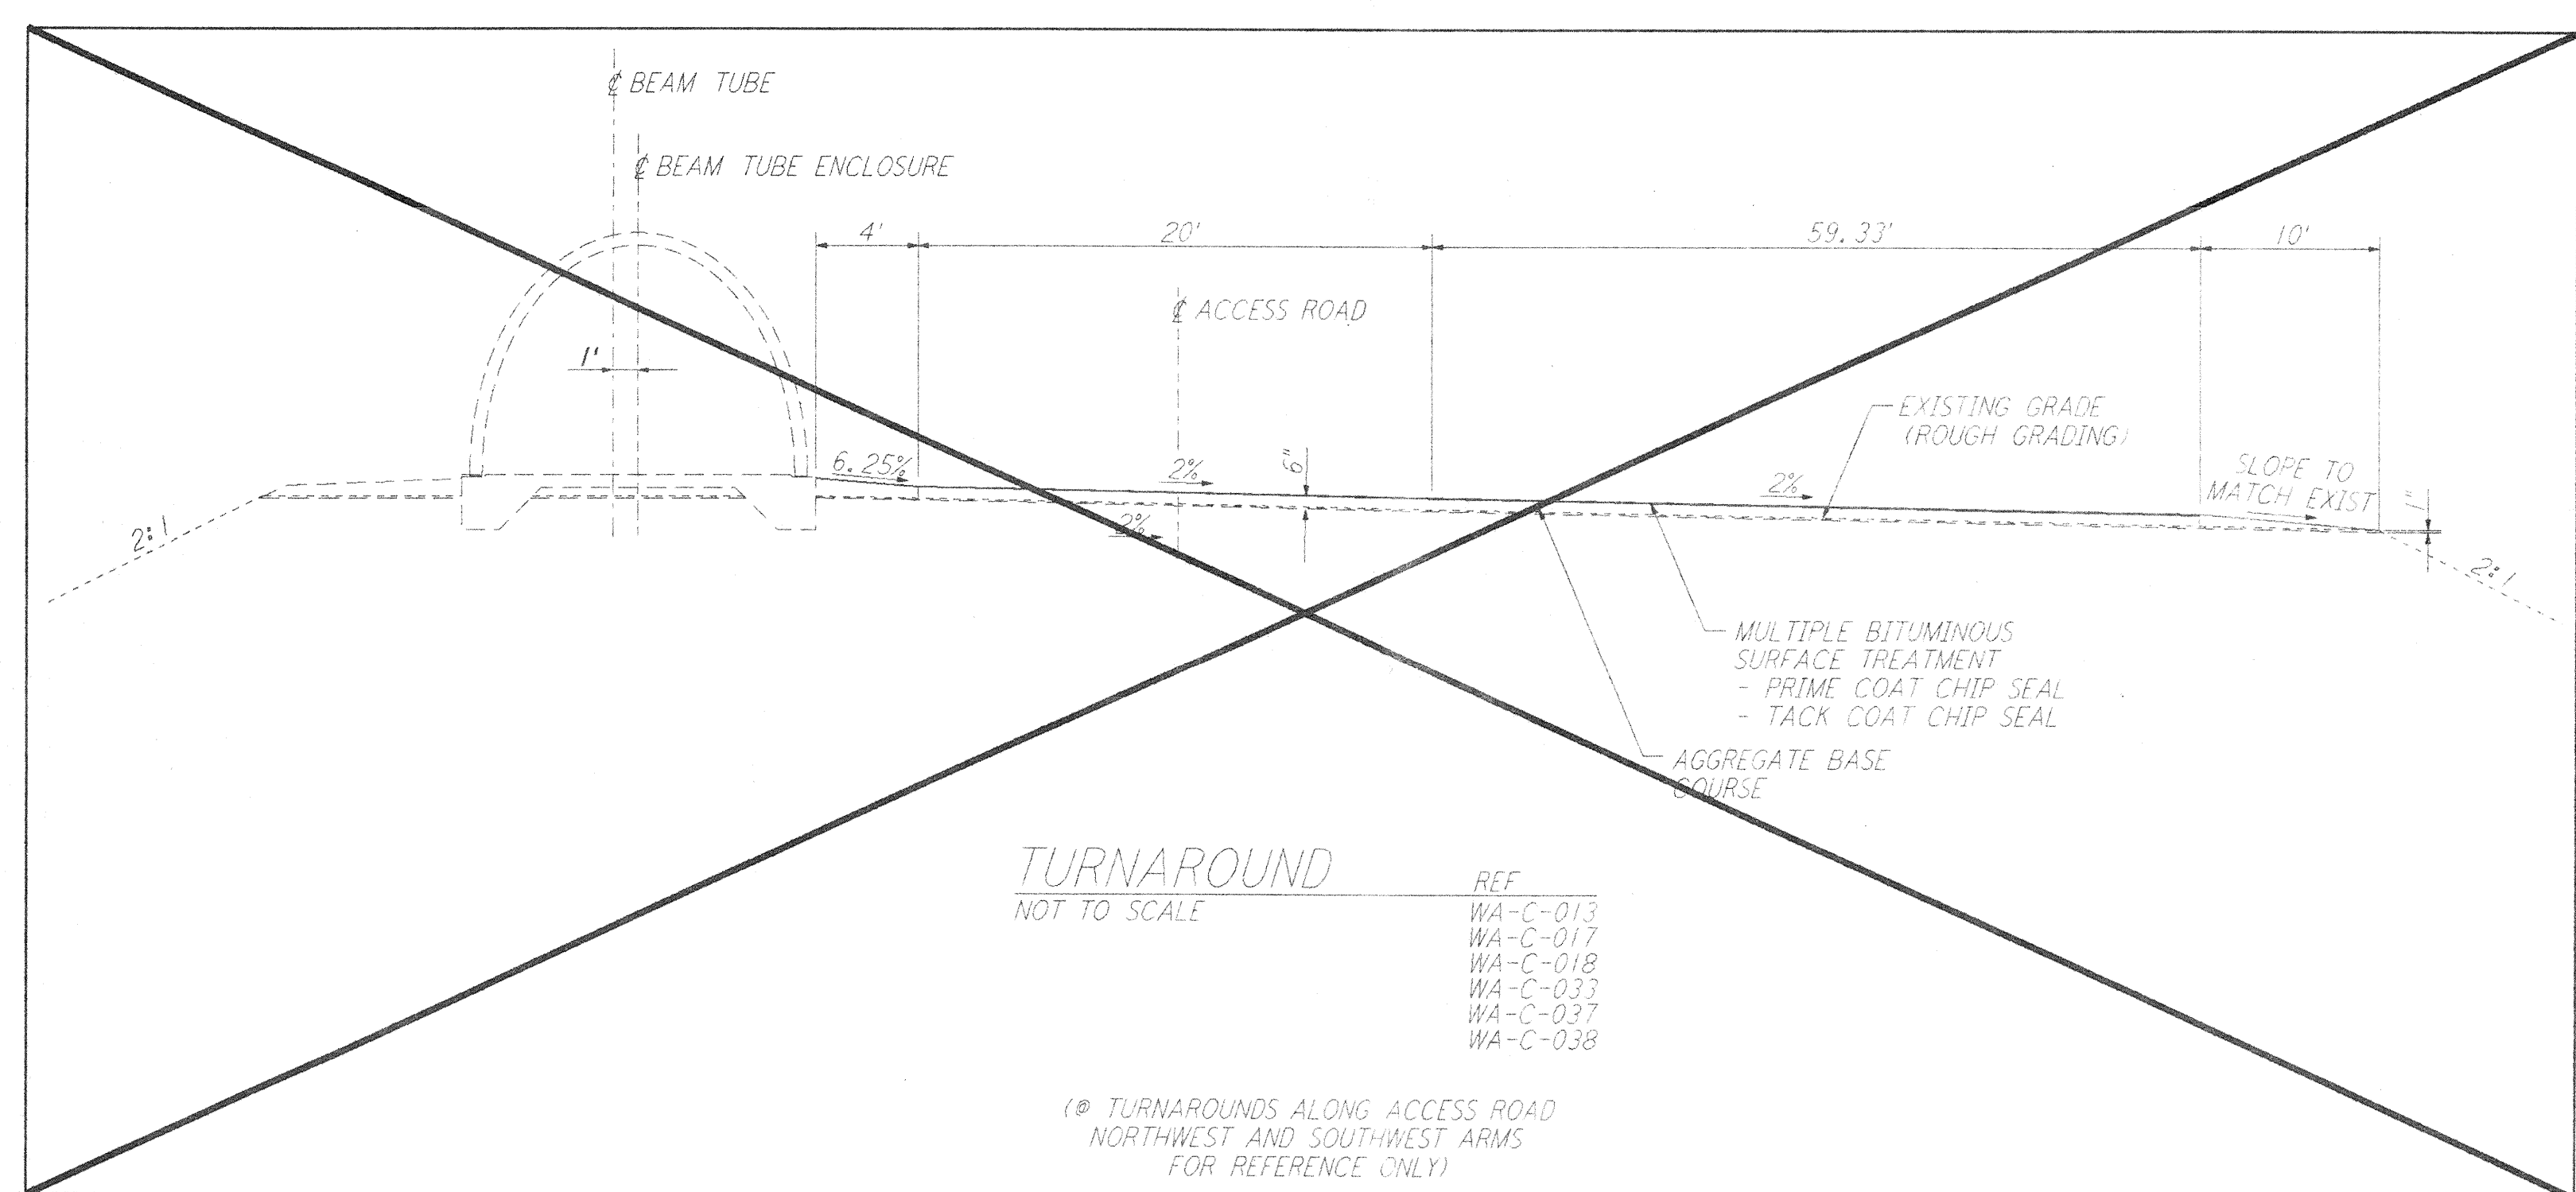
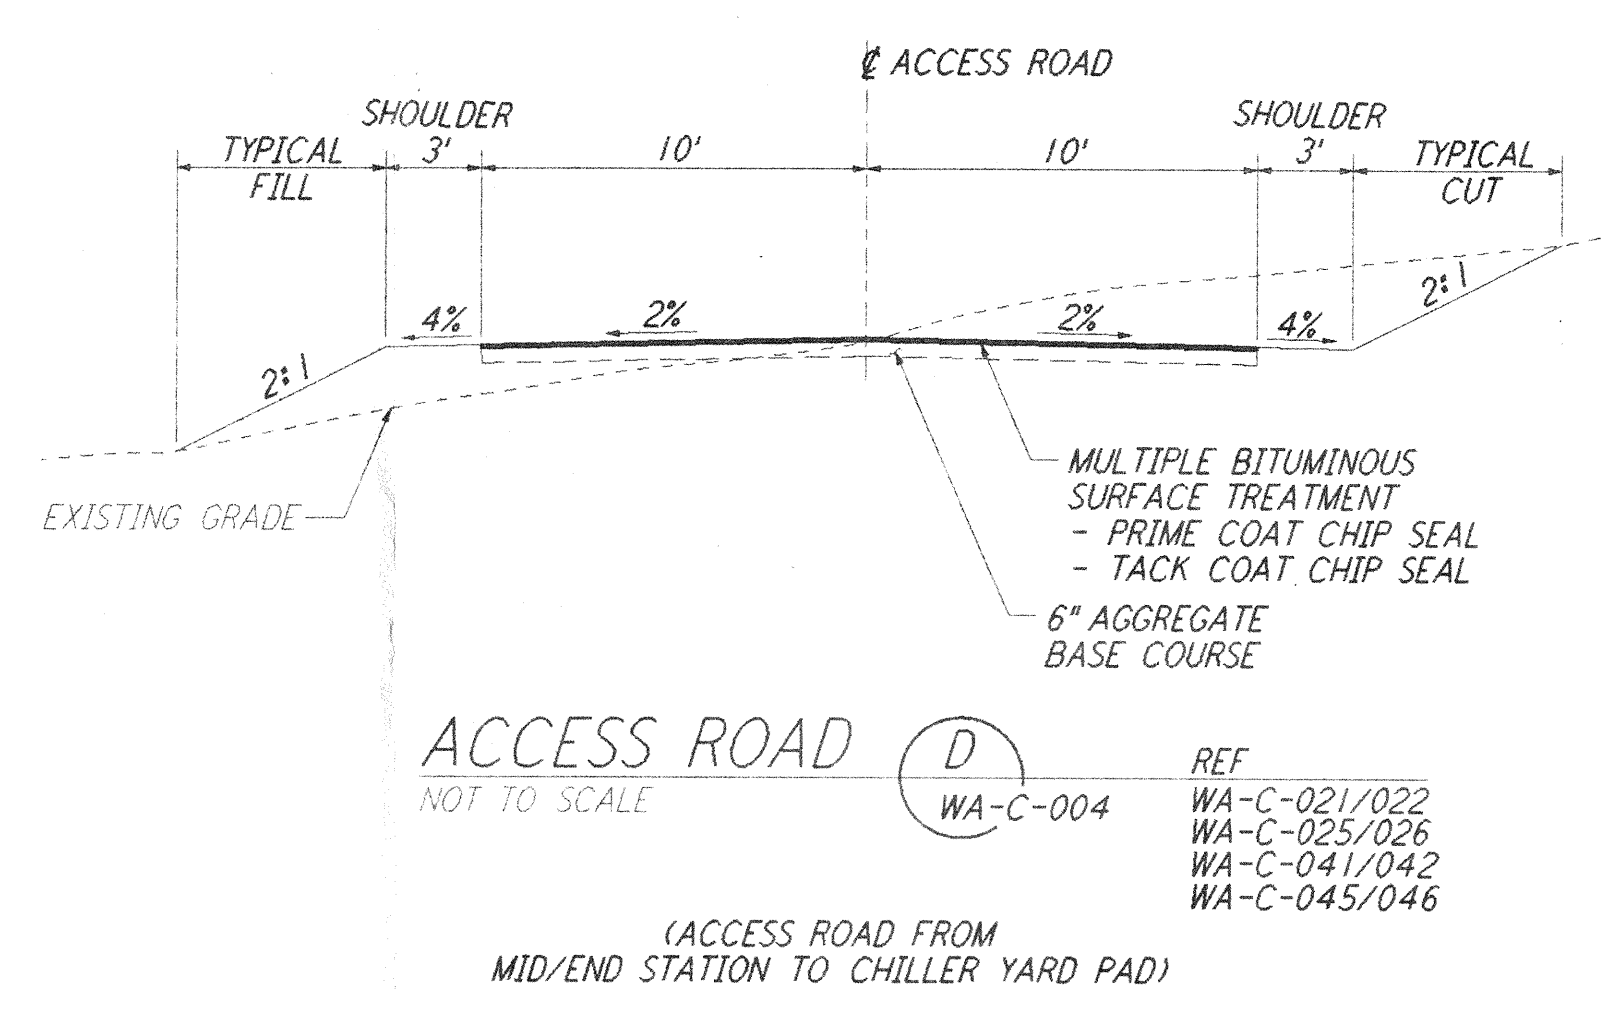





NOTES:
 1. SEE SHEET WA-C-002 FOR GENERAL NOTES, LEGEND AND ABBREVIATIONS.

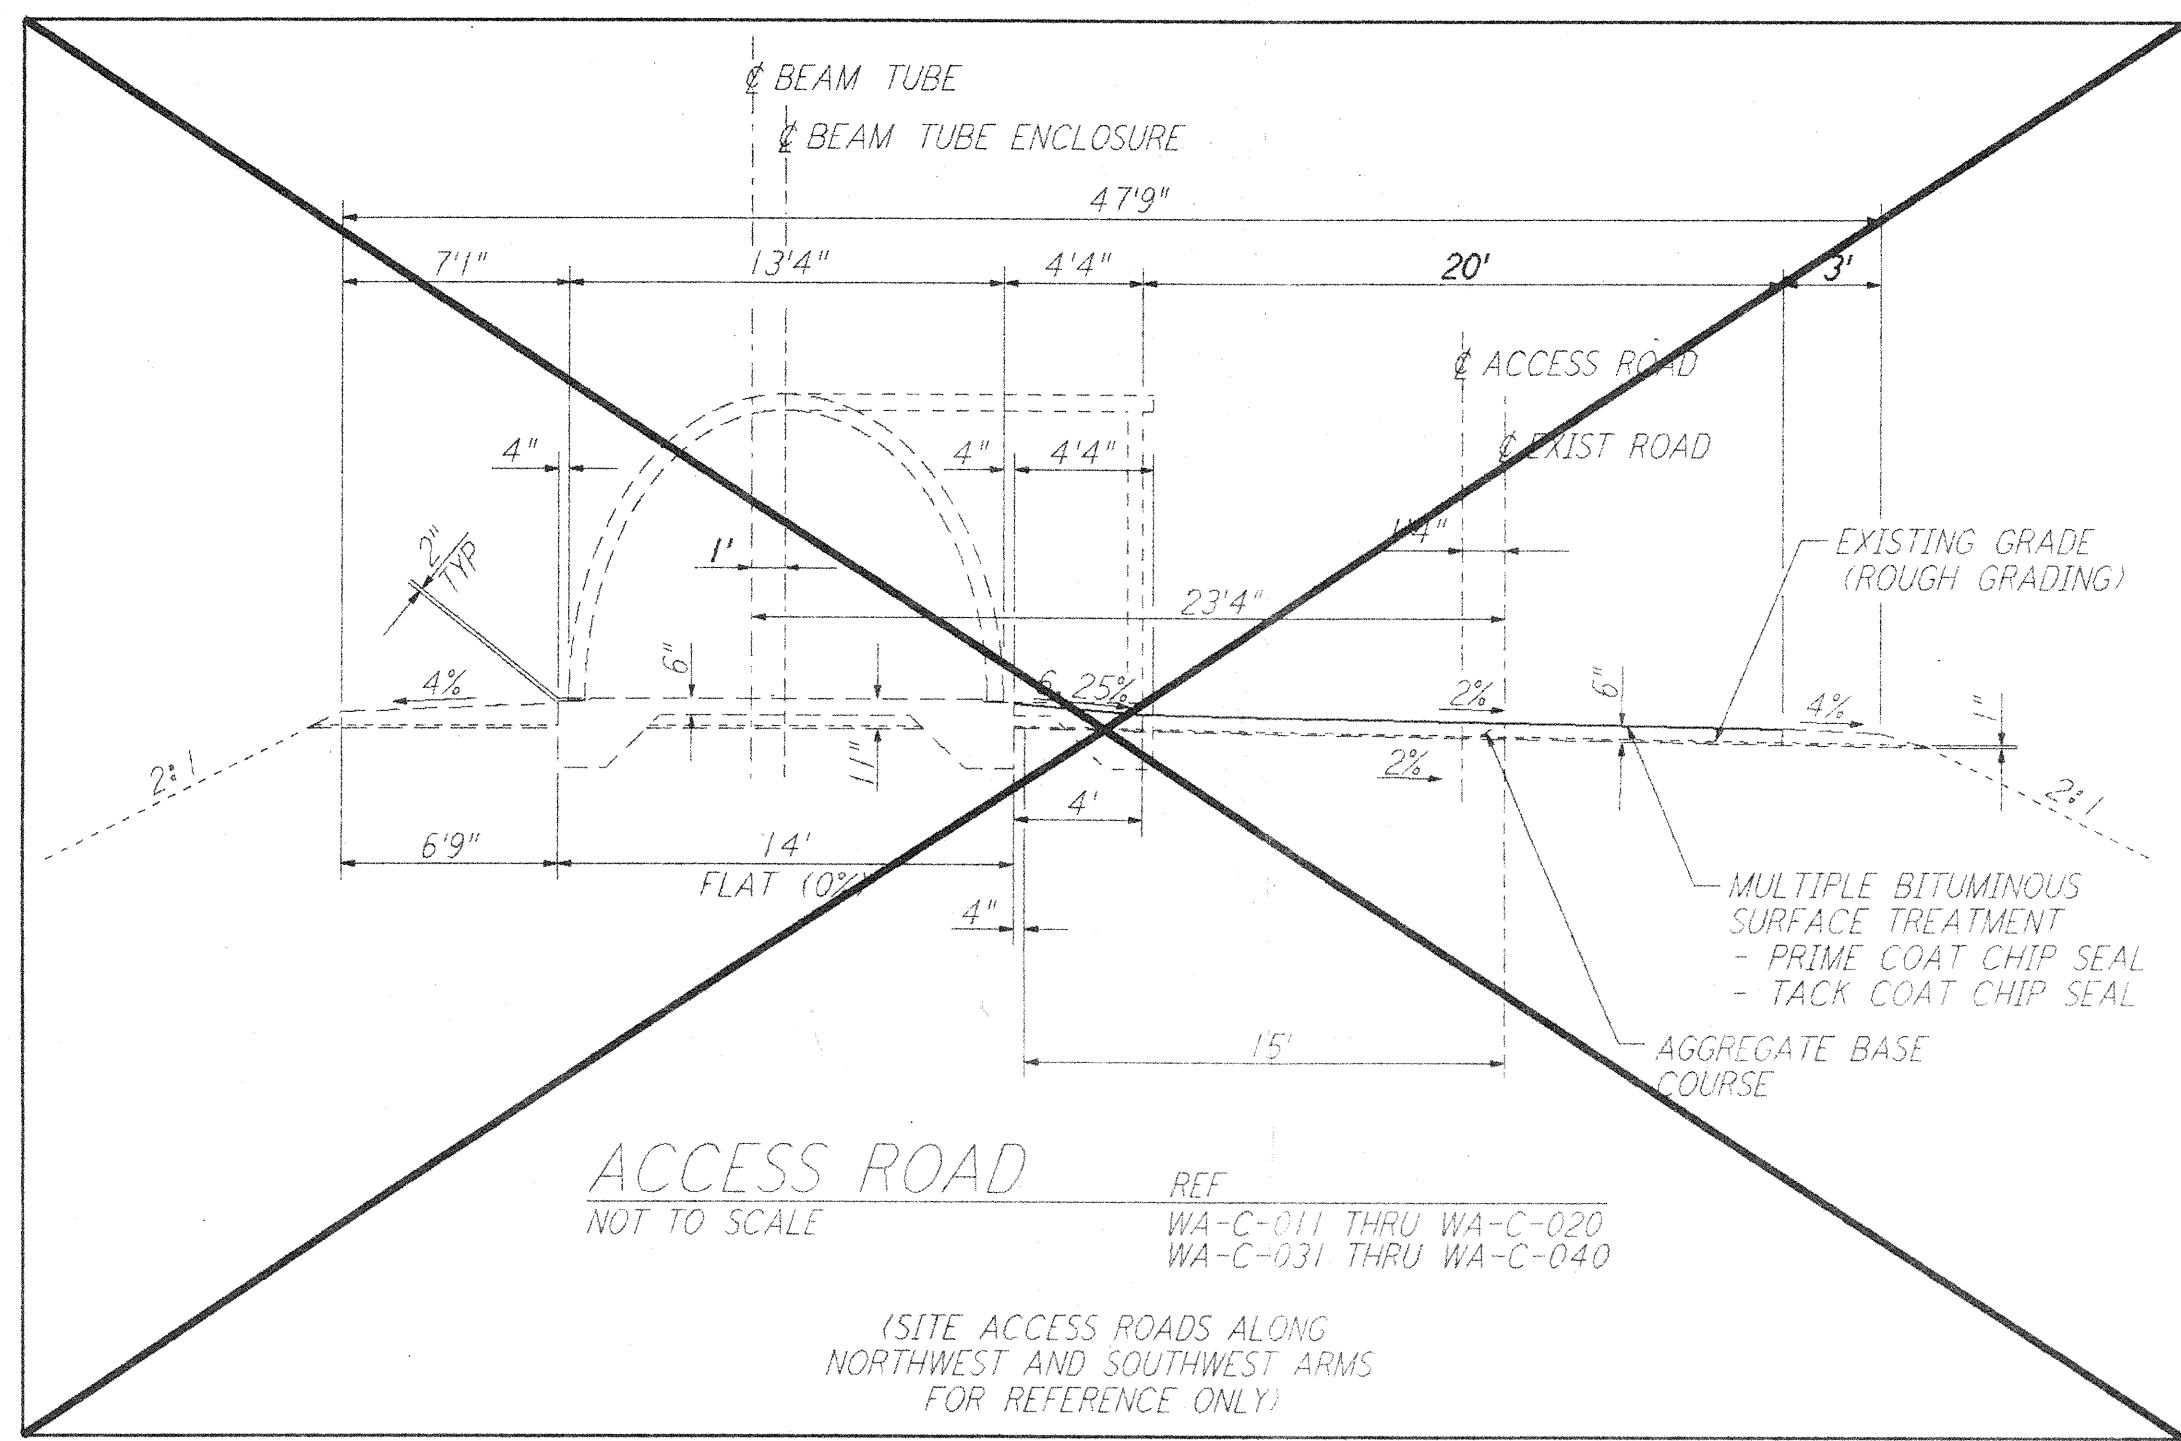

This document and the design it covers are the property of PARSONS. They are loaned only with the borrower's expressed written agreement that they will not be reproduced, copied, loaned, exhibited, or used in any other way, except by written consent from PARSONS to the borrower.

NO.	DATE	BY	CHKD	ENGR	PROJ	DESCRIPTION

FOR CONSTRUCTION	
DRAWN	WRB 9/28/95
CHECKED	ML 7/17/96
ENGINEER	95 7/19/96
PROJ	112111 7/19/96

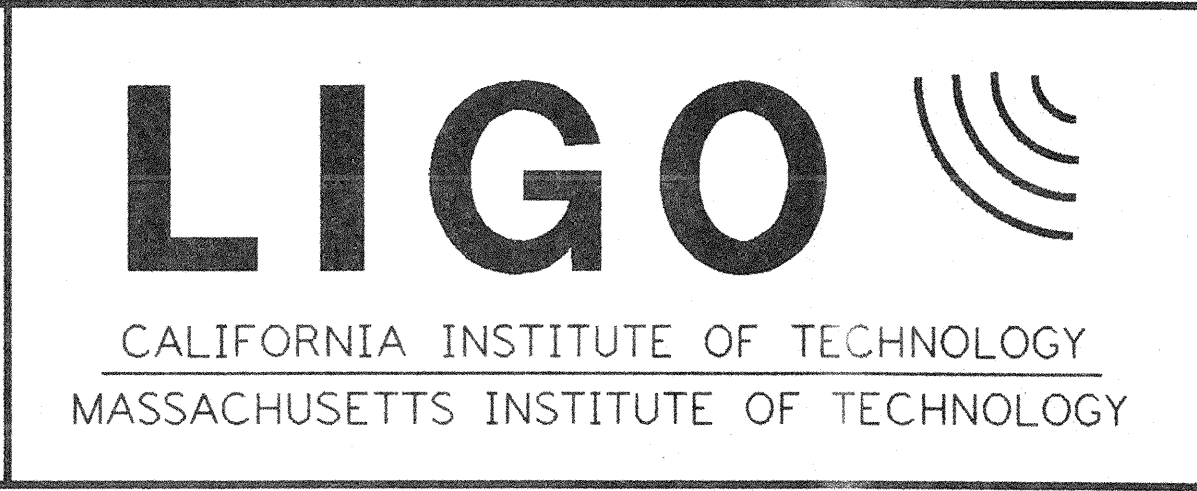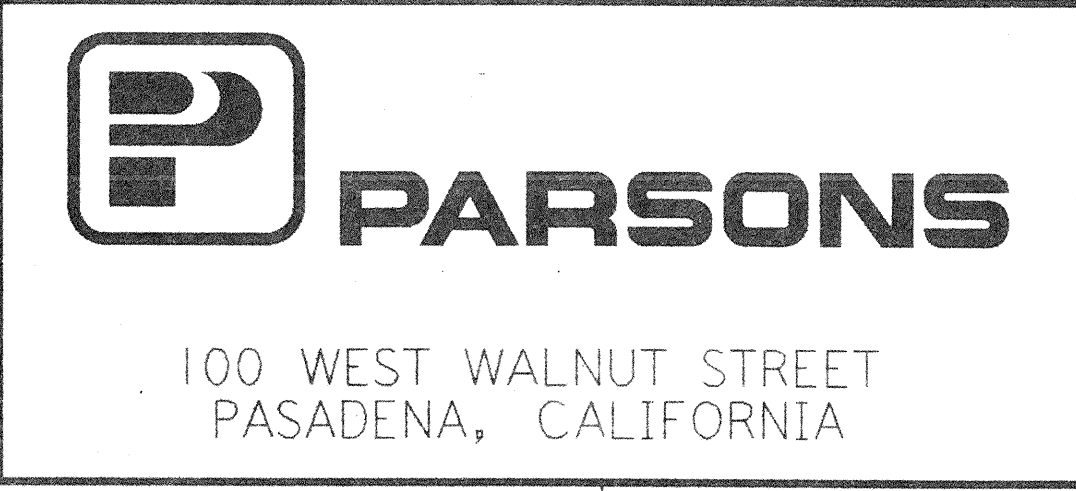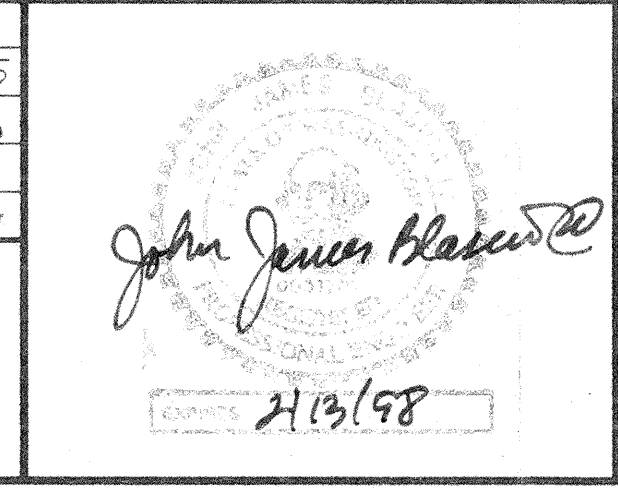

LASER INTERFEROMETER GRAVITATIONAL-WAVE OBSERVATORY SITE NO. 1 - HANFORD, WASHINGTON		
TITLE	CIVIL TYPICAL SECTIONS AND DETAILS	SCALE
SCALE	NONE	CONTRACT NUMBER
CONTRACT NUMBER	PPI50969	PROJECT NUMBER
PROJECT NUMBER	8094	REVISIONS
SHEET NUMBER		WA-C-004