DATE: 07/06/98 TIME: 14:20:33
DESIGN FILE: I:\ligo\site\ce\wac006.dgz

This document and the design it covers are the property of PARSONS. They are loaned only with the borrower's expressed written agreement that they will not be reproduced, copied, loaned, exhibited, or used in any other way, except by written consent from PARSONS to the borrower.

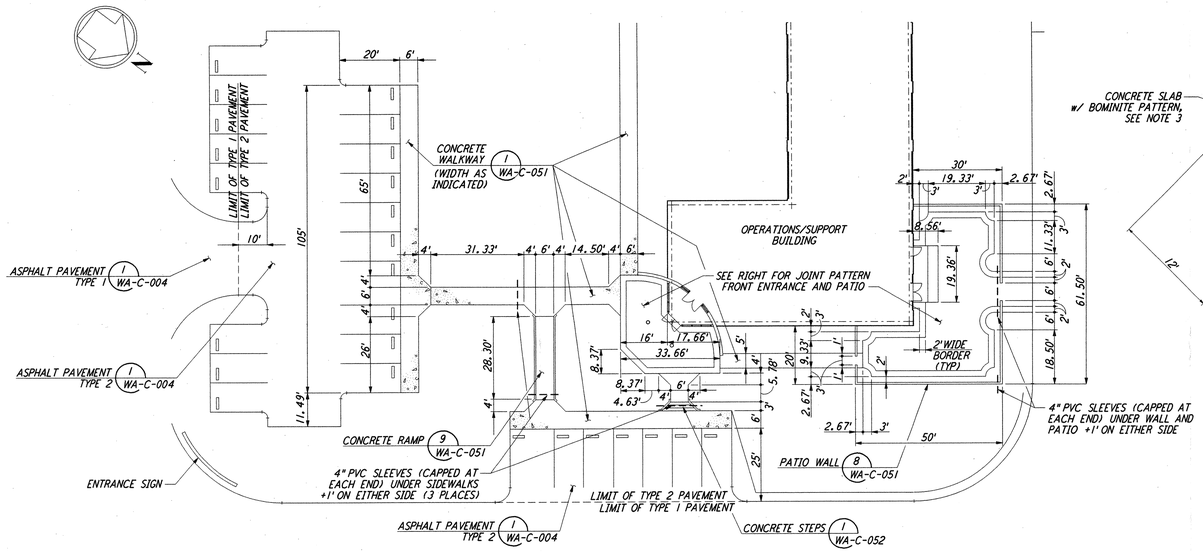

ENLARGED AREA - BUILDING ENTRANCE
SCALE: 1" = 20'

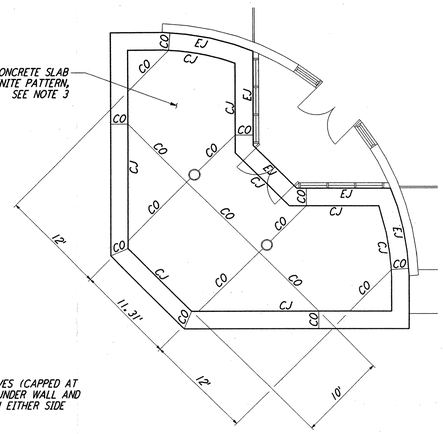

JOINT PATTERN - FRONT ENTRANCE

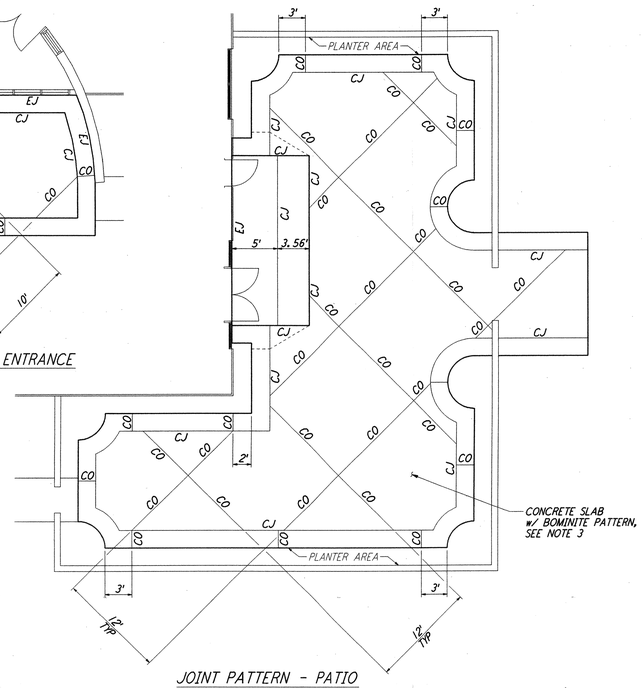

JOINT PATTERN - PATIO

NOTES:

1. SEE SHEET WA-C-002 FOR GENERAL NOTES, LEGEND AND ABBREVIATIONS.
2. SEE SHEET WA-C-505 FOR CURVE DATA.
3. BOMINITE PATTERN AND COLOR FOR FRONT ENTRANCE AND PATIO SHALL BE SUBMITTED BY CONTRACTOR FOR CLIENT APPROVAL.

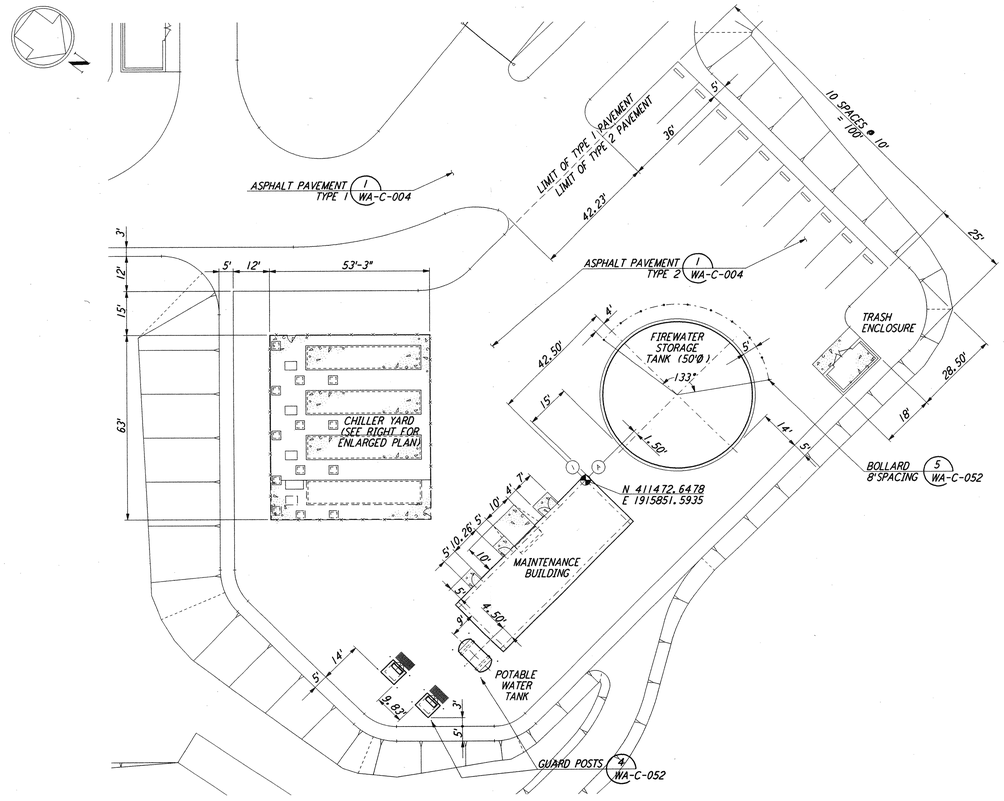

ENLARGED AREA - MAINTENANCE YARD
SCALE: 1" = 20'

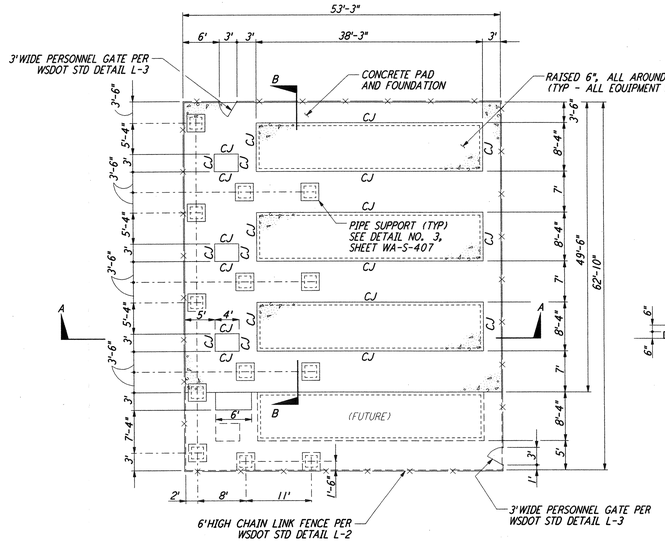

ENLARGED CHILLER YARD PLAN
SCALE: 1" = 10'

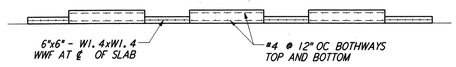

SECTION B-B

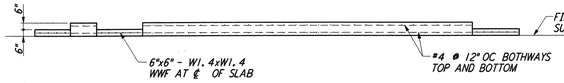

SECTION A-A

LIGO-D960200-02-O

GRAPHIC SCALE
0 20 40 60 80
SCALE: 1" = 20'

REFERENCES		REVISIONS						
DRAWING NO.	DESCRIPTION	NO.	DATE	BY	CHKD	ENGR	PROJ	DESCRIPTION
		2	5/15/98	WRB			MDW	ISSUED FOR AS-BUILT
		1	2-28-97	WRB	ML	JB	MDW	ADDED WALK/WALL OPENING, REVISED GRADING

FOR CONSTRUCTION		
DRAWN	WRB	9/28/95
CHECKED	ML	7/9/96
ENGINEER	JB	7/9/96
PROJ	MDW	7/9/96

AS-BUILT DRAWINGS

PARSONS
100 WEST WALNUT STREET
PASADENA, CALIFORNIA

LIGO
CALIFORNIA INSTITUTE OF TECHNOLOGY
MASSACHUSETTS INSTITUTE OF TECHNOLOGY

LASER INTERFEROMETER GRAVITATIONAL-WAVE OBSERVATORY
SITE NO. 1 - HANFORD, WASHINGTON

TITLE	SCALE	CONTRACT NUMBER	PROJECT NUMBER
CIVIL CORNER STATION PLOT PLAN ENLARGED PLANS	AS NOTED	PP150969	8094
	SHEET NUMBER	WA-C-006	REVISIONS 2

LIGOWAF3.BDR

Mon Jul 06 14:20:02 1998 C:\PLOT OUES\S-V3682.DCF 520805 kvV3682>ce006.prf