This document and the design it covers are the property of **PARSONS**. They are loaned only with the borrower's expressed written agreement that they will not be reproduced, copied, loaned, exhibited, or used in any other way, except by written consent from **PARSONS** to the borrower.

DESIGN FILE: I:\ligo\site1\ce\wac006.dgz

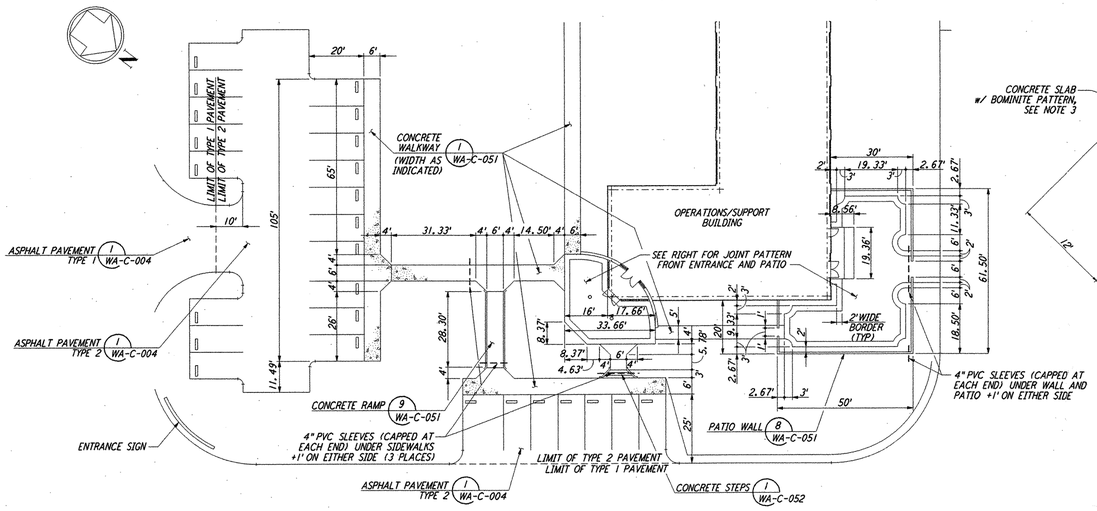

ENLARGED AREA - BUILDING ENTRANCE

SCALE: 1" = 20'

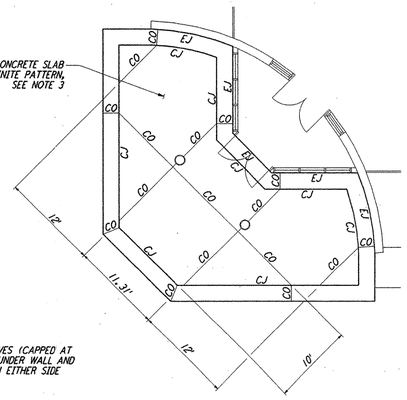

JOINT PATTERN - FRONT ENTRANCE

NOTES:

1. SEE SHEET WA-C-002 FOR GENERAL NOTES, LEGEND AND ABBREVIATIONS.
2. SEE SHEET WA-C-505 FOR CURVE DATA.
3. BOMINITE PATTERN AND COLOR FOR FRONT ENTRANCE AND PATIO SHALL BE SUBMITTED BY CONTRACTOR FOR CLIENT APPROVAL.

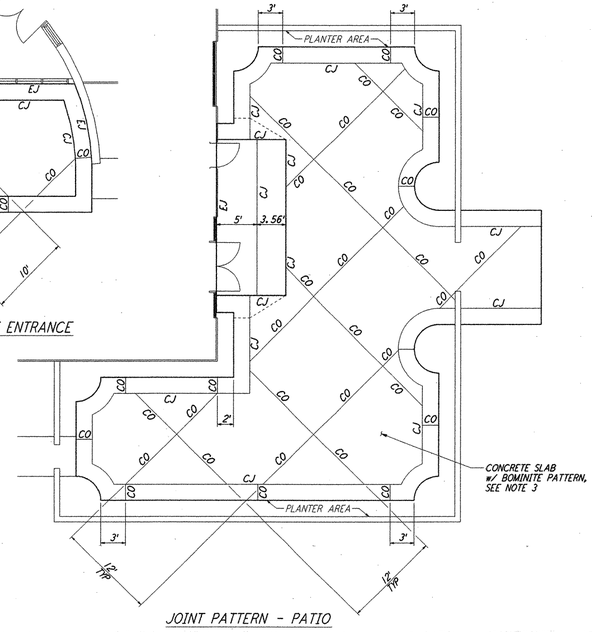

JOINT PATTERN - PATIO

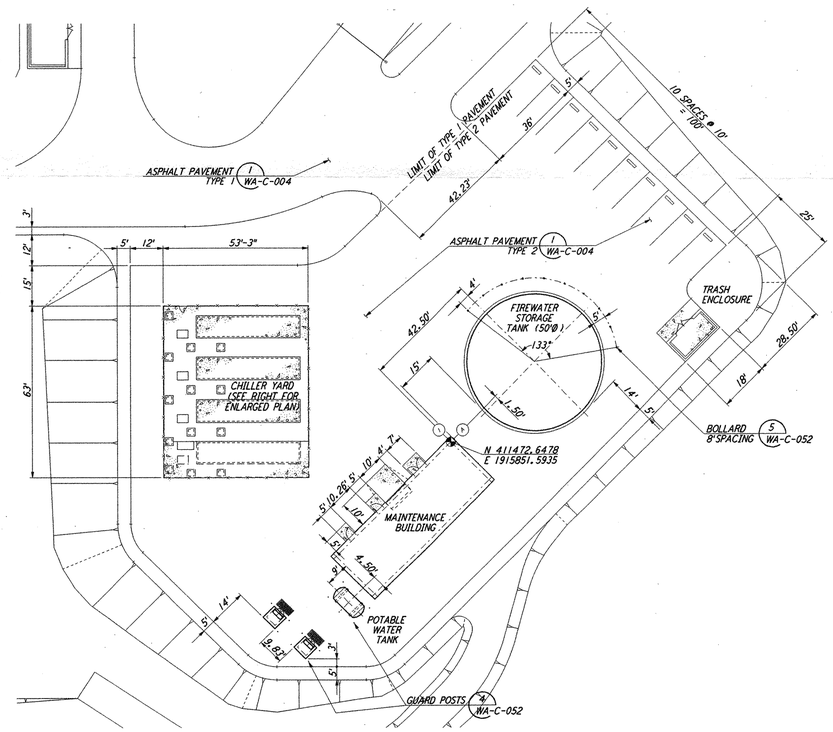

ENLARGED AREA - MAINTENANCE YARD

SCALE: 1" = 20'

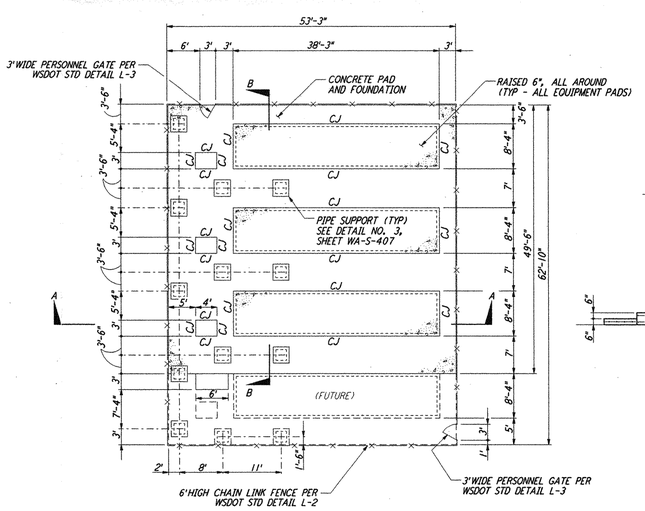

ENLARGED CHILLER YARD PLAN

SCALE: 1" = 10'

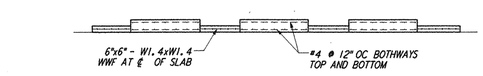

SECTION B-B

SECTION A-A

LIGO-D960200-02-O

GRAPHIC SCALE

0 20 40 60 80

SCALE: 1" = 20'

REFERENCES DRAWING NO.	DESCRIPTION

REVISIONS NO.	DATE	BY	CHKD	ENGR	PROJ	DESCRIPTION
2	5/15/98	WRB	[illegible]	[illegible]	[illegible]	ISSUED FOR AS-BUILT
1	2-28-97	WRB	ML	JB	MDW	ADDED WALK/WALL OPENING, REVISED GRADING

FOR CONSTRUCTION		
DRAWN	WRB	9/28/95
CHECKED	ML	7/9/96
ENGINEER	JB	7/9/96
PROJ	MDW	7/9/96

AS-BUILT DRAWINGS

PARSONS
100 WEST WALNUT STREET
PASADENA, CALIFORNIA

LIGO
CALIFORNIA INSTITUTE OF TECHNOLOGY
MASSACHUSETTS INSTITUTE OF TECHNOLOGY

LASER INTERFEROMETER GRAVITATIONAL-WAVE OBSERVATORY
SITE NO. 1 - HANFORD, WASHINGTON

TITLE: CIVIL CORNER STATION PLOT PLAN ENLARGED PLANS

SCALE	CONTRACT NUMBER	PROJECT NUMBER
AS NOTED	PP150969	8094

SHEET NUMBER: WA-C-006 REVISIONS: 2

LIGOWAF3.BDR

Mon Jul 06 14:26:02 1998 C:\PLOT\GUE\S3-Y3682.DCF 52865 K:\Y3682\wac006.prf