This document and the design it covers are the property of **PARSONS**. They are loaned only with the borrower's expressed written agreement that they will not be reproduced, copied, loaned, exhibited, or used in any other way, except by written consent from **PARSONS** to the borrower.

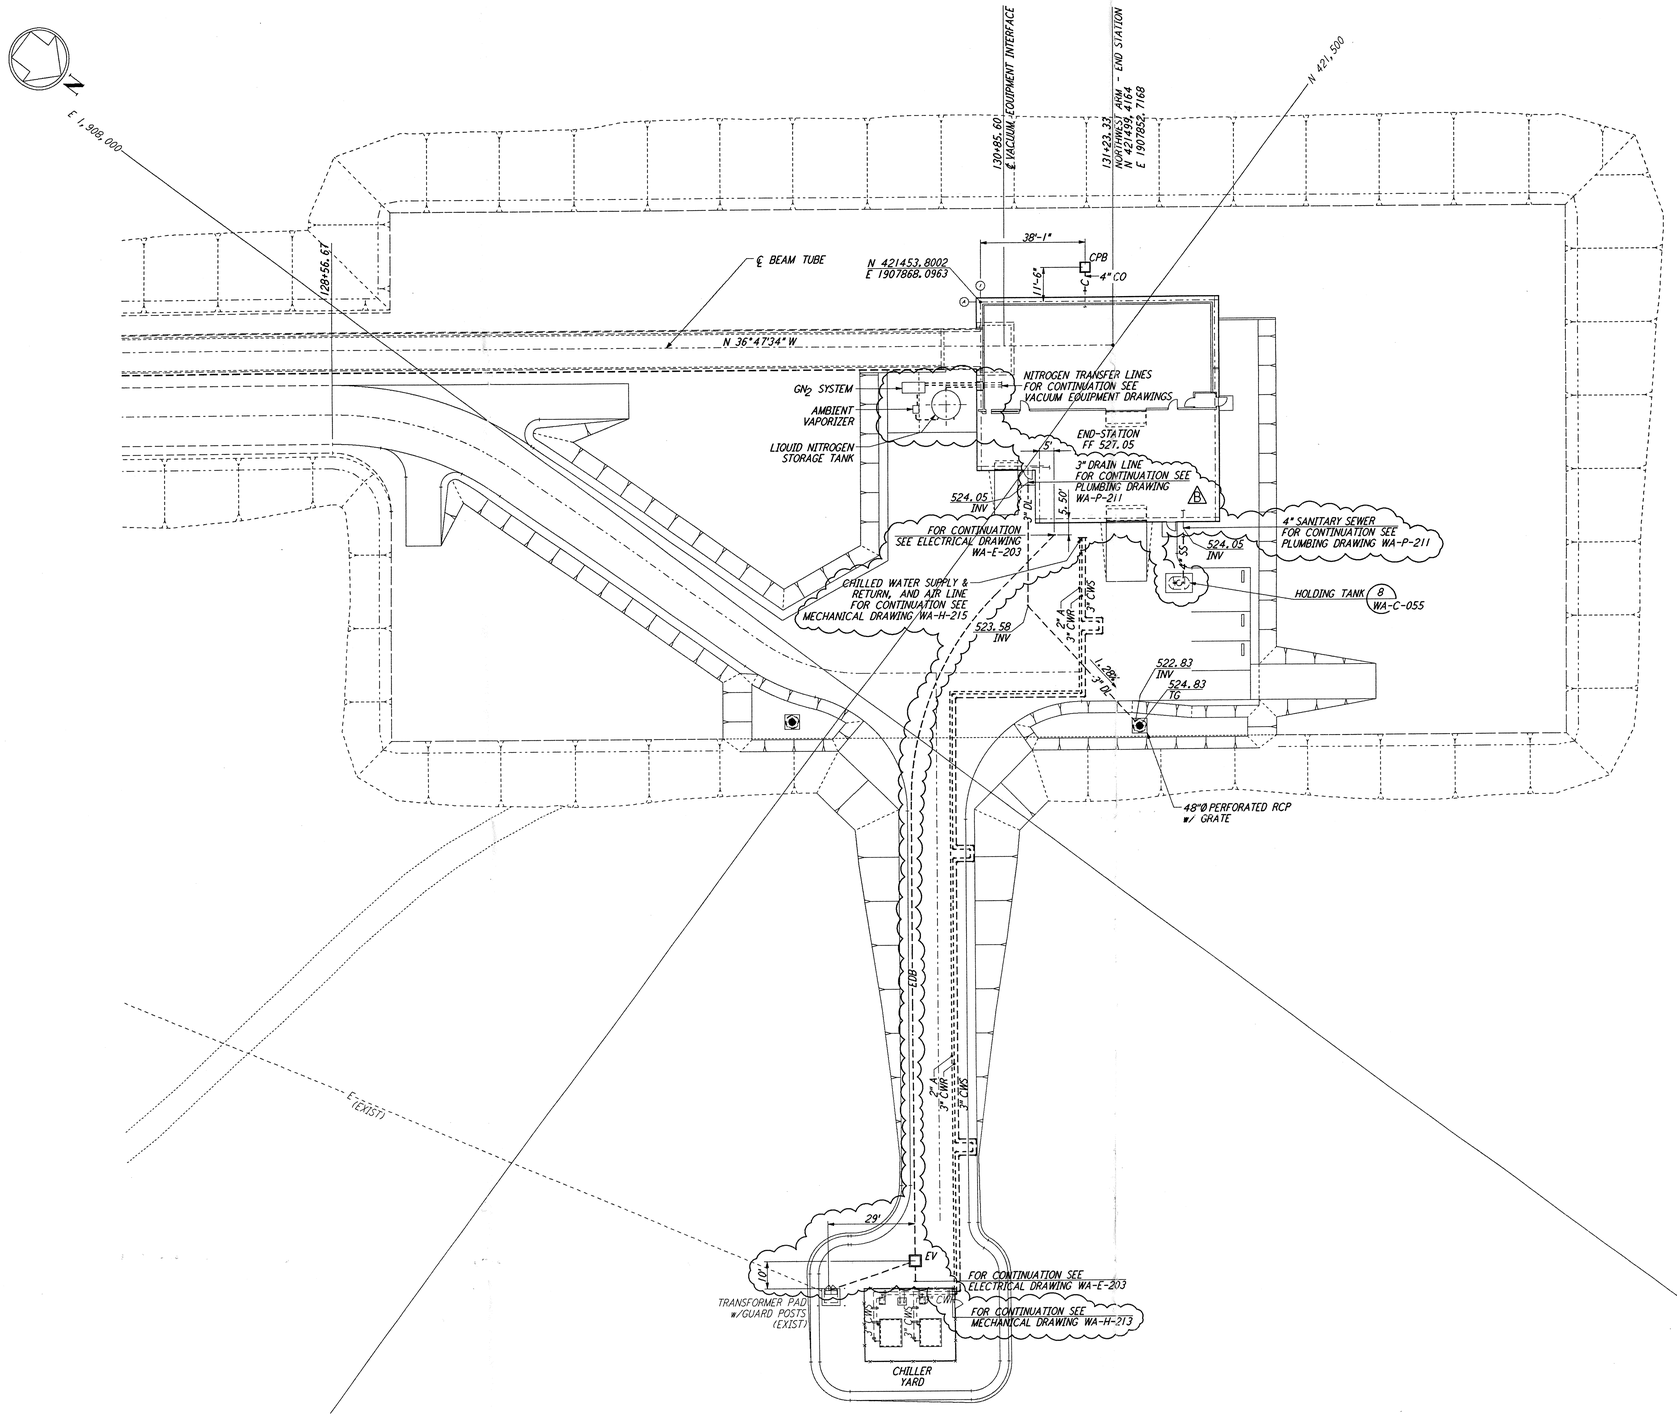

NOTES:

1. SEE SHEET WA-C-002 FOR GENERAL NOTES, LEGEND AND ABBREVIATIONS.

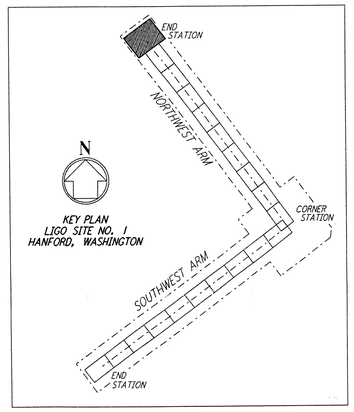

GRAPHIC SCALE
0 20 40 60 80
SCALE: 1" = 20'

LIGO-D960217-B-O

REFERENCES								
DRAWING NO.	DESCRIPTION							

REVISIONS							
NO.	DATE	BY	CHKD	ENGR	PROJ	DESCRIPTION	
B	5/22/96	WRB	ML	JB	MDW	BID ADDENDUM #2	
A	4/19/96	WRB	ML	JB	MDW	FINAL DESIGN REVIEW & BID	

DRAWN	WRB
CHECKED	
ENGINEER	
PROJ	

PARSONS
100 WEST WALNUT STREET
PASADENA, CALIFORNIA

LIGO
CALIFORNIA INSTITUTE OF TECHNOLOGY
MASSACHUSETTS INSTITUTE OF TECHNOLOGY

LASER INTERFEROMETER
GRAVITATIONAL-WAVE OBSERVATORY
SITE NO. 1 - HANFORD, WASHINGTON

TITLE
CIVIL
NORTHWEST ARM
END-STATION
UTILITY PLAN

SCALE	CONTRACT NUMBER	PROJECT NUMBER
1" = 20'	PP150969	8094

SHEET NUMBER: WA-C-027
REVISIONS: B

LIGOWAF3.BDR

Wed May 22 08:39:55 1996 J:\PLOTS\WA\E\WAC027.CHF
Wed May 22 08:39:28 1996 J:\PLOTS\WA\E\WAC027.DGZ