This document and the design it covers are the property of **PARSONS**. They are loaned only with the borrower's expressed written agreement that they will not be reproduced, copied, loaned, exhibited, or used in any other way, except by written consent from **PARSONS** to the borrower.

DATE: 07/06/98 TIME: 14:05:06
DESIGN FILE: I:\ligo\site1\ce\wac037.dgz

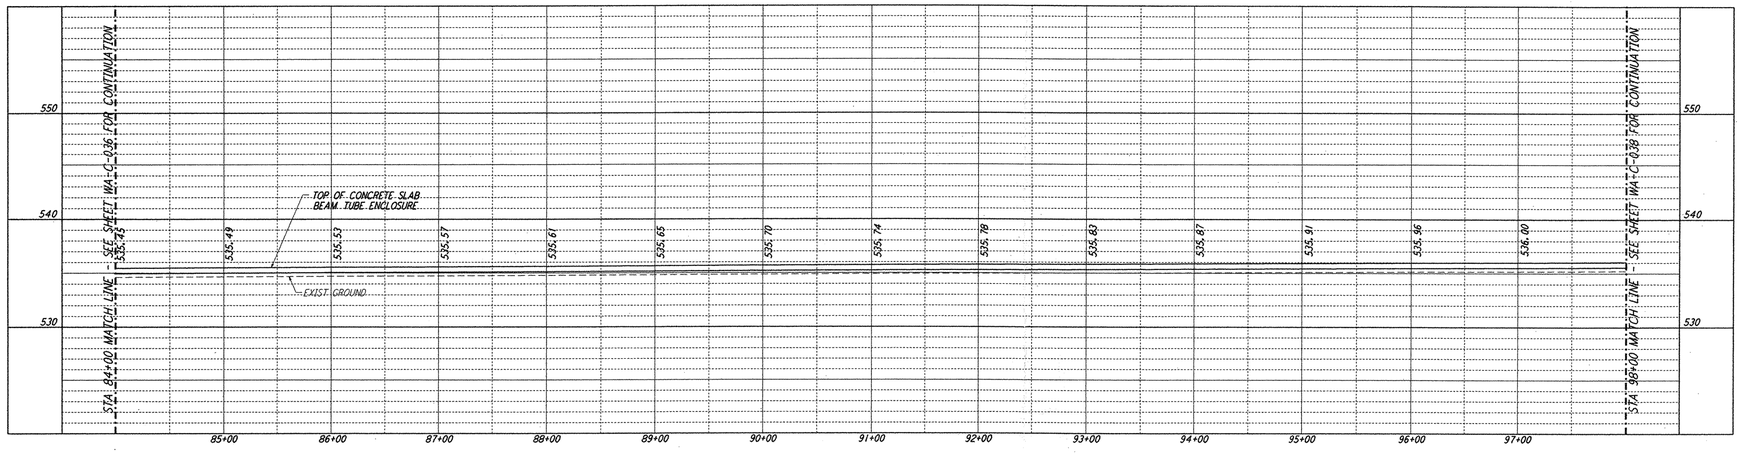

PROFILE
SCALES: HORIZ: 1" = 50'
VERT: 1" = 5'

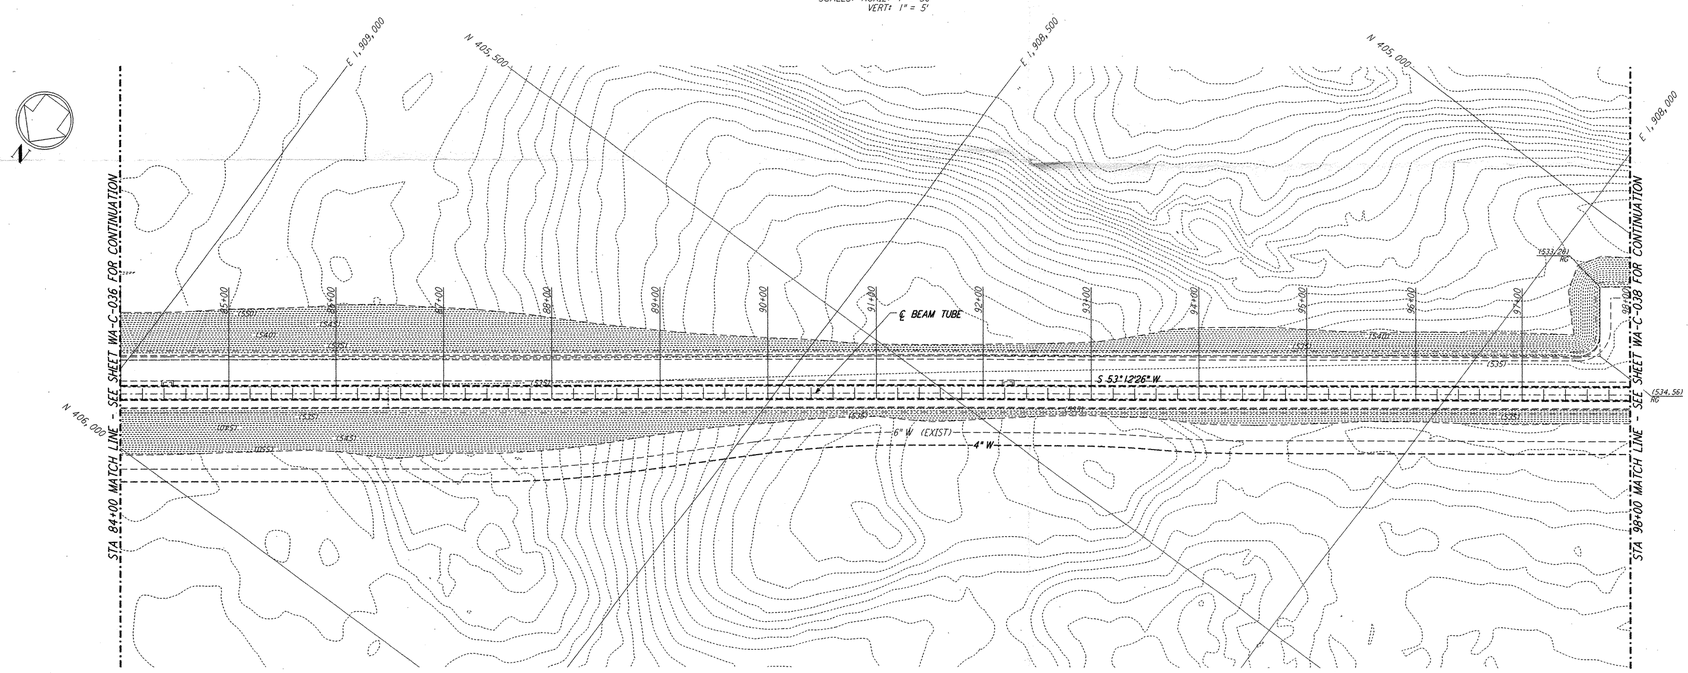

PLAN
SCALE: 1" = 50'

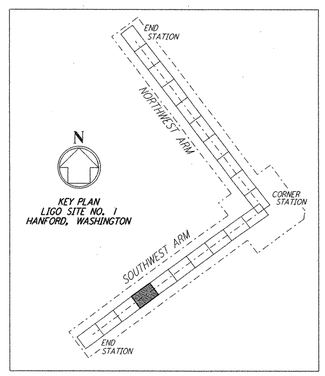

KEY PLAN
LIGO SITE NO. 1
HANFORD, WASHINGTON

LIGO-D960224-01-O

GRAPHIC SCALES
0 50 100 150 200
HORIZ SCALE: 1" = 50'
0 5 10 15 20
VERT SCALE: 1" = 5'

NOTES:
1. SEE SHEET WA-C-002 FOR GENERAL NOTES, LEGEND AND ABBREVIATIONS.

REFERENCES

DRAWING NO.	DESCRIPTION

REVISIONS

NO.	DATE	BY	CHKD	ENGR	PROJ	DESCRIPTION
1	5/15/98	WRB				ISSUED FOR AS-BUILT

FOR CONSTRUCTION		
DRAWN	WRB	9/28/95
CHECKED	ML	7/9/96
ENGINEER	JB	7/9/96
PROJ	MDW	7/9/96

AS-BUILT DRAWINGS

PARSONS
100 WEST WALNUT STREET
PASADENA, CALIFORNIA

LIGO
CALIFORNIA INSTITUTE OF TECHNOLOGY
MASSACHUSETTS INSTITUTE OF TECHNOLOGY

LASER INTERFEROMETER
GRAVITATIONAL-WAVE OBSERVATORY
SITE NO. 1 - HANFORD, WASHINGTON

TITLE
CIVIL
SOUTHWEST ARM
PLAN AND PROFILE
STA 84+00 TO STA 98+00

SCALE	CONTRACT NUMBER	PROJECT NUMBER
AS NOTED	PP150969	8094

SHEET NUMBER: WA-C-037
REVISIONS: 1

LIGOWAF3.BDR

Mon Jul 06 14:04:40 1998 C:\PLOTJOBS\S3-V3882.JOB 52885 K:\V3882\ce037.prf