


NOTES:
1. SEE SHEET WA-C-002 FOR GENERAL NOTES, LEGEND AND ABBREVIATIONS.

This document and the design it covers are the property of PARSONS. They are loaned only with the borrower's expressed written agreement that they will not be reproduced, copied, loaned, exhibited, or used in any other way, except by written consent from PARSONS to the borrower.


This document and the design it covers are the property of PARSONS. They are loaned only with the borrower's expressed written agreement that they will not be reproduced, copied, loaned, exhibited, or used in any other way, except by written consent from PARSONS to the borrower.

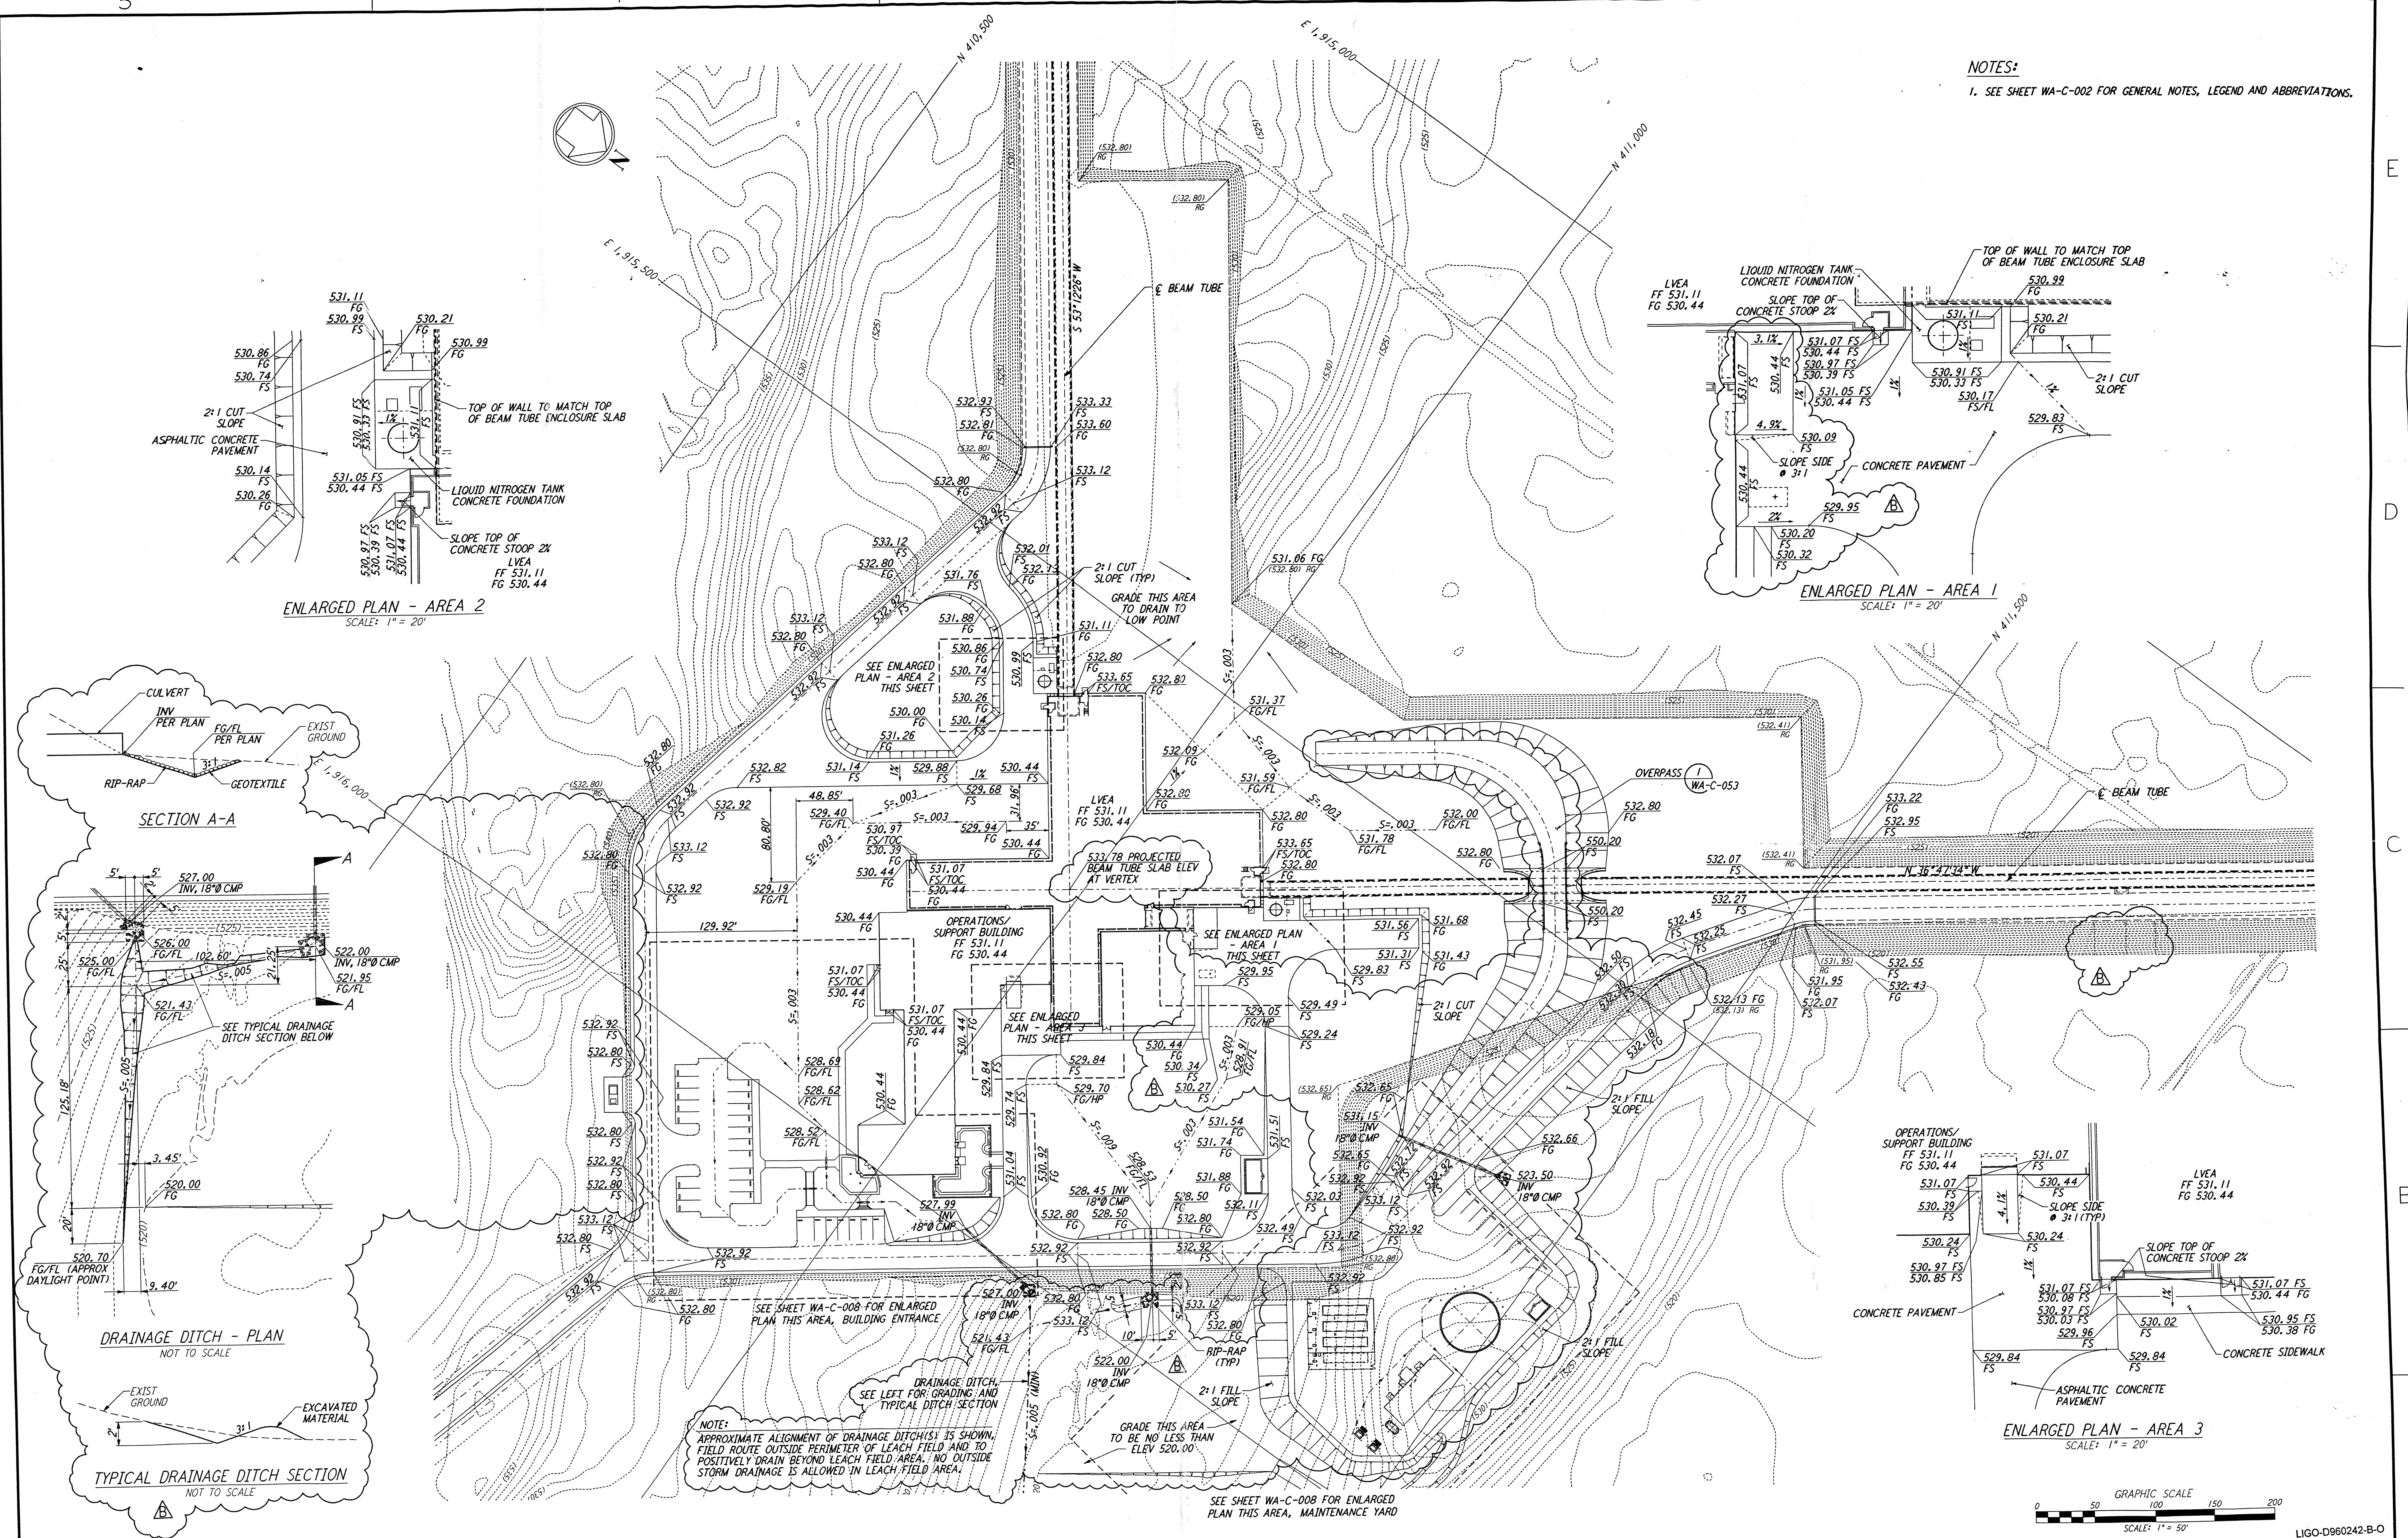

ENLARGED PLAN - AREA 2
SCALE: 1" = 20'

ENLARGED PLAN - AREA 1
SCALE: 1" = 20'

ENLARGED PLAN - AREA 3
SCALE: 1" = 20'

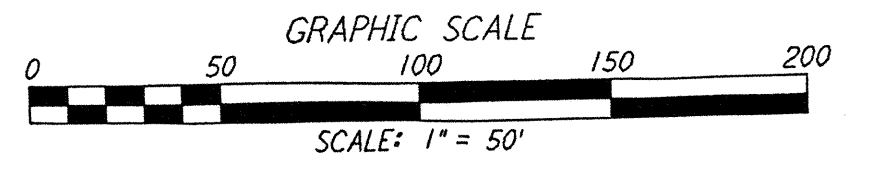

LIGO-D960242-B-0

NO.	DATE	BY	CHKD	ENGR	PROJ	DESCRIPTION
B	5/22/96	WRB	ML	JB	BID	BID ADDENDUM #2
A	4/19/96	WRB	ML	JB	MOW	FINAL DESIGN REVIEW & BID

DRAWN	WRB
CHECKED	
ENGINEER	
PROJ	



100 WEST WALNUT STREET
PASADENA, CALIFORNIA



CALIFORNIA INSTITUTE OF TECHNOLOGY
MASSACHUSETTS INSTITUTE OF TECHNOLOGY

LASER INTERFEROMETER
GRAVITATIONAL-WAVE OBSERVATORY
SITE NO. 1 - HANFORD, WASHINGTON

TITLE	CIVIL CORNER STATION GRADING PLAN	SCALE 1" = 50'	CONTRACT NUMBER PPI50969	PROJECT NUMBER 8094
SHEET NUMBER	WA-C-507	REVISIONS		