
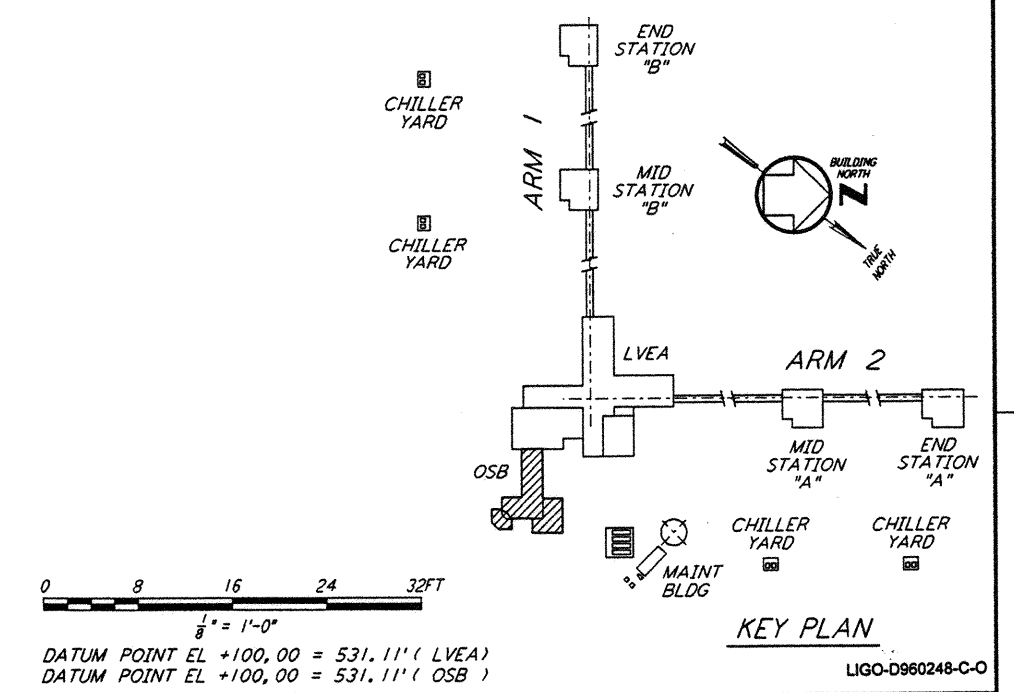


NOTE: SEE SPECIFICATIONS FOR  
 ADDITIONAL INFORMATION  
 AND SCHEDULES

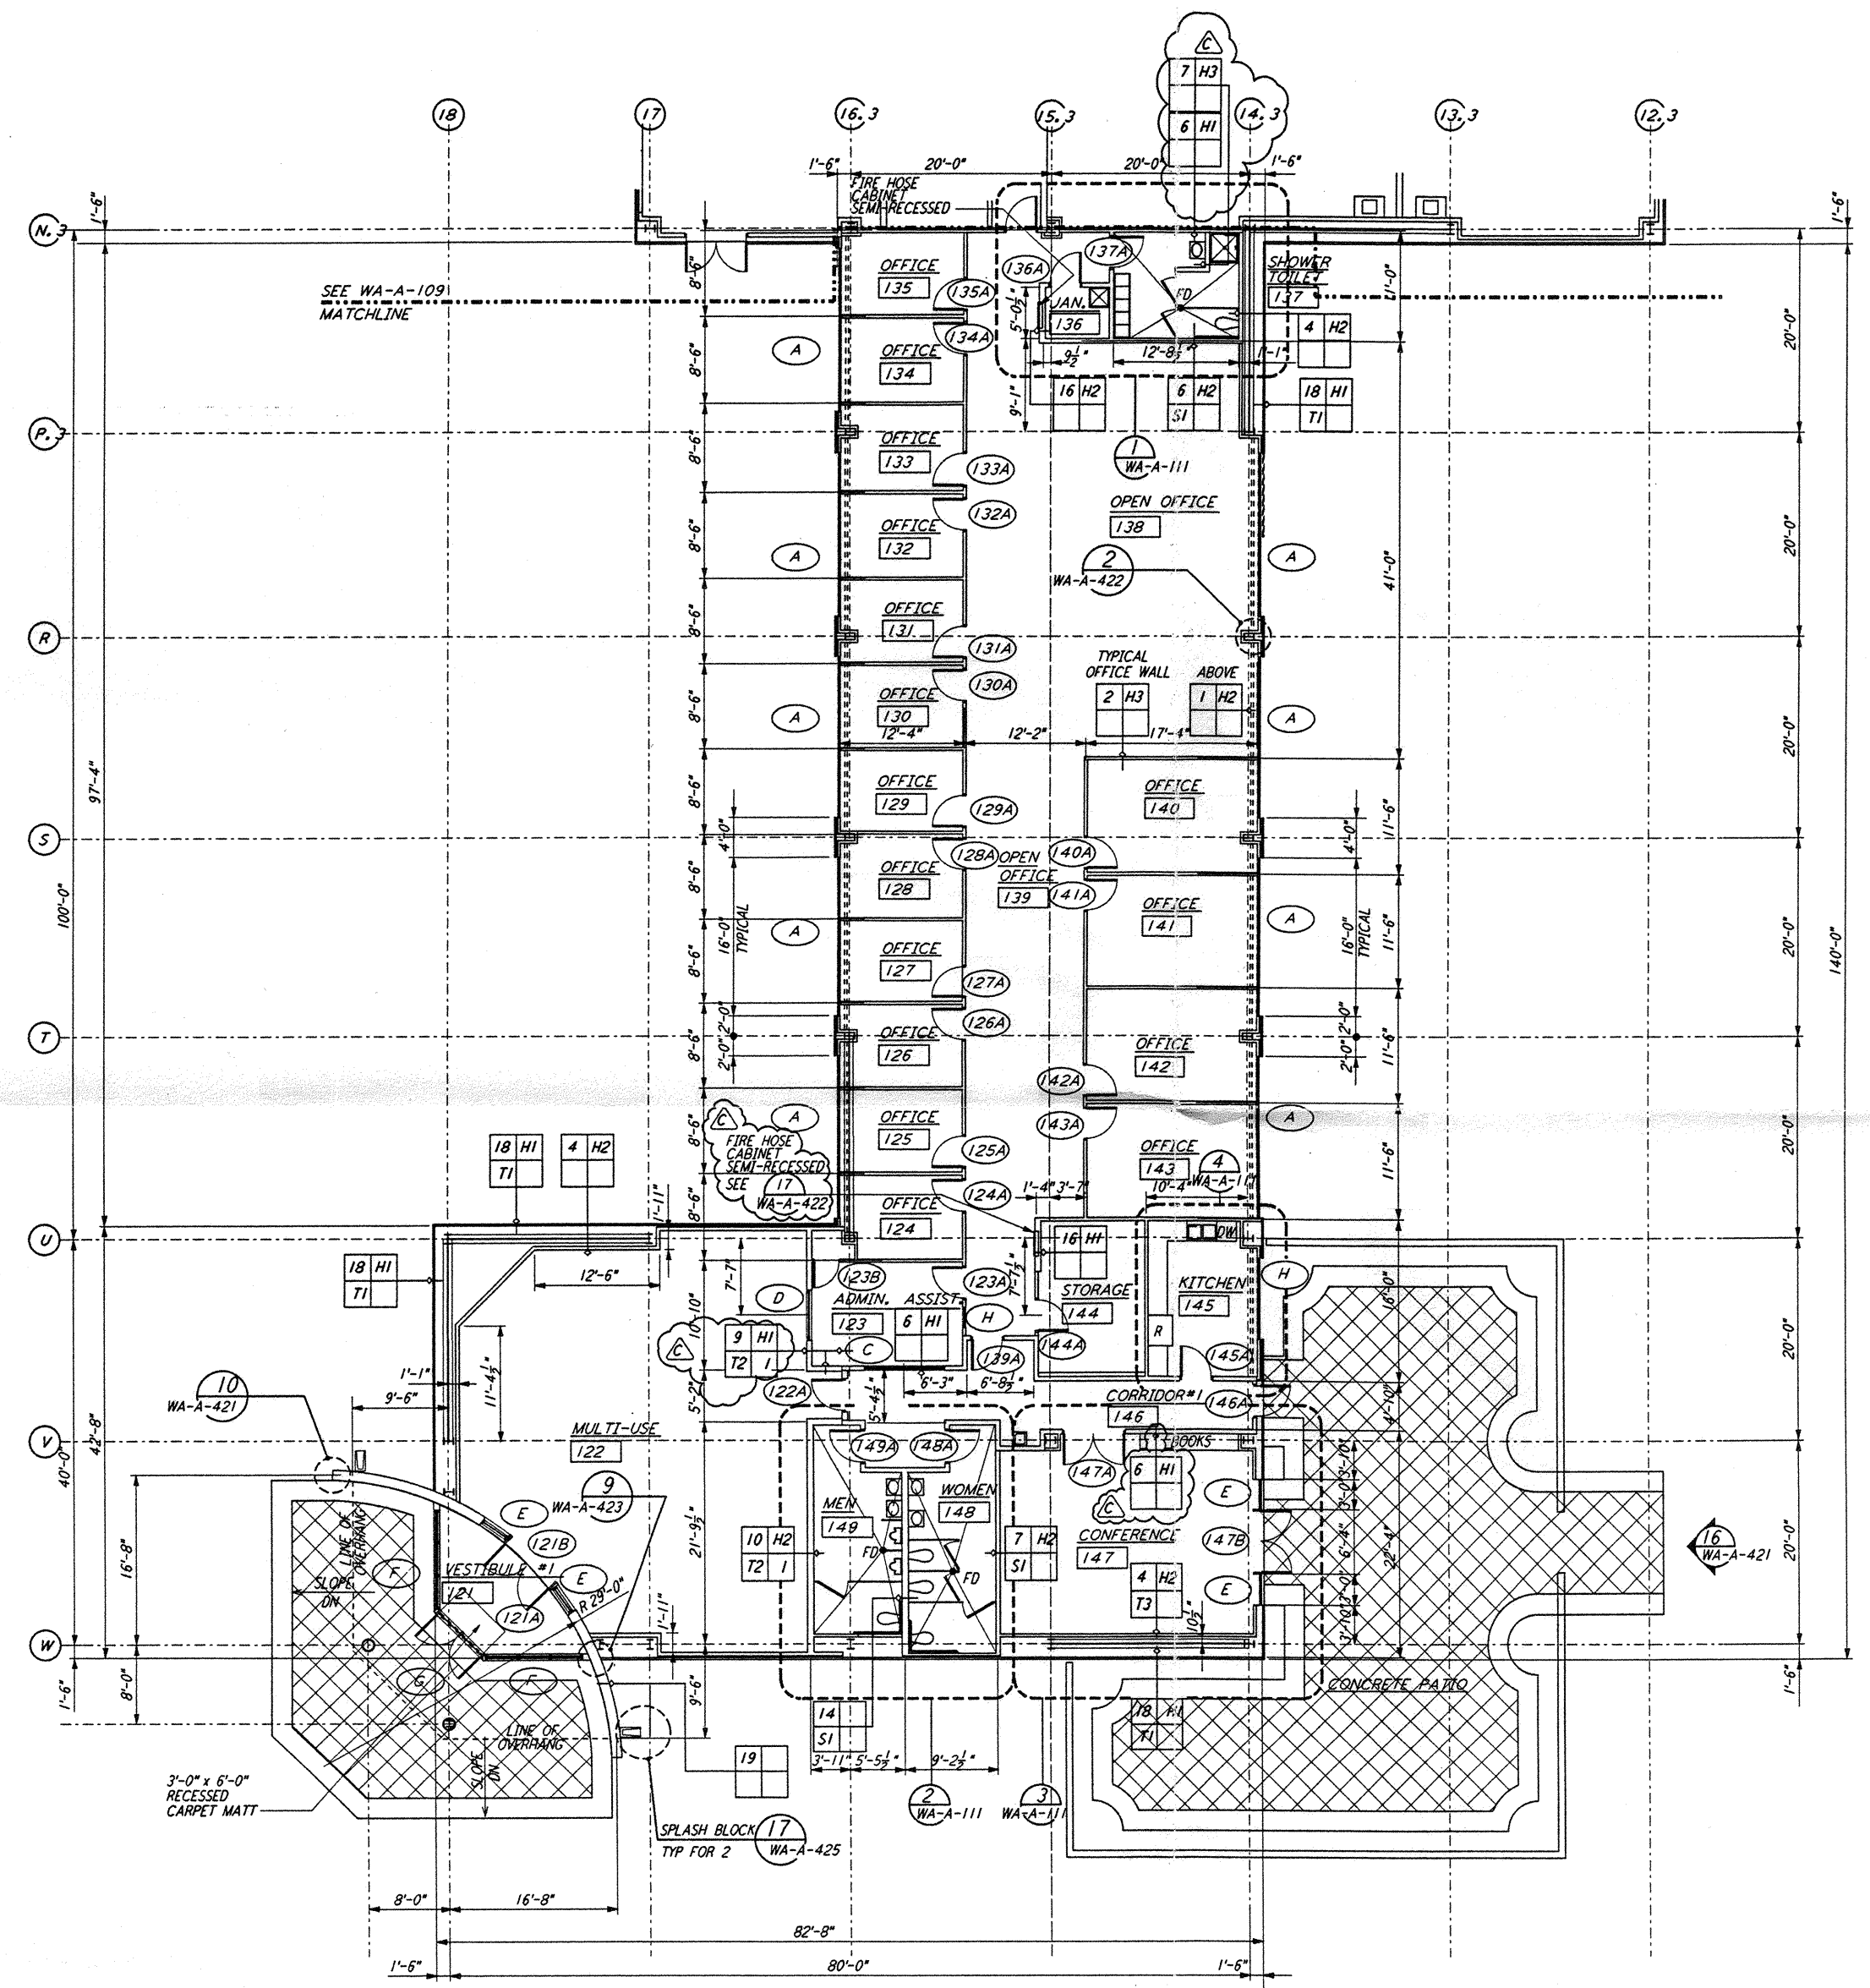

not be reproduced, copied, loaned, exhibited, or used in  
 any other way, except by written consent from  
**PARSONS** to the borrower.

This document and the design it covers are the property  
 of **PARSONS**. They are loaned only with the  
 borrower's expressed written agreement that they will

NO.	DATE	BY	CHKD	ENGR	PROJ	DESCRIPTION
C	5-22-96	BK	BK	SF	TDM	BID ADDENDUM #2
B	4-19-96	SF	SF	TDM	TDM	FINAL DESIGN REVIEW & BID
A	01/17/96	SF	SF	TDM	TDM	PRELIMINARY DESIGN REVIEW

DRAWN	SF/CKT
CHECKED	
ENGINEER	
PROJ	

**PARSONS**  
 100 WEST WALNUT STREET  
 PASADENA, CALIFORNIA

**LIGO**  
 CALIFORNIA INSTITUTE OF TECHNOLOGY  
 MASSACHUSETTS INSTITUTE OF TECHNOLOGY

LASER INTERFEROMETER  
 GRAVITATIONAL-WAVE OBSERVATORY  
 SITE NO. 1 - HANFORD, WASHINGTON

ARCHITECTURAL  
 CORNER STATION  
 OSB PARTIAL FLOOR PLAN  
 SHEET 1

AS NOTED PPI50969 8094  
**WA-A-108**