
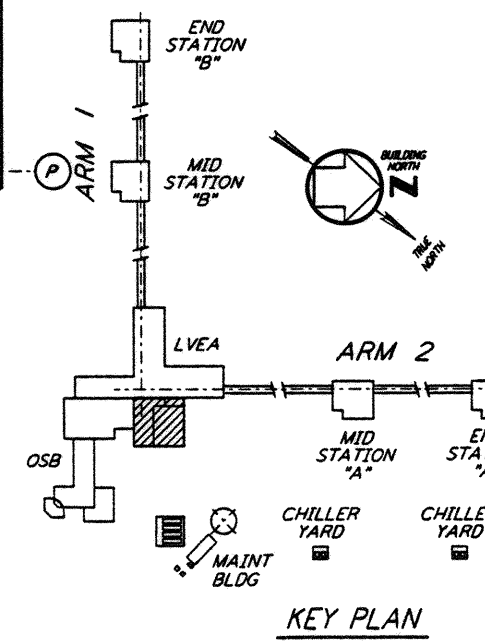
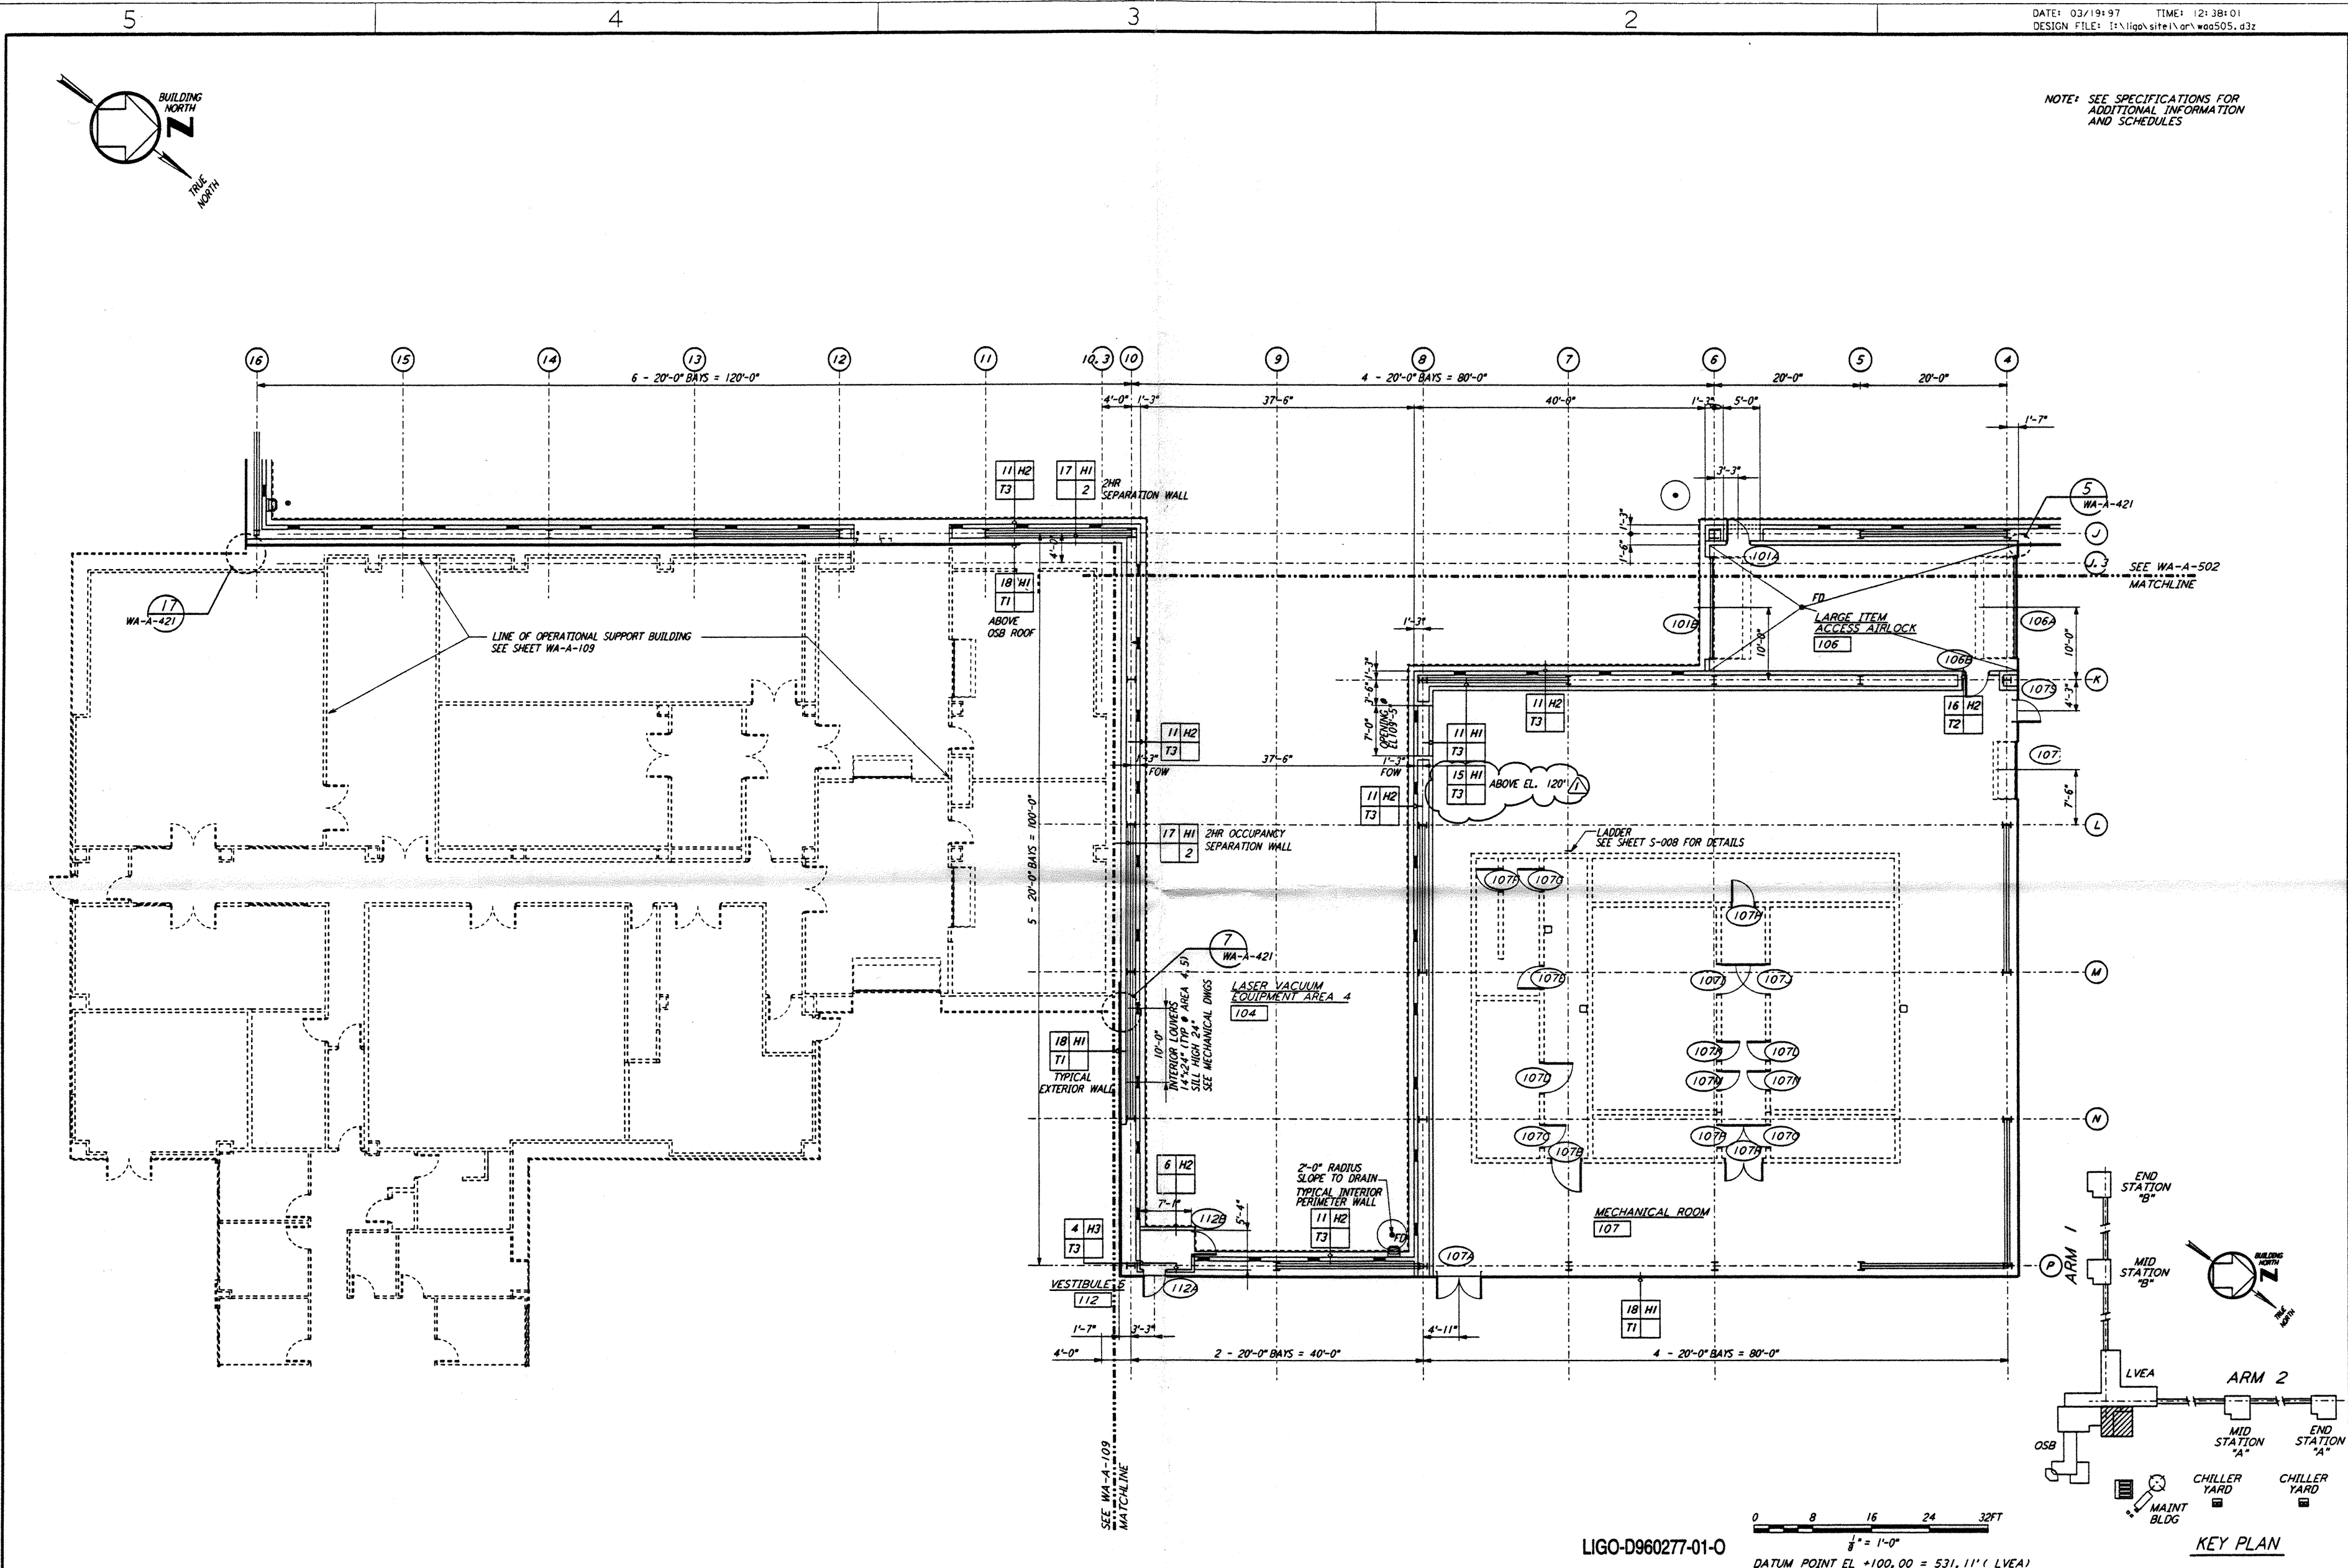


NOTE: SEE SPECIFICATIONS FOR ADDITIONAL INFORMATION AND SCHEDULES

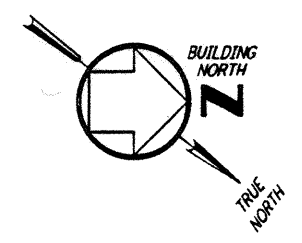

0 8 16 24 32 FT  
 1/4" = 1'-0"  
 DATUM POINT EL +100.00 = 531.11' (LVEA)  
 DATUM POINT EL +100.00 = 531.11' (OSB)

LIGO-D960277-01-0

This document and the design it covers are the property of PARSONS. They are loaned only with the borrower's expressed written agreement that they will not be reproduced, copied, loaned, exhibited, or used in any other way, except by written consent from PARSONS to the borrower.

This document and the design it covers are the property of PARSONS. They are loaned only with the borrower's expressed written agreement that they will not be reproduced, copied, loaned, exhibited, or used in any other way, except by written consent from PARSONS to the borrower.

800 PDP 13 1227/86 1374 53 V.0002 A:\PLOT\SUBFILES\Y\800A\800A.PDF

800 PDP 13 1227/86 1374 53 V.0002 A:\PLOT\SUBFILES\Y\800A\800A.PDF

NO.	DATE	BY	CHKD	ENGR	PROJ	DESCRIPTION
1	2-28-97	CKT	TB	AK	TDM	CORNER STATION VSEA PARTITION

ISSUED FOR CONSTRUCTION	DATE
DRAWN	5-12-96
CHECKED	5-26-96
ENGINEER	7-12-96
PROJ	7-12-96

REGISTERED ARCHITECT  
 JAMES ANDREW WRIGHT  
 STATE OF WASHINGTON  
 4/25/97

**PARSONS**  
 100 WEST WALNUT STREET  
 PASADENA, CALIFORNIA

**LIGO**  
 CALIFORNIA INSTITUTE OF TECHNOLOGY  
 MASSACHUSETTS INSTITUTE OF TECHNOLOGY

LASER INTERFEROMETER  
 GRAVITATIONAL-WAVE OBSERVATORY  
 SITE NO. 1 - HANFORD, WASHINGTON  
 ARCHITECTURAL CORNER STATION LVEA PARTIAL FLOOR PLAN SHEET 4  
 AS NOTED PPI50969 8094  
**WA-A-505**