This document and the design it covers are the property of **PARSONS**. They are loaned only with the borrower's expressed written agreement that they will not be reproduced, copied, loaned, exhibited, or used in any other way, except by written consent from **PARSONS** to the borrower.

DATE: 02/26/97 TIME: 10:08:38
DESIGN FILE: I:\ligo\site\st\was117.dgz

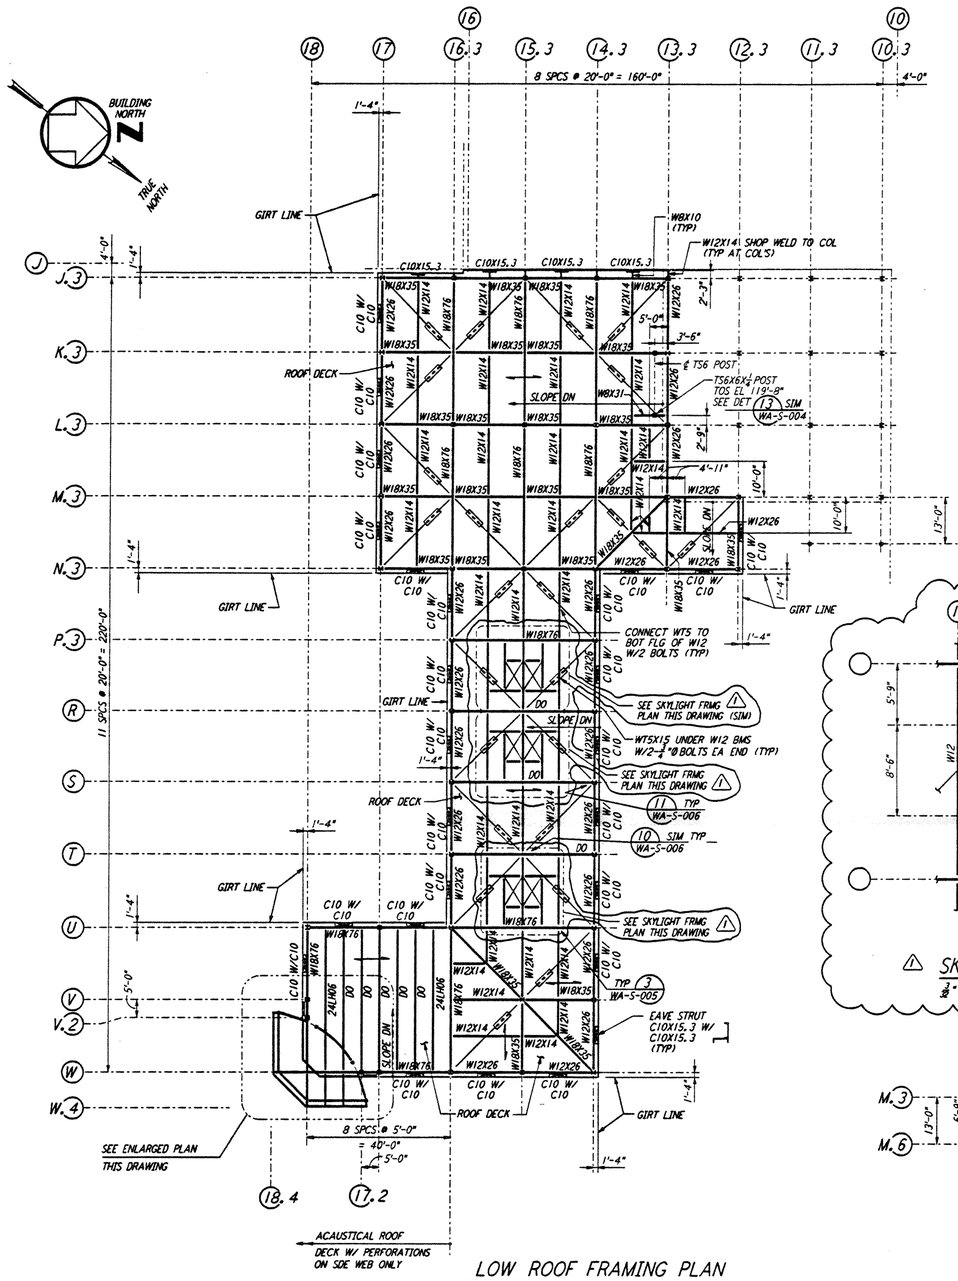

LOW ROOF FRAMING PLAN

1/8" = 1'-0"

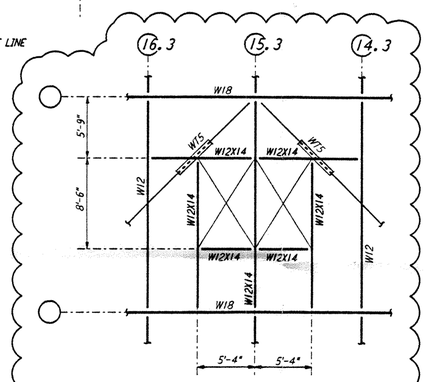

⚠ SKYLIGHT FRAMING PLAN

3/8" = 1'-0"

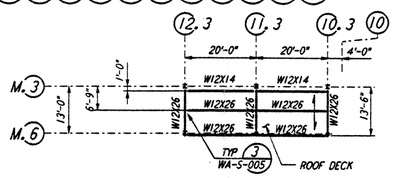

CANOPY FRAMING PLAN

1/8" = 1'-0"

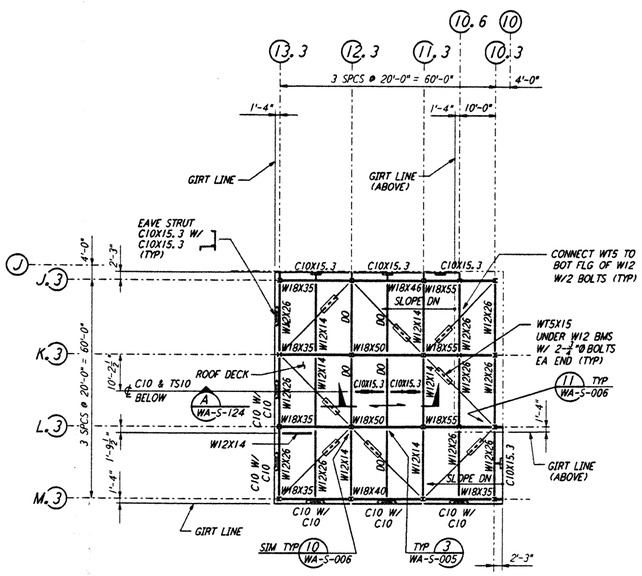

HIGH ROOF FRAMING PLAN

1/8" = 1'-0"

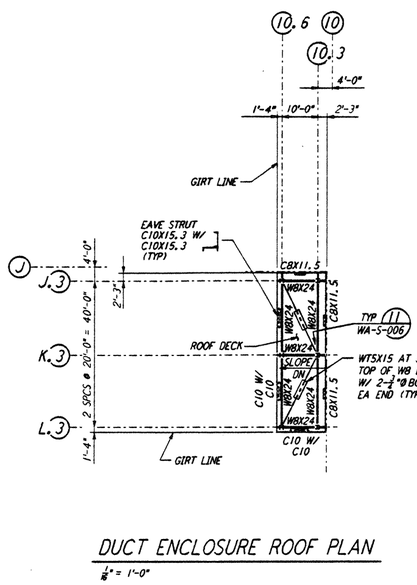

DUCT ENCLOSURE ROOF PLAN

1/8" = 1'-0"

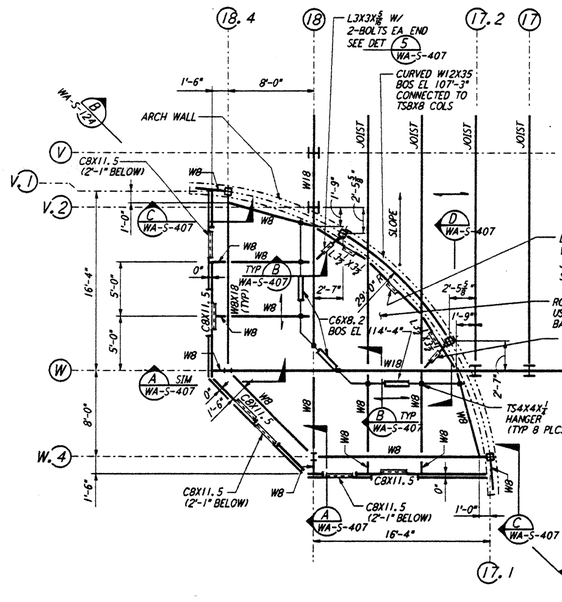

ENLARGED FRAMING PLAN

3/8" = 1'-0"

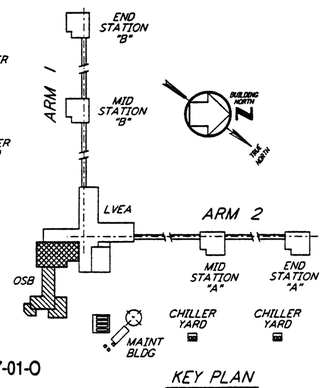

KEY PLAN

NOTE:

1. FOR STRUCTURAL GENERAL NOTES, ABBREVIATIONS AND LEGEND, SEE DWG WA-S-001.

0 8 16 24 32 40 48 56 64FT
3/8" = 1'-0"

LIGO-D960297-01-O

REFERENCES		REVISIONS						
DRAWING NO.	DESCRIPTION	NO.	DATE	BY	CHKD	ENGR	PROJ	DESCRIPTION
		1	2-28-97	RM	AB	AP	[illegible]	ADDED SKYLIGHT FRMG

⚠ ISSUED FOR CONSTRUCTION		
DRAWN	MCS	6-24-96
CHECKED	DDM	6-24-96
ENGINEER	BP	6-24-96
PROJ	TDM	6-24-96

EXPIRES: 10-24-98

PARSONS
100 WEST WALNUT STREET
PASADENA, CALIFORNIA

LIGO
CALIFORNIA INSTITUTE OF TECHNOLOGY
MASSACHUSETTS INSTITUTE OF TECHNOLOGY

LASER INTERFEROMETER
GRAVITATIONAL-WAVE OBSERVATORY
SITE NO. 1 - HANFORD, WASHINGTON

TITLE
STRUCTURAL
CORNER STATION
OSB ROOF FRAMING PLANS

SCALE	CONTRACT NUMBER	PROJECT NUMBER
AS NOTED	PP150969	8094

SHEET NUMBER: WA-S-117 REVISIONS: ⚠1

LIGOWAF.BDR

Wed Feb 26 10:07:19 1997 S:\PROJECTS\LIGO\SVN\SRC\VS11\EPHF
Wed Feb 26 10:07:19 1997 S:\PROJECTS\LIGO\SVN\SRC\VS11\EPHF