DATE: 09/03/98 TIME: 17:18:02
DESIGN FILE: I:\ligo\site1\st\was125.dgz

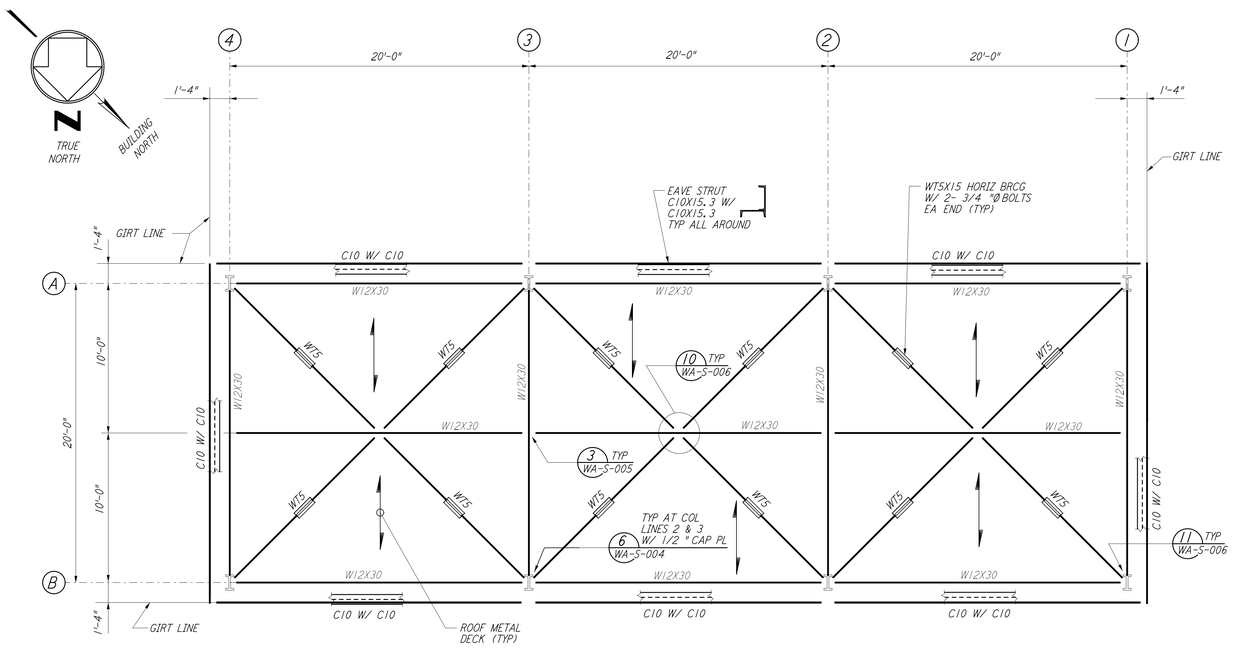

ROOF FRAMING PLAN

1/4" = 1'-0"

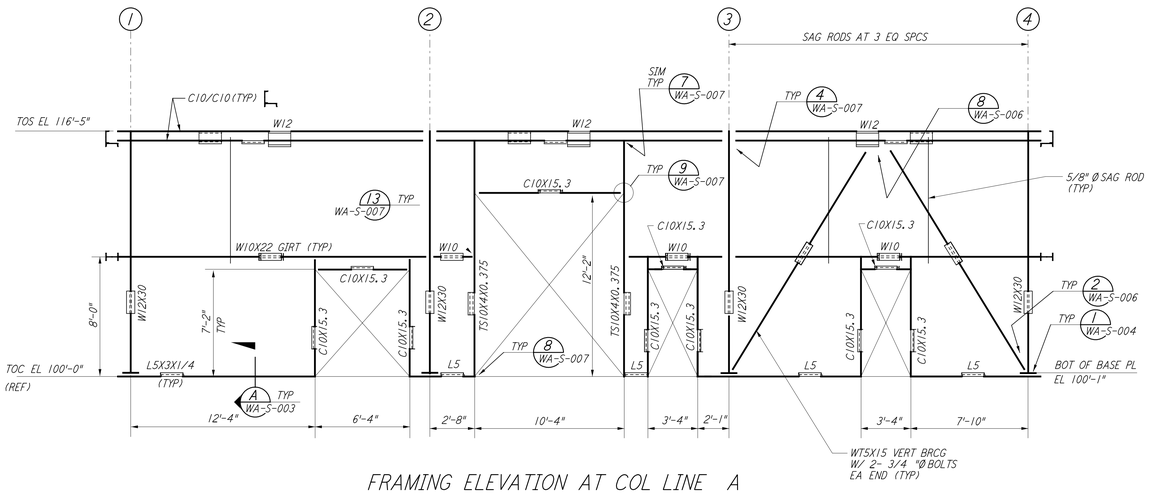

FRAMING ELEVATION AT COL LINE A

1/4" = 1'-0"

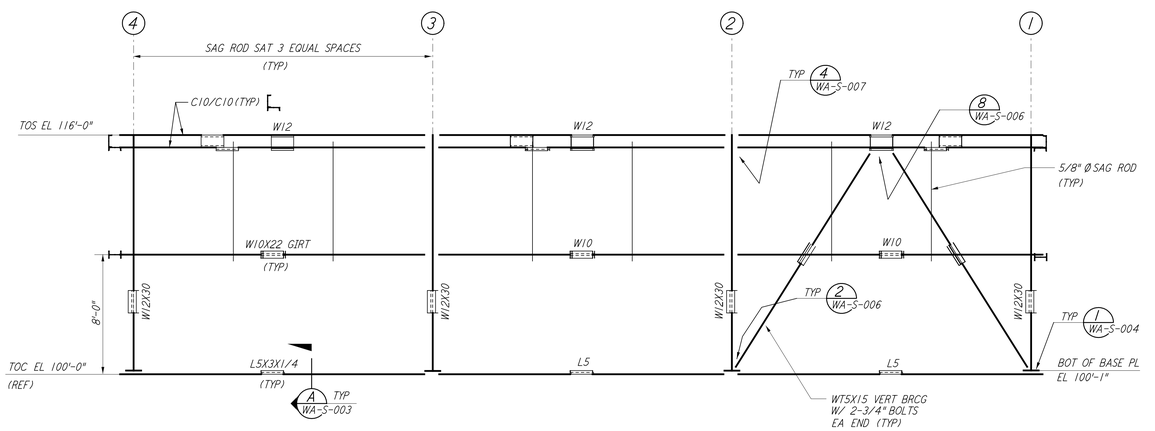

FRAMING ELEVATION AT COL LINE B

1/4" = 1'-0"

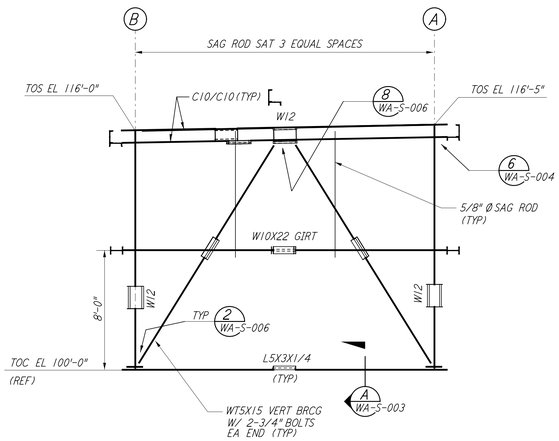

FRAMING ELEVATION AT COL LINE 1

1/4" = 1'-0"

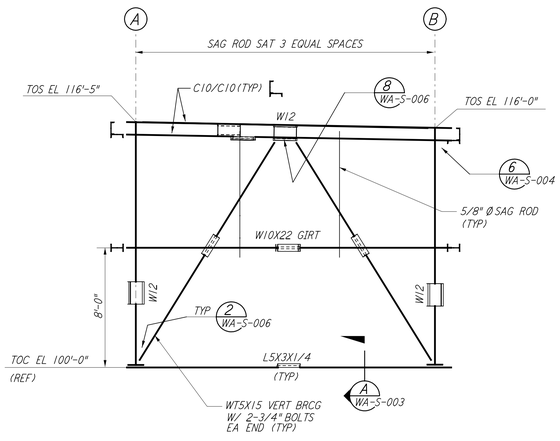

FRAMING ELEVATION AT COL LINE 4

1/4" = 1'-0"

NOTES:

1. FOR GENERAL NOTES, ABBREVIATIONS AND SYMBOLS, SEE DRAWING WA-S-001.
2. FOR CHANNEL, GIRT AND EAVE STRUT CONNECTION DETAILS, SEE DRAWING WA-S-005.

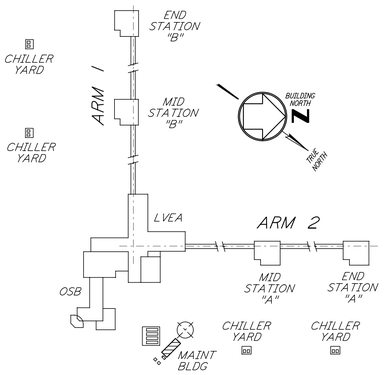

KEY PLAN

LIGO-D960305-01-O

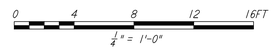

This document and the design it covers are the property of PARSONS. They are loaned only with the borrower's expressed written agreement that they will not be reproduced, copied, loaned, exhibited, or used in any other way, except by written consent from PARSONS to the borrower.

REFERENCES		REVISIONS						
DRAWING NO.	DESCRIPTION	NO.	DATE	BY	CHKD	ENGR	PROJ	DESCRIPTION
		1	6-15-98	CKT				ISSUED FOR AS BUILT

ISSUED FOR CONSTRUCTION		
DRAWN	PK	6-24-96
CHECKED	DDM	7-2-96
ENGINEER	BP	6-18-96
PROJ	MDW	7-9-96

AS-BUILT DRAWINGS

PARSONS
100 WEST WALNUT STREET
PASADENA, CALIFORNIA

LIGO
CALIFORNIA INSTITUTE OF TECHNOLOGY
MASSACHUSETTS INSTITUTE OF TECHNOLOGY

LASER INTERFEROMETER GRAVITATIONAL-WAVE OBSERVATORY
SITE NO. 1 - HANFORD, WASHINGTON

TITLE
STRUCTURAL MAINTENANCE BUILDING FRAMING PLANS AND ELEVATIONS

SCALE	CONTRACT NUMBER	PROJECT NUMBER
AS NOTED	PP150969	8094

SHEET NUMBER **WA-S-125** REVISIONS 1

LIGOWAF.BDR