This document and the design it covers are the property of **PARSONS**. They are loaned only with the borrower's expressed written agreement that they will not be reproduced, copied, loaned, exhibited, or used in any other way, except by written consent from **PARSONS** to the borrower.

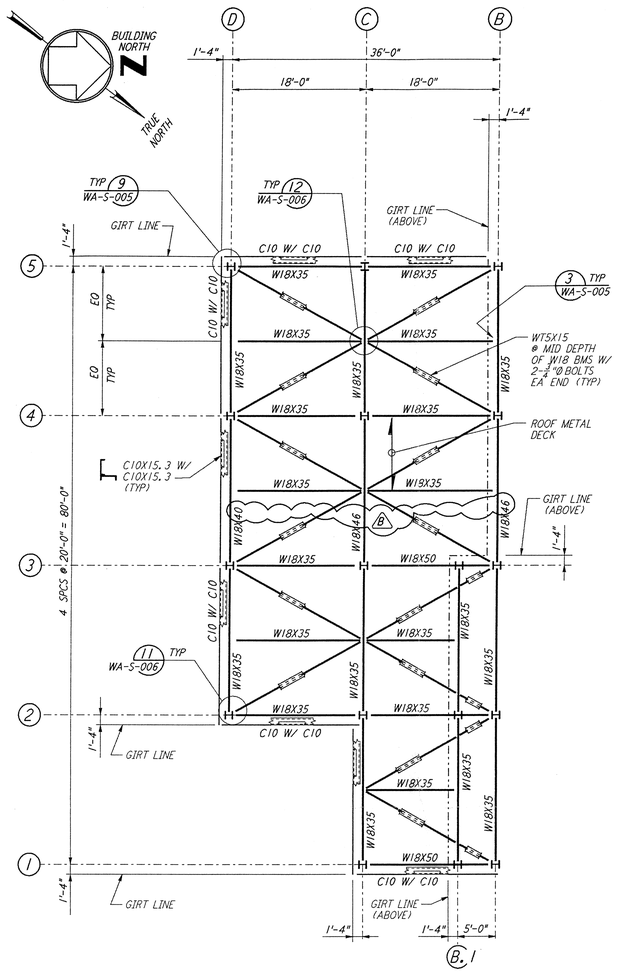

FOR END STATION "B" & MID STATION "B" ON ARM 1 (SOUTHWEST ARM)

LOW ROOF FRAMING PLAN

1/8" = 1'-0"

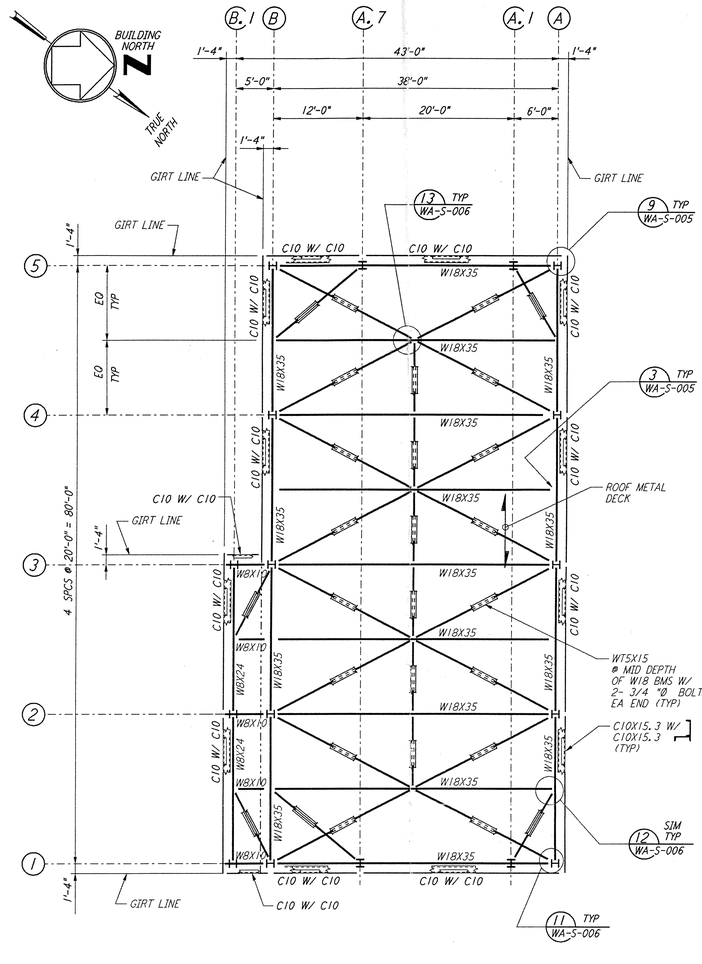

FOR END STATION "B" & MID STATION "B" ON ARM 1 (SOUTHWEST ARM)

HIGH ROOF FRAMING PLAN

1/8" = 1'-0"

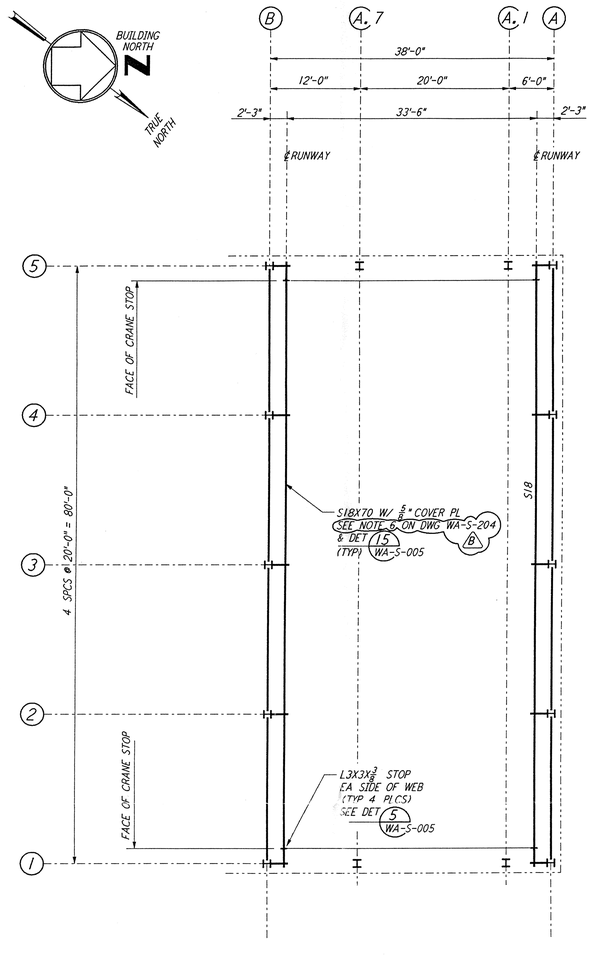

FOR END STATION "B" & MID STATION "B" ON ARM 1 (SOUTHWEST ARM)

CRANE GIRDER FRAMING PLAN

1/8" = 1'-0"

NOTE:

1. FOR NOTES SEE DRAWING WA-S-204.

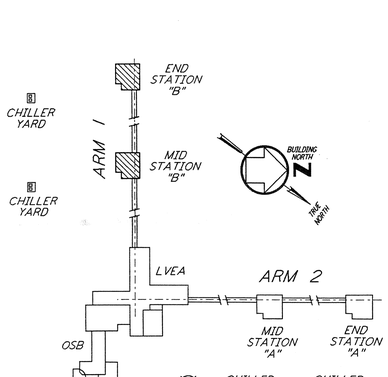

KEY PLAN

0 8 16 24 32FT

1/8" = 1'-0"

LIGO-D960315-B-O

REFERENCES		REVISIONS						
DRAWING NO.	DESCRIPTION	NO.	DATE	BY	CHKD	ENGR	PROJ	DESCRIPTION
		B	5-22-96	MCS	DDM	BP	TDM	BID ADDENDUM #2
		A	4-19-96	MCS	DDM	BP	TDM	FINAL DESIGN REVIEW & BID

DRAWN	MCS
CHECKED	
ENGINEER	
PROJ	

PARSONS
100 WEST WALNUT STREET
PASADENA, CALIFORNIA

LIGO
CALIFORNIA INSTITUTE OF TECHNOLOGY
MASSACHUSETTS INSTITUTE OF TECHNOLOGY

LASER INTERFEROMETER GRAVITATIONAL-WAVE OBSERVATORY
SITE NO. 1 - HANFORD, WASHINGTON

TITLE: STRUCTURAL MID & END STATIONS "B" ROOF & CRANE GIRDER FRAMING PLANS

SCALE	CONTRACT NUMBER	PROJECT NUMBER
AS NOTED	PP150969	8094

SHEET NUMBER: WA-S-209 REVISIONS: B

LIGOWAF.BDR