



FOR END STATION "B" & MID STATION "B" ON ARM 1 (SOUTHWEST ARM)
 LOW ROOF FRAMING PLAN
 $\frac{1}{8}'' = 1'-0''$


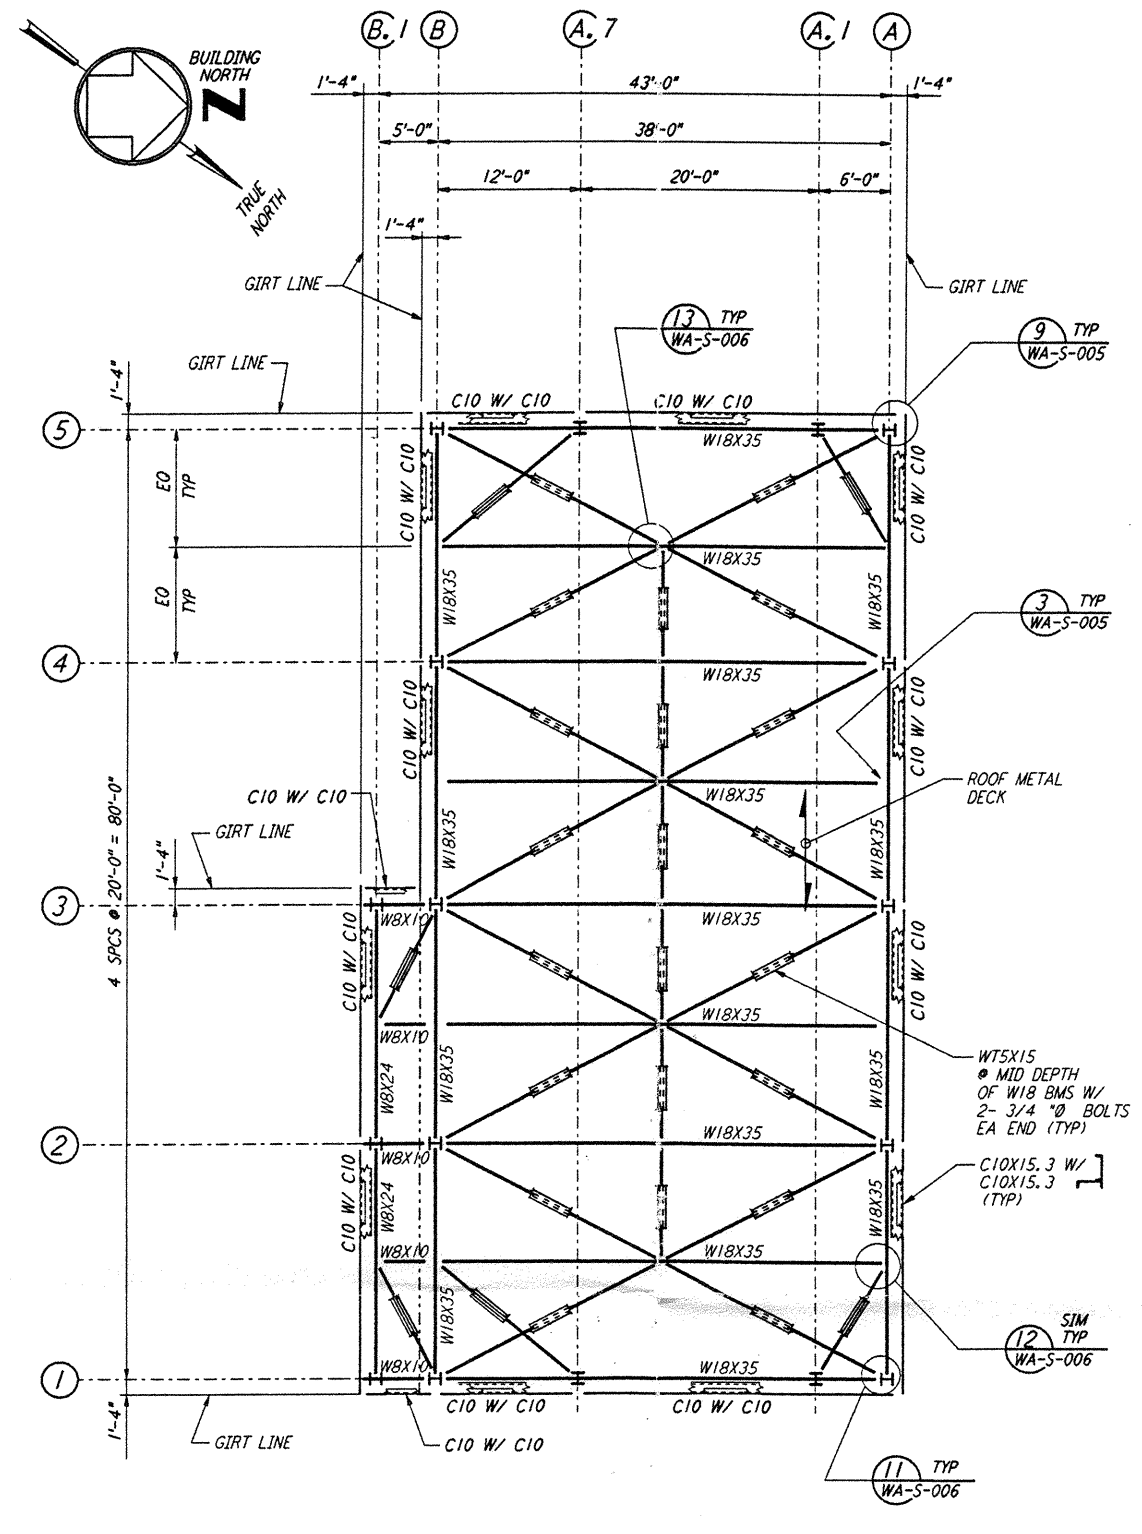


FOR END STATION "B" & MID STATION "B" ON ARM 1 (SOUTHWEST ARM)
 HIGH ROOF FRAMING PLAN
 $\frac{1}{8}'' = 1'-0''$

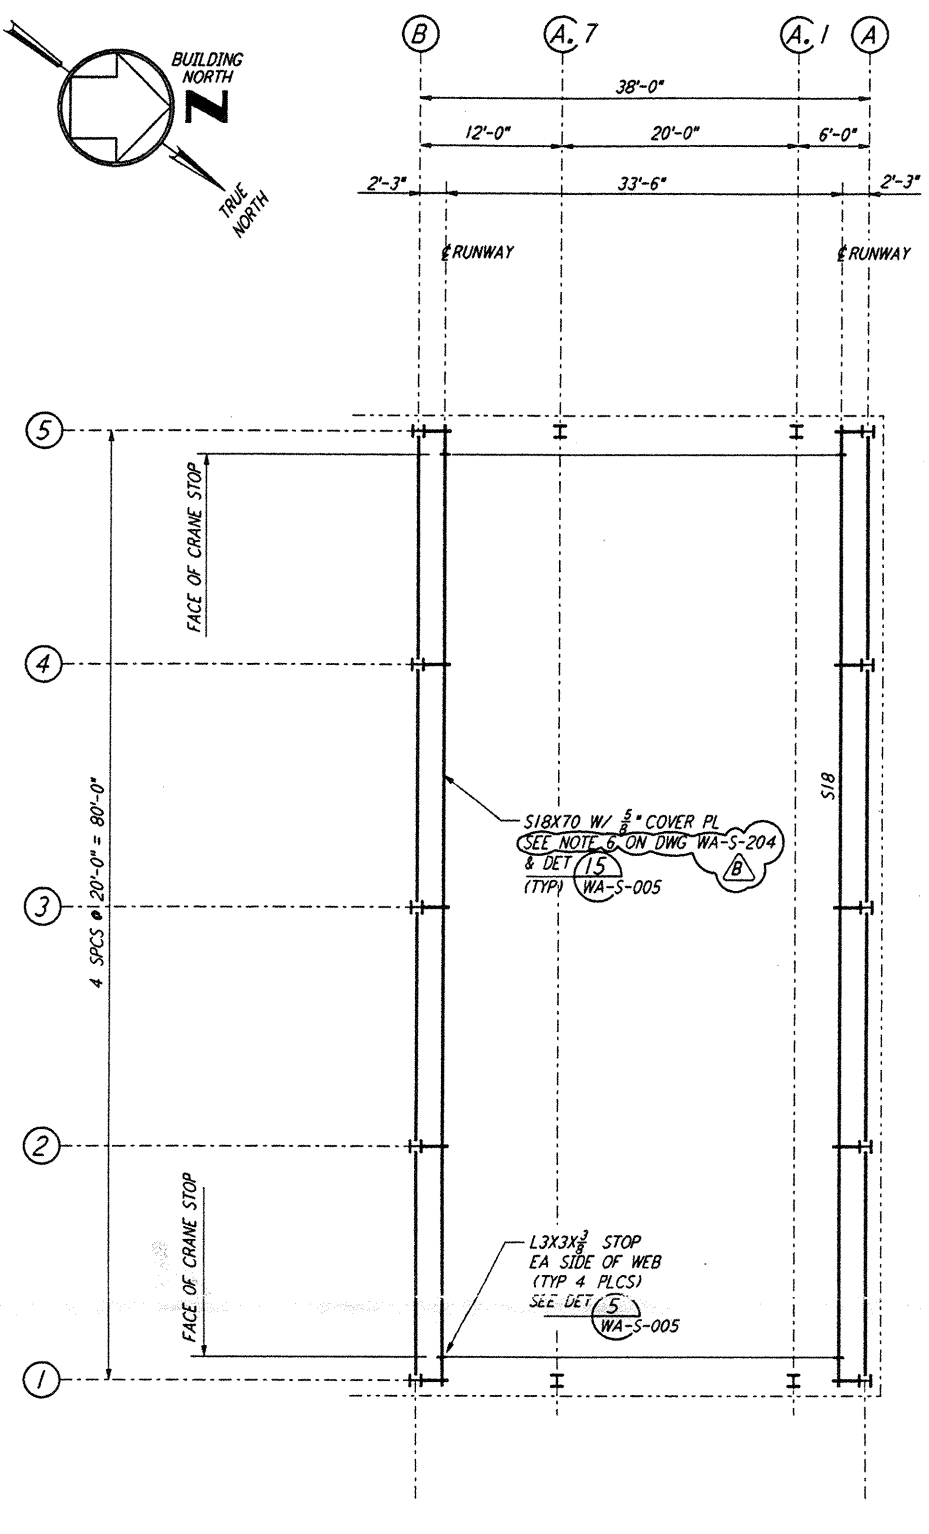

FOR END STATION "B" & MID STATION "B" ON ARM 1 (SOUTHWEST ARM)
 CRANE GIRDER FRAMING PLAN
 $\frac{1}{8}'' = 1'-0''$

NOTE:
 1. FOR NOTES SEE DRAWING WA-5-204.

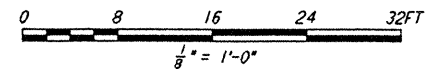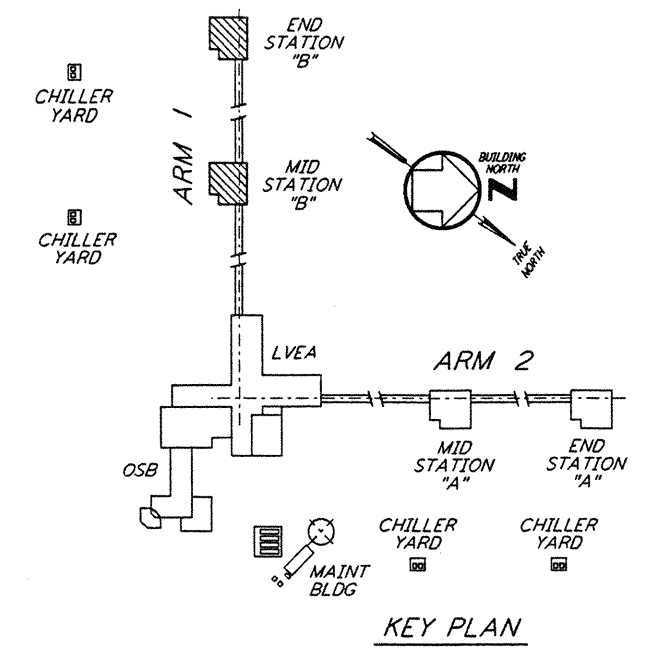

NO.	DATE	BY	CHKD	ENGR	PROJ	DESCRIPTION
B	5-22-96	MCS	DDM	BP	TDM	BID ADDENDUM #2
A	4-19-96	MCS	DDM	BP	TDM	FINAL DESIGN REVIEW & BID

DRAWN	MCS
CHECKED	
ENGINEER	
PROJ	

PARSONS
 100 WEST WALNUT STREET
 PASADENA, CALIFORNIA

LIGO
 CALIFORNIA INSTITUTE OF TECHNOLOGY
 MASSACHUSETTS INSTITUTE OF TECHNOLOGY

LASER INTERFEROMETER
 GRAVITATIONAL-WAVE OBSERVATORY
 SITE NO. 1 - HANFORD, WASHINGTON

TITLE	STRUCTURAL MID & END STATIONS "B" ROOF & CRANE GIRDER FRAMING PLANS	SCALE	AS NOTED	CONTRACT NUMBER	PP150969	PROJECT NUMBER	8094
SHEET NUMBER	WA-S-209	REVISIONS					

This document and the design it covers are the property of PARSONS. They are loaned only with the borrower's expressed written agreement that they will not be reproduced, copied, loaned, exhibited, or used in any other way, except by written consent from PARSONS to the borrower.

PROJ. NO. 20 ESCR013 DTD. 5/17/96. I:\LIGO\SITE\STF\WA-5-209.DGN

PROJ. NO. 20 ESCR013 DTD. 5/17/96. I:\LIGO\SITE\STF\WA-5-209.DGN