DATE: 07/06/98 TIME: 16:27:48
DESIGN FILE: I:\ligo\site1\st\was401.dgz

This document and the design it covers are the property of **PARSONS**. They are loaned only with the borrower's expressed written agreement that they will not be reproduced, copied, loaned, exhibited, or used in any other way, except by written consent from **PARSONS** to the borrower.

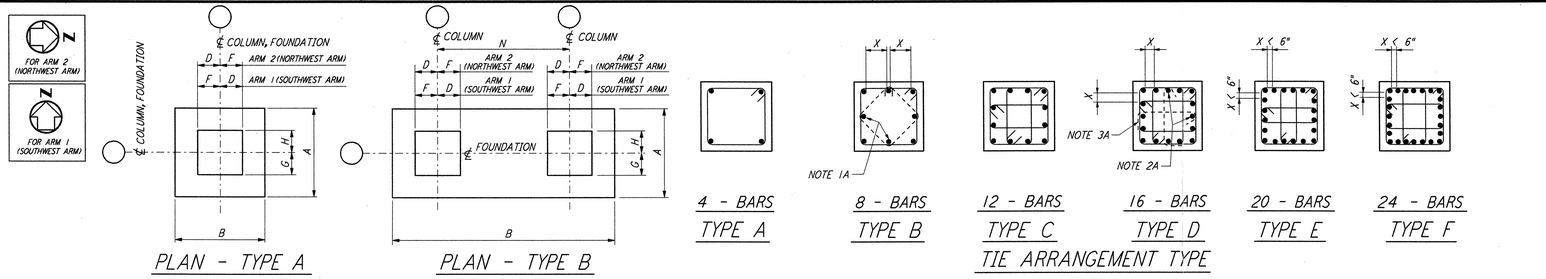

PLAN - TYPE A

PLAN - TYPE B

TIE ARRANGEMENT TYPE

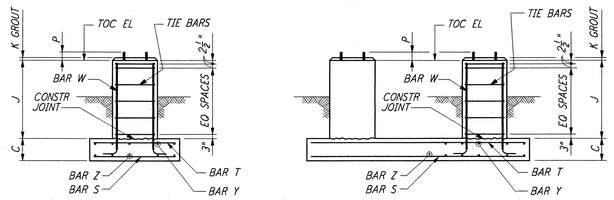

ELEV - TYPE 1

ELEV - TYPE 2

TIE REINFORCEMENT NOTES:

1A. THESE BARS MUST BE TIED AS SHOWN BY DASHED LINES WHEN X DISTANCE IS OVER 6 INCHES.
2A. THESE BARS NEED NOT BE TIED WHEN X DISTANCE IS 6 INCHES OR LESS.
3A. ALTERNATE 90° HOOKS IN COLUMNS.

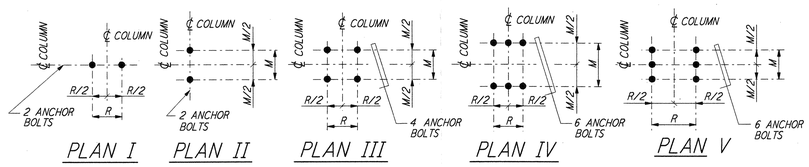

ANCHOR BOLT PLAN

NOTES:

1. CONSTRUCTION SHALL COMPLY WITH ALL THE REQUIREMENTS OF THE GENERAL NOTES ON DRAWING WA-S-001.
2. THE BAR SPACING IS BASED ON CENTER TO CENTER OF TIE SET.
3. FOR ANCHOR BOLT DETAILS SEE DRAWING WA-S-003.
4. FOUNDATION SCHEDULE SHOWN IS FOR ONE (1) BUILDING ONLY. FOUR (4) BUILDINGS REQUIRED.

	FOUNDATION NO. OF FDNS REQD.	FOUNDATION LOCATION	TOP OF CONC EL	FOUNDATION TYPE PLAN	FOUNDATION TYPE ELEV	DIMENSIONS A	B	C	D	F	G	H	J	K	M	R	N	ANCHOR BOLTS PER PIER: ANCHOR BOLT PLAN	TYPE	NO PER PIER	SIZE Ø	L	P	REINFORCING PER FOUNDATION: BAR S NO	SIZE	BAR Z NO	SIZE	BAR T NO	SIZE	BAR Y NO	SIZE	BAR W NO	SIZE	TIE BAR TYPE	SIZE	NO REQD	CONC CY	FDN LOC PLAN	REMARKS
MID & END STATION STRUCTURES (FOR NORTHWEST ARM & SOUTHWEST ARM) SEE NOTE 4	2	C3, C4	100'-0"	A	1	3'-6"	3'-6"	1'-0"	10"	10"	10"	10"	1'-8"	1"	7"	7"	——	III	2	4	1"	1'-4"	4"	5	#4	5	#4	—	—	—	—	8	#5	B	#4	4	1.3	WA-S-201 & WA-S-208	
	1	D4	100'-0"	A	1	5'-0"	5'-0"	1'-0"	10"	10"	1'-3½"	10"	1'-8"	1"	7"	7"	——	III	2	4	1"	1'-4"	4"	7	#4	7	#4	7	#4	7	#4	8	#6	B	#4	4	1.2	WA-S-201 & WA-S-208	
	1	D5	100'-0"	A	1	5'-0"	5'-0"	1'-0"	10"	1'-3½"	1'-3½"	10"	1'-8"	1"	7"	7"	——	III	2	4	1"	1'-4"	4"	7	#4	7	#4	7	#4	7	#4	8	#6	B	#4	4	1.2	WA-S-201 & WA-S-208	
	2	C1, C2	100'-0"	A	1	15'-0"	8'-0"	2'-0"	1'-3½"	12"	1'-3½"	12"	4'-0"	1"	7"	7"	——	III	2	4	1"	1'-4"	4"	18	#6	10	#6	18	#6	10	#6	8	#7	B	#4	6	9.7	WA-S-201 & WA-S-208	
	1	C5	100'-0"	A	1	15'-0"	8'-0"	2'-0"	12"	1'-3½"	12"	12"	4'-0"	1"	7"	7"	——	III	2	4	1"	1'-4"	4"	18	#6	10	#6	18	#6	10	#6	8	#6	B	#4	6	9.7	WA-S-201 & WA-S-208	
	1	D2	100'-0"	B	2	6'-0"	26'-0"	2'-0"	1'-3½"	12"	1'- 3½"	12"	1'-8"	1"	7"	7"	20'-0"	III	2	4	1"	1'-4"	4"	8	#6	31	#6	8	#6	31	#6	8	#7	B	#4	4	12.2	WA-S-201 & WA-S-208	
		D3	100'-0"						12"	12"	1'-3½"	12"	1'-8"	1"	7"	7"		III	2	4	1"	1'-4"	4"									8	#6	B	#4	4			
	—	A2, A3, B1, B2, B3, B5	100'-0"	—	—	—	—	—	—	—	—	—	—	1"	7"	7"	—	III	2	4	1"	1'-4"	4"	—	—	—	—	—	—	—	—	—	—	—	—	—	—	WA-S-201 & WA-S-208	FOR ANCHOR BOLTS ONLY
	—	A1, A4, A5, B4	100'-0"	—	—	—	—	—	—	—	—	—	—	1"	7"	7"	—	III	1	4	1"	1'-4"	4"	—	—	—	—	—	—	—	—	—	—	—	—	—	—	WA-S-201 & WA-S-208	FOR ANCHOR BOLTS ONLY
		A.1-1; A.1-5																																				SAME AS C3
		A.7-1; A.7-5																																				SAME AS C3

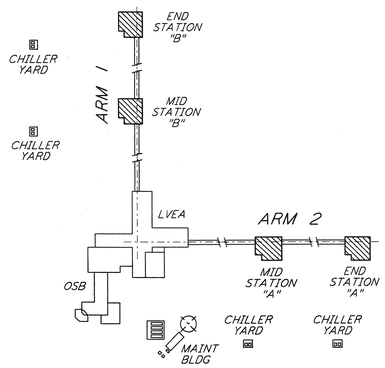

KEY PLAN

LIGO-D960316-01-O

REFERENCES DRAWING NO.	DESCRIPTION

REVISIONS NO.	DATE	BY	CHKD	ENGR	PROJ	DESCRIPTION
1	6-15-98	CKT	BP	BP	PP	ISSUED FOR AS-BUILT

ISSUED FOR CONSTRUCTION		
DRAWN	MCS	6-24-96
CHECKED	DDM	7-2-96
ENGINEER	BP	6-28-96
PROJ	MDW	7-9-96

AS-BUILT DRAWINGS

PARSONS
100 WEST WALNUT STREET
PASADENA, CALIFORNIA

LIGO
CALIFORNIA INSTITUTE OF TECHNOLOGY
MASSACHUSETTS INSTITUTE OF TECHNOLOGY

LASER INTERFEROMETER GRAVITATIONAL-WAVE OBSERVATORY
SITE NO. 1 - HANFORD, WASHINGTON

TITLE: STRUCTURAL MID AND END STATION FOUNDATION SCHEDULE AND DETAILS

SCALE	CONTRACT NUMBER	PROJECT NUMBER
NONE	PP150969	8094

SHEET NUMBER: WA-S-401 REVISIONS: 1

LIGOWAF.BDR

Mon Jul 06 16:27:25 1998 C:\PLOTJOUE\S3-V3682.OCF 52085 K:\V3682\sx401.prf