


This document and the design it covers are the property of PARSONS. They are loaned only with the borrower's expressed written agreement that they will not be reproduced, copied, loaned, exhibited, or used in any other way, except by written consent from PARSONS to the borrower.

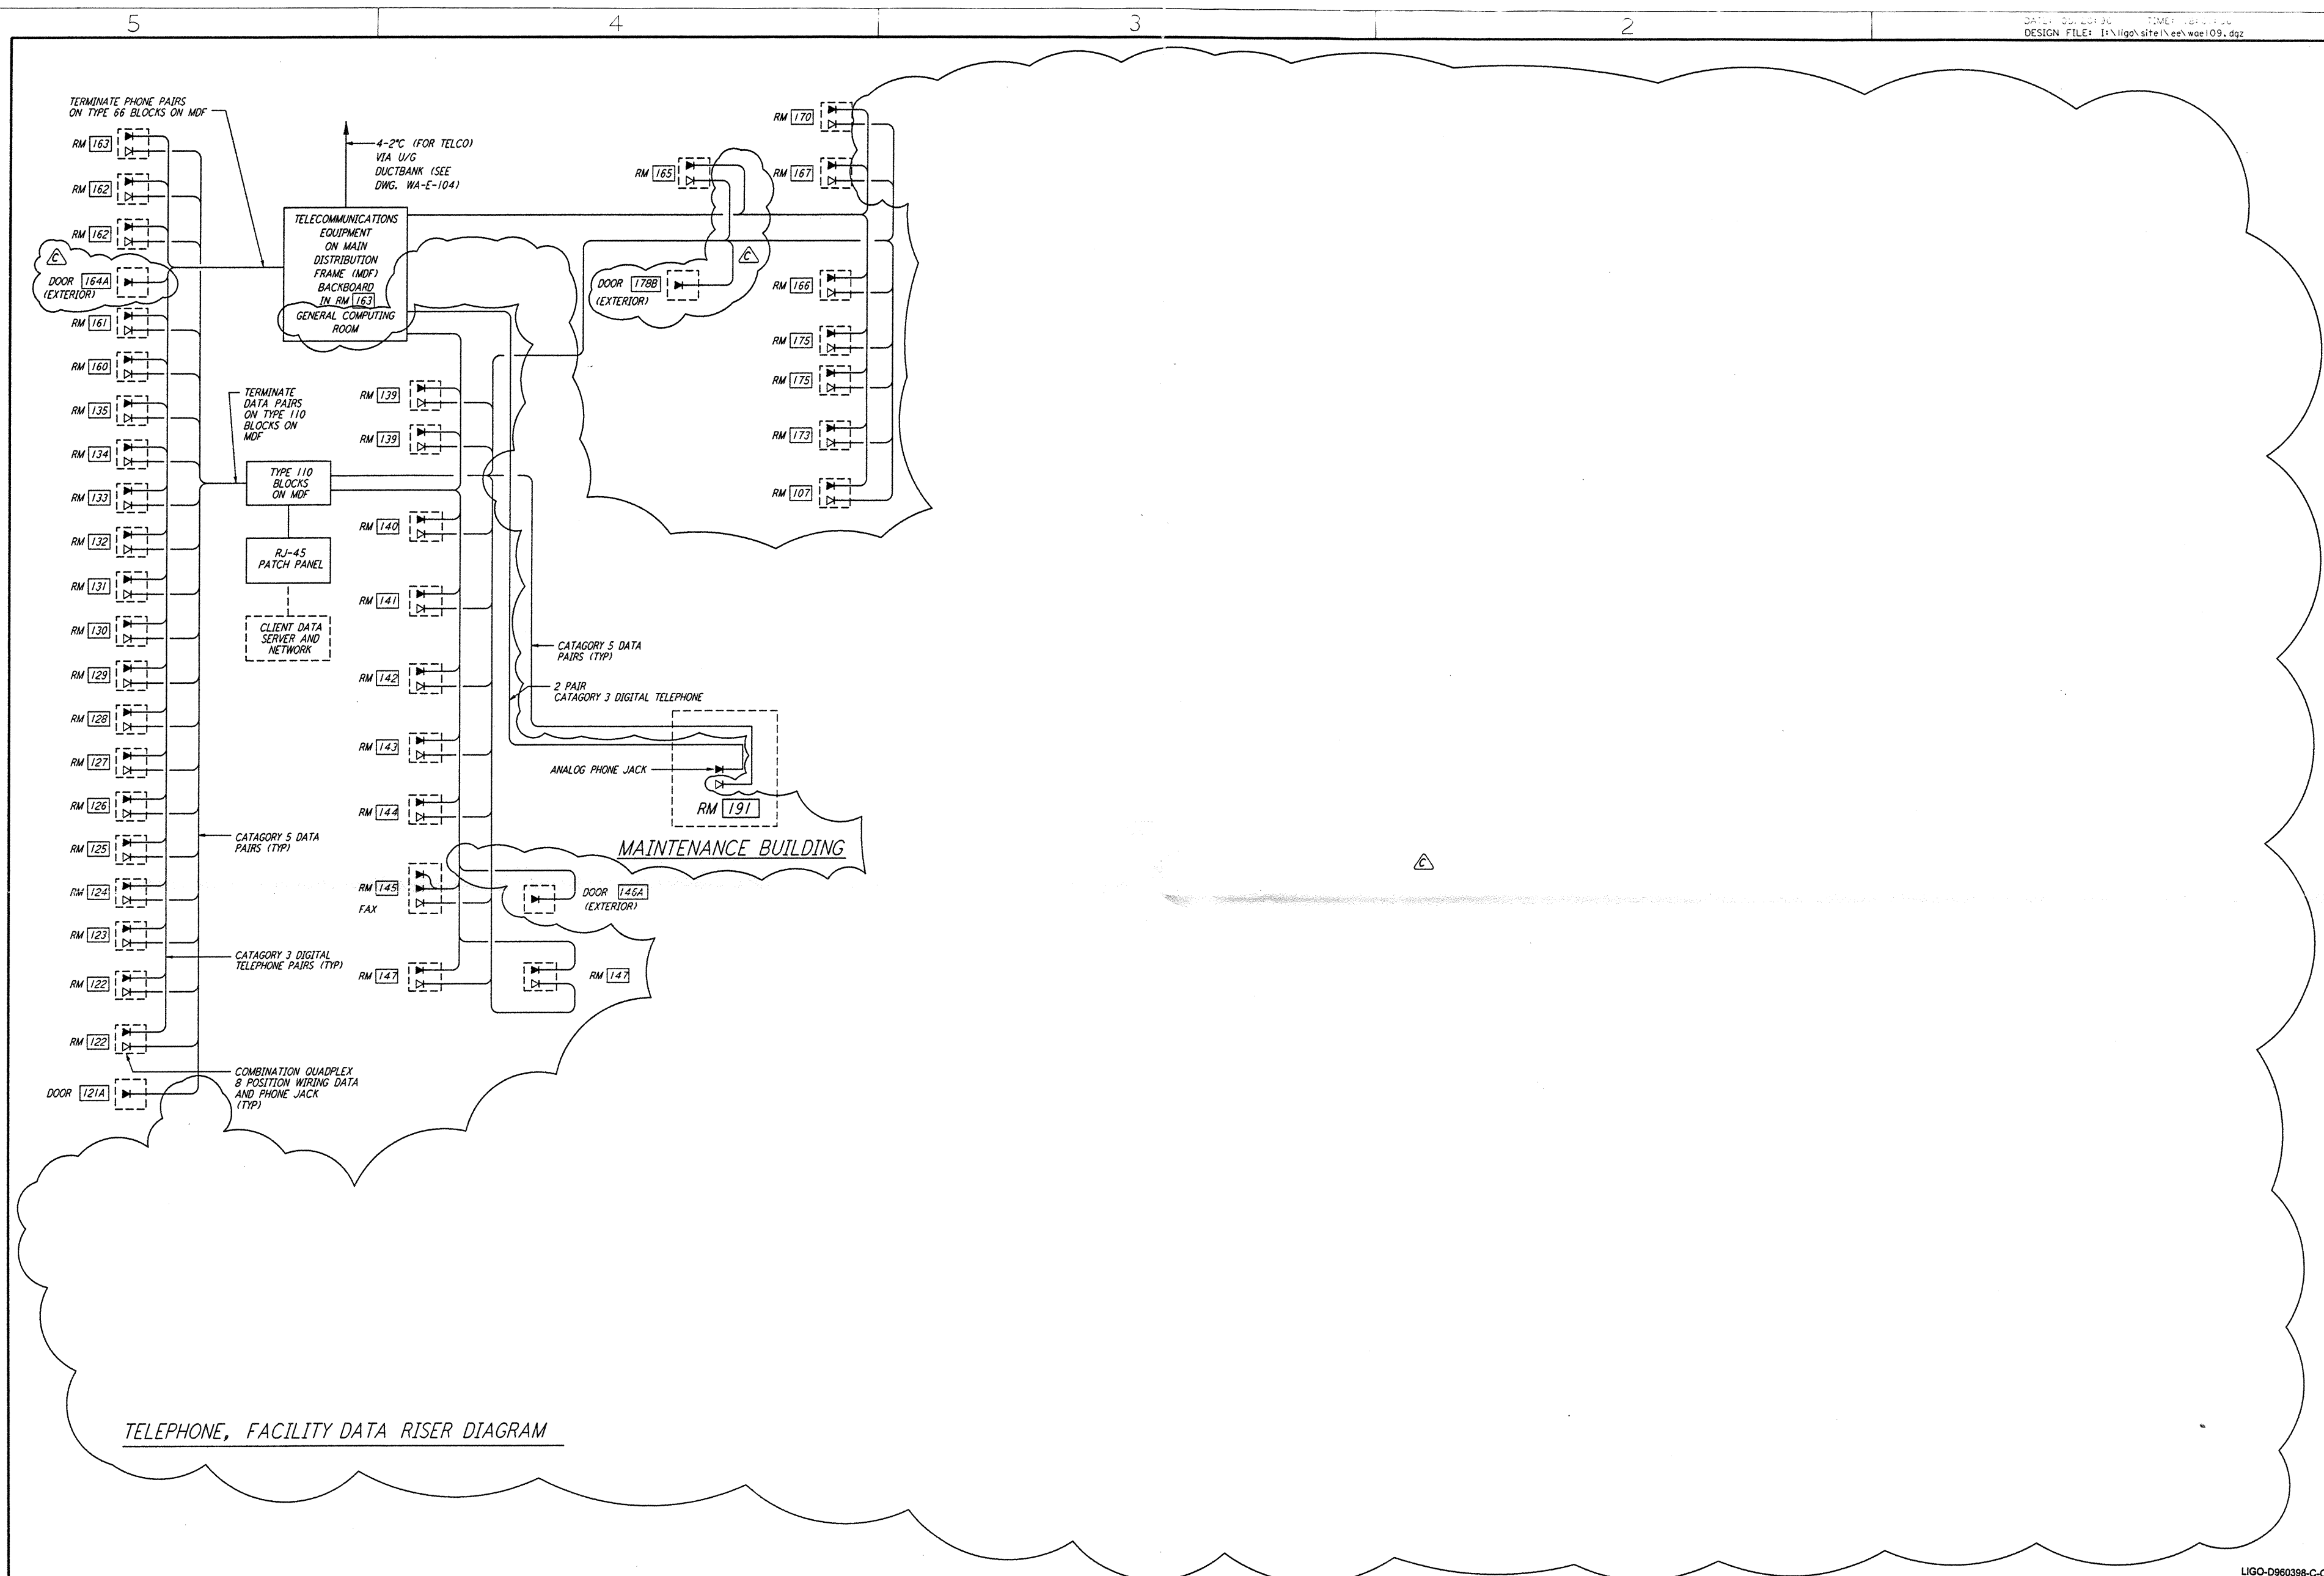

TELEPHONE, FACILITY DATA RISER DIAGRAM

 </table>	NO.	DATE	BY	CHKD	ENGR	PROJ	DESCRIPTION	C	5-22-96	JAC	JAC	JAC	JAC	BID ADDENDUM #2	B	4-19-96	JAC	JAC	JAC	JAC	FINAL DESIGN REVIEW & BID	A	10-31-95	JAC	JAC	JAC	JAC	PRELIMINARY DESIGN REVIEW	<p>REVISIONS</p> <table border="1" style="width: 100%; border-collapse: collapse;"> <tr> <th>NO.</th> <th>DATE</th> <th>BY</th> <th>CHKD</th> <th>ENGR</th> <th>PROJ</th> <th>DESCRIPTION</th> </tr> <tr> <td>C</td> <td>5-22-96</td> <td>JAC</td> <td>JAC</td> <td>JAC</td> <td>JAC</td> <td>BID ADDENDUM #2</td> </tr> <tr> <td>B</td> <td>4-19-96</td> <td>JAC</td> <td>JAC</td> <td>JAC</td> <td>JAC</td> <td>FINAL DESIGN REVIEW &amp; BID</td> </tr> <tr> <td>A</td> <td>10-31-95</td> <td>JAC</td> <td>JAC</td> <td>JAC</td> <td>JAC</td> <td>PRELIMINARY DESIGN REVIEW</td> </tr> </table>	NO.	DATE	BY	CHKD	ENGR	PROJ	DESCRIPTION	C	5-22-96	JAC	JAC	JAC	JAC	BID ADDENDUM #2	B	4-19-96	JAC	JAC	JAC	JAC	FINAL DESIGN REVIEW & BID	A	10-31-95	JAC	JAC	JAC	JAC	PRELIMINARY DESIGN REVIEW	<p>DRAWN: J. G.</p> <p>CHECKED:</p> <p>ENGINEER:</p> <p>PROJ:</p>	<p>100 WEST WALNUT STREET PASADENA, CALIFORNIA</p>	<p>CALIFORNIA INSTITUTE OF TECHNOLOGY MASSACHUSETTS INSTITUTE OF TECHNOLOGY</p>	<p>LASER INTERFEROMETER GRAVITATIONAL-WAVE OBSERVATORY SITE NO. 1 - HANFORD, WASHINGTON</p> <p>ELECTRICAL CORNER STATION COMMUNICATIONS RISER DIAGRAM</p> <p>SCALE: NONE</p> <p>CONTRACT NUMBER: PPI 50969</p> <p>PROJECT NUMBER: 8094</p> <p>SHEET NUMBER: <b>WA-E-109</b></p>

LIGO-D960398-C-0