DATE: 06/02/98 TIME: 17:36:50
DESIGN FILE: I:\ligo\site1\mu\wap131.sez

This document and the design it covers are the property of **PARSONS**. They are loaned only with the borrower's expressed written agreement that they will not be reproduced, copied, loaned, exhibited, or used in any other way, except by written consent from **PARSONS** to the borrower.

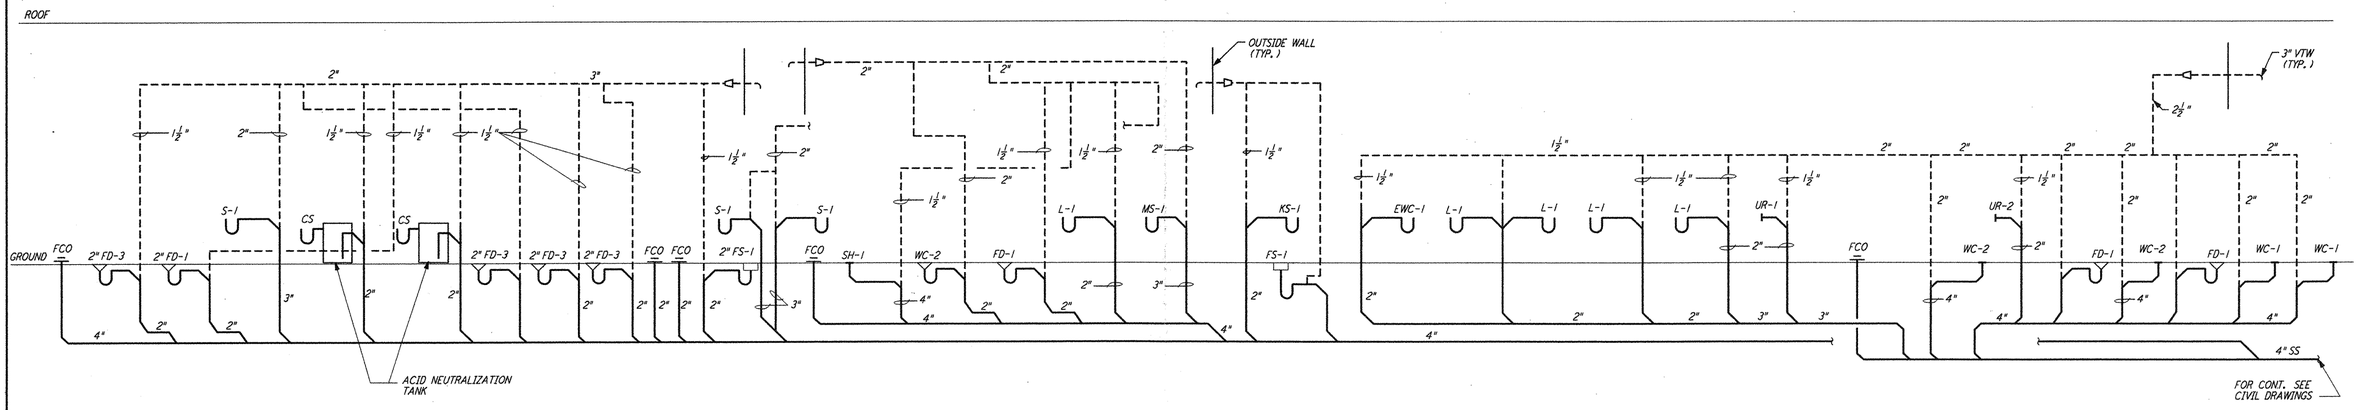

WASTE AND VENT RISER DIAGRAM

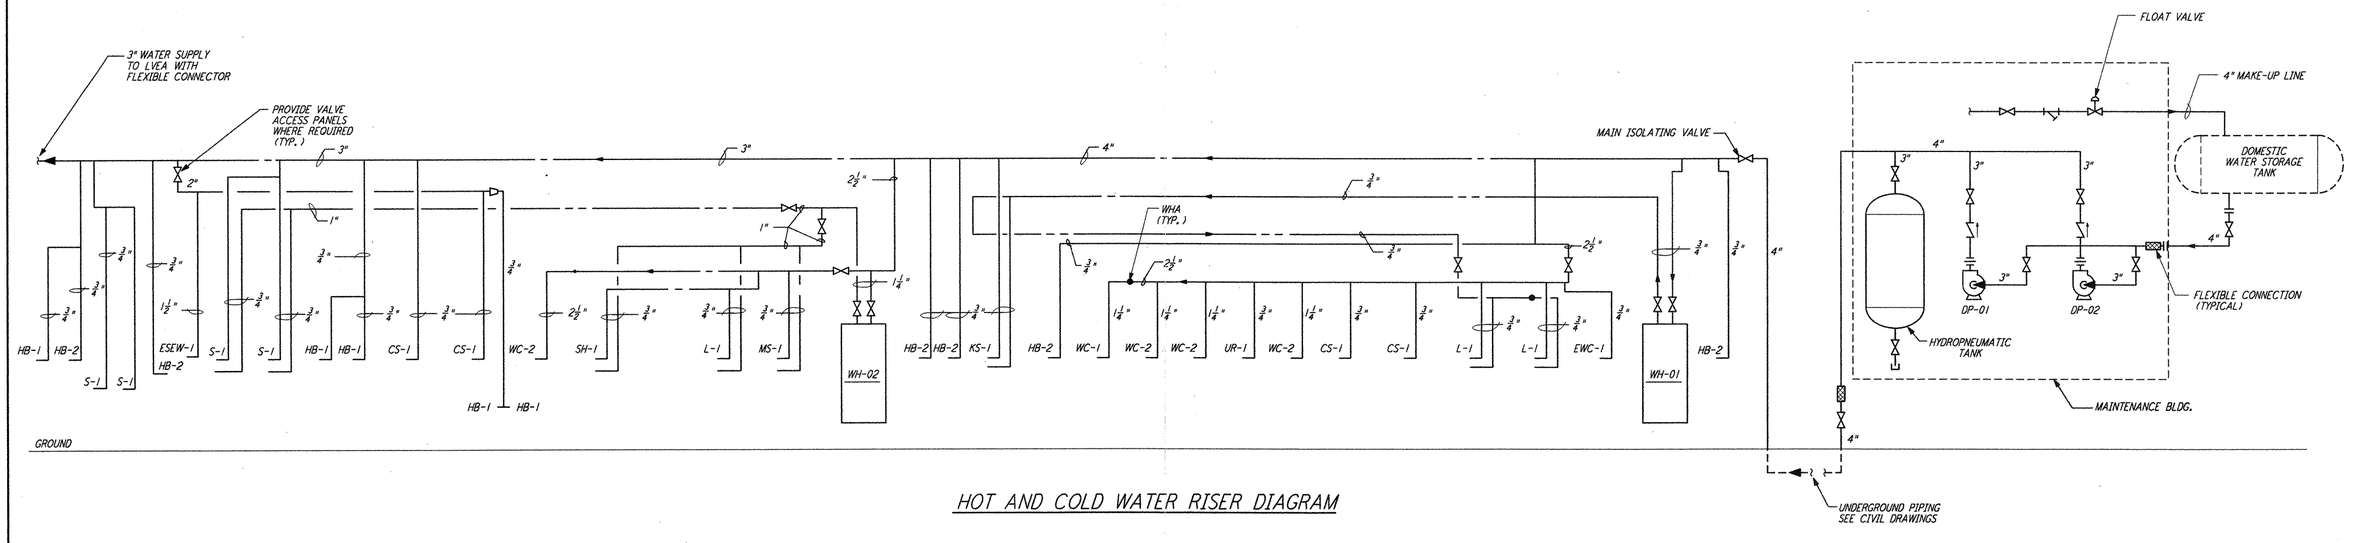

HOT AND COLD WATER RISER DIAGRAM

LIGO-D960443-02-O

REFERENCES		REVISIONS						
DRAWING NO.	DESCRIPTION	NO.	DATE	BY	CHKD	ENGR	PROJ	DESCRIPTION
		2	5-15-98	CP	AA	AA		ISSUED FOR AS-BUILT
		1	3-20-97	WNK	AA	AA	TDM	REVISED RISER DIAGRAMS

ISSUED FOR CONSTRUCTION		
DRAWN	DG	6-24-96
CHECKED	W.R.	7/19/96
ENGINEER	MN	7/19/96
PROJ	MDW	7/19/96

AS-BUILT DRAWINGS

PARSONS
100 WEST WALNUT STREET
PASADENA, CALIFORNIA

LIGO
CALIFORNIA INSTITUTE OF TECHNOLOGY
MASSACHUSETTS INSTITUTE OF TECHNOLOGY

LASER INTERFEROMETER GRAVITATIONAL-WAVE OBSERVATORY
SITE NO. 1 - HANFORD, WASHINGTON

TITLE: PLUMBING CORNER STATION RISER DIAGRAM

SCALE	CONTRACT NUMBER	PROJECT NUMBER
NONE	PP150969	8094

SHEET NUMBER: WA-P-131 REVISIONS: 2

LIGOWAF.BDR

Tue Jun 02 17:36:29 1998 G:\PLOT\DES\S3-V3682.DGF 52885 K:\V3682\mu131.prf