This document and the design it covers are the property of **PARSONS**. They are loaned only with the borrower's expressed written agreement that they will not be reproduced, copied, loaned, exhibited, or used in any other way, except by written consent from **PARSONS** to the borrower.

NOTES:

1. SEE SHEET BT-C-002 FOR GENERAL NOTES, LEGEND AND ABBREVIATIONS.

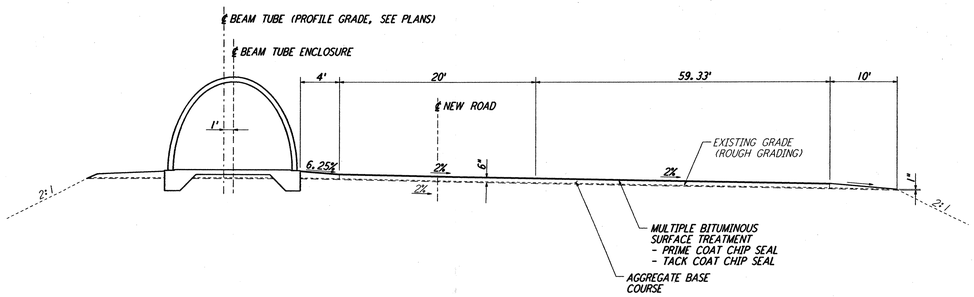

SECTION (A / BT-C-052) NOT TO SCALE

REF
BT-C-013
BT-C-017
BT-C-018
BT-C-033
BT-C-037
BT-C-038

(● TURNAROUNDS ALONG NORTHWEST AND SOUTHWEST ARMS)

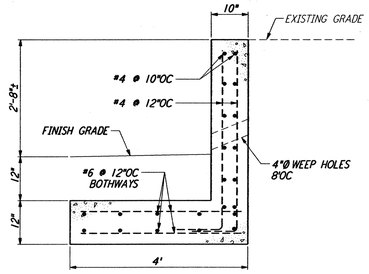

RETAINING WALL (I / BT-C-052) NOT TO SCALE

REF
BT-C-046

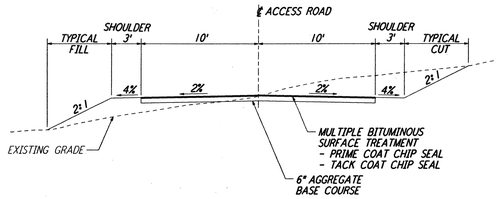

ACCESS ROAD (B / BT-C-052) NOT TO SCALE

REF
BT-C-021/022
BT-C-025/026
BT-C-041/042
BT-C-045/046

(ACCESS ROAD FROM MID/END STATION TO CHILLER YARD PAD)

LIGO-D960734-00-O

REFERENCES		REVISIONS						
		0	1-22-99	MEI	--	--	MDW	ISSUED FOR AS BUILT
		A	4-19-96	WRB	TDM		MDW	CHANGE ORDER NO. 4
DRAWING NO.	DESCRIPTION	NO.	DATE	BY	CHKD	ENGR	PROJ	DESCRIPTION

0	
DRAWN	WRB
CHECKED	
ENGINEER	
PROJ	

AS-BUILT DRAWINGS

PARSONS
100 WEST WALNUT STREET
PASADENA, CALIFORNIA

LIGO
CALIFORNIA INSTITUTE OF TECHNOLOGY
MASSACHUSETTS INSTITUTE OF TECHNOLOGY

LASER INTERFEROMETER
GRAVITATIONAL-WAVE OBSERVATORY
BTE SITEWORK & FABRICATION - HANFORD, WA

TITLE: CIVIL GRADING SECTIONS & DETAILS

SCALE	CONTRACT NUMBER	PROJECT NUMBER
AS NOTED	PP150969	8094

SHEET NUMBER: BT-C-052 REVISIONS: 0

LIGOBTF3.BDR

Thu Jan 21 14:54:42 1999 C:\PLOT\DUE\S3-V3682\ce052a.prf