


PROJECT NAME:
PSI DOC. NO.

CHK	BY / DATE
PROJECT ENG.	
MECHANICAL	
STRESS	
ELECTRICAL	
PROCESS	
MFG. ENG.	
MANUF.	
O.A.	
DRAFTING	

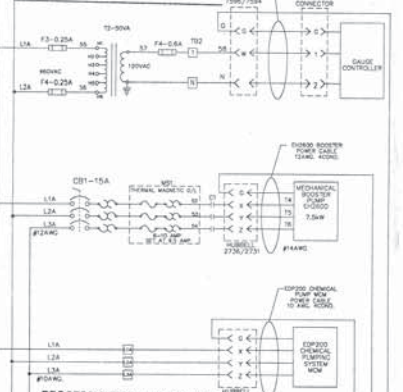

**PROCESS SYSTEMS INTERNATIONAL
DOCUMENT APPROVAL CHECKLIST**

PROJECT NAME: LIGO
 PSI DOC. NO. V049-8-331
 NOTE: THIS REVIEW DOES NOT RELEASE THE SELLER OR CONTRACTOR OF ANY OBLIGATIONS UNDER THE E.O. CONTRACT.

- FA = FINAL APPROVAL
- AS = APPROVED AS NOTED - REVISE & RESUBMIT
- RF = APPROVED FOR FABRICATION
- NA = NOT APPROVED
- RP = RELEASED FOR PROCUREMENT OF MATERIALS ONLY
- RR = REVISE & RESUBMIT

CUSTOMER SUPPLY: NOVAC/DRY/DRY
 DATE: _____
 VENDOR NAME: Edwards High Vac
 REVISION NO.: _____
 SUBJECT NO.: _____
 STATUS: Review/Approval
 PSI DOC. NO. V049-8-331
 LIGO-DSK0798-03-V MAY 31 1999

No.	Revision	Date	By	Appr.	Rev. Changes
Drawn	YS	Date	05-16-95		
Checked	DW	Date			
Approved	DW	Date			
Rev. No.					
Customer					

EDWARDS HIGH VACUUM INTERNATIONAL
 A Division of the EDC Group, Inc.

EDWARDS HIGH VACUUM INTERNATIONAL
 MAIN ELECTRICAL CONTROLLER
 EDP200/EH2600 COMBINATION WITH
 INLET GATE VALVE AND ACCESSORIES

Order No. NGB050110
 P.S.I.

**PRELIMINARY
SUBJECT TO CHANGE**