DATE: 10/06/98 TIME: 10:51:08
DESIGN FILE: I:\ligo\site2\ce\lac006.dgz

This document and the design it covers are the property of PARSONS. They are loaned only with the borrower's expressed written agreement that they will not be reproduced, copied, loaned, exhibited, or used in any other way, except by written consent from PARSONS to the borrower.

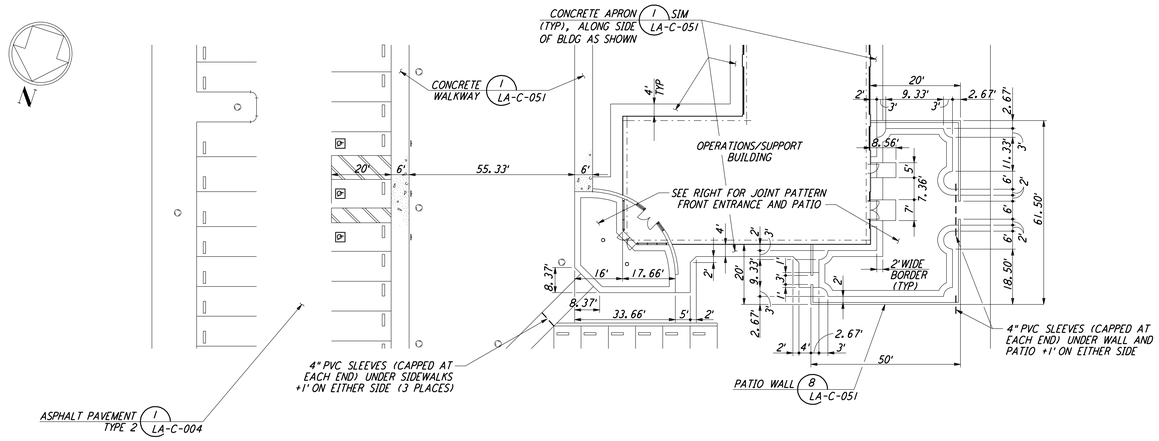

ENLARGED AREA - BUILDING ENTRANCE
SCALE: 1" = 20'

NOTES:

1. SEE SHEET LA-C-002 FOR GENERAL NOTES, LEGEND AND ABBREVIATIONS.
2. SEE SHEET LA-C-005 FOR CURVE DATA.

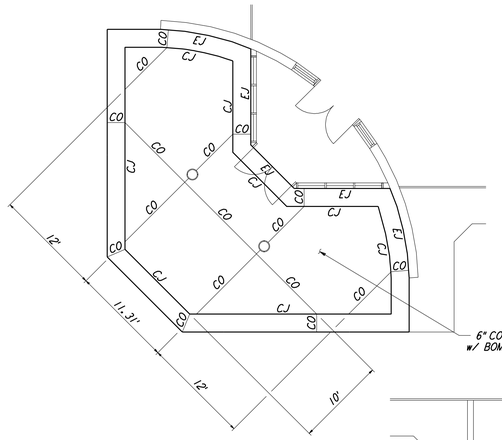

JOINT PATTERN - FRONT ENTRANCE

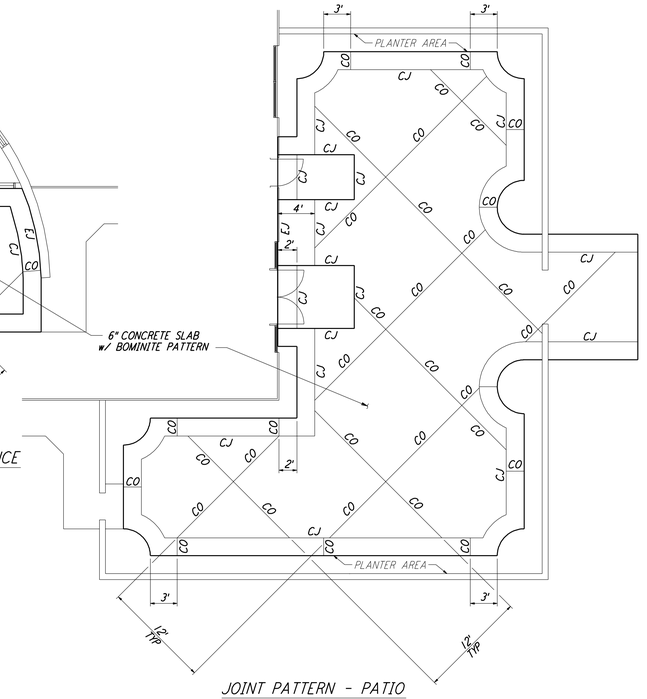

JOINT PATTERN - PATIO

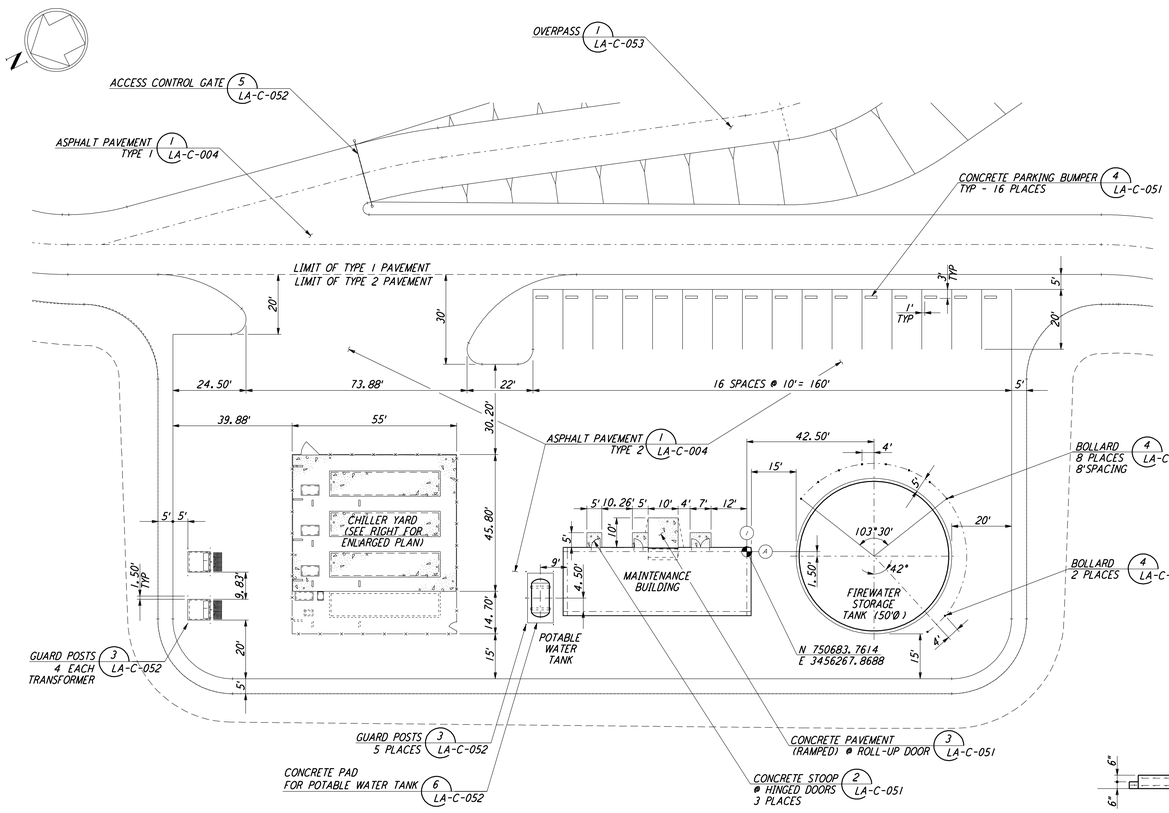

ENLARGED AREA - MAINTENANCE YARD
SCALE: 1" = 20'

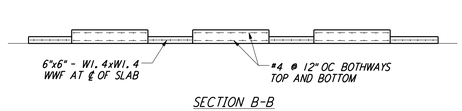

SECTION B-B

SECTION A-A

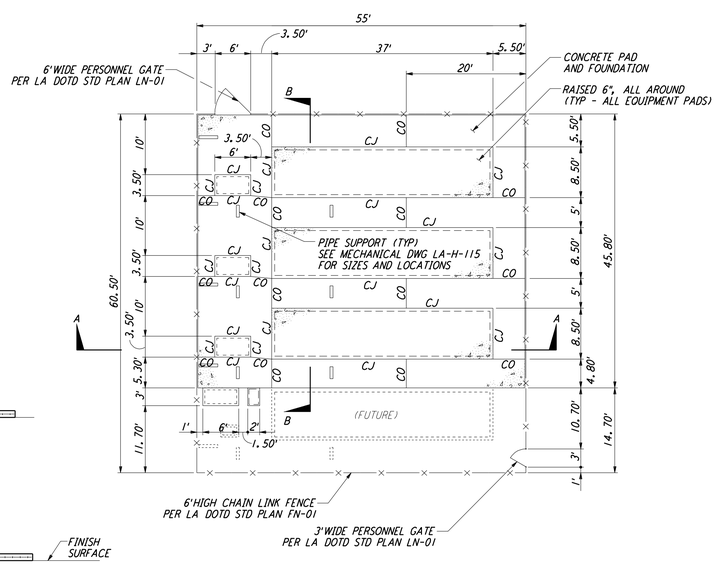

ENLARGED CHILLER YARD PLAN
SCALE: 1" = 10'

GRAPHIC SCALE
0 20 40 60 80
SCALE: 1" = 20'

LIGO-D960824-02-O

REFERENCES		REVISIONS						
DRAWING NO.	DESCRIPTION	NO.	DATE	BY	CHKD	ENGR	PROJ	DESCRIPTION
		2	08-07-98	WRB				ISSUED FOR AS-BUILT
		1	2-28-97	WRB	ML	JB	TDM	ADDED WALK/WALL OPENING

ISSUED FOR CONSTRUCTION		
DRAWN	WRB	11-15-96
CHECKED	ML	11-15-96
ENGINEER	JB	11-15-96
PROJ	TDM	11-15-96

AS-BUILT DRAWINGS

PARSONS
100 WEST WALNUT STREET
PASADENA, CALIFORNIA

LIGO
CALIFORNIA INSTITUTE OF TECHNOLOGY
MASSACHUSETTS INSTITUTE OF TECHNOLOGY

LASER INTERFEROMETER GRAVITATIONAL-WAVE OBSERVATORY
SITE NO.2 - LIVINGSTON, LOUISIANA

TITLE	SCALE	CONTRACT NUMBER	PROJECT NUMBER
CIVIL CORNER STATION PLOT PLAN ENLARGED PLAN	AS NOTED	PP150969	8094
	SHEET NUMBER		REVISIONS
	LA-C-006		2

LIGOLAF3.BDR

Tue Oct 6 10:50:12 1998 c:\pilot\perf\S3-3B.def N:\DUELUES\E3082\CE006.PRF