DATE: 08/23/98 TIME: 21:54:26
DESIGN FILE: I:\ligo\site2\ce\loc051.dgz

This document and the design it covers are the property of PARSONS. They are loaned only with the borrower's expressed written agreement that they will not be reproduced, copied, loaned, exhibited, or used in any other way, except by written consent from PARSONS to the borrower.

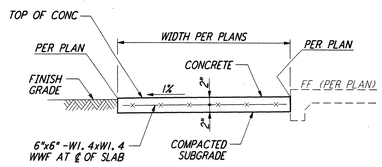

CONCRETE WALKWAY (1) LA-C-051 — NOT TO SCALE

REF: LA-C-005, LA-C-006, LA-C-007, LA-C-008

CONCRETE APRON (1 SIM) LA-C-051 — NOT TO SCALE

REF: LA-C-005, LA-C-006, LA-C-007, LA-C-008

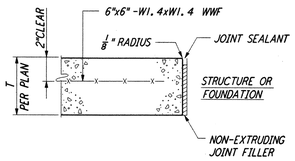

EXPANSION JOINT (EJ) (5) LA-C-051 — NOT TO SCALE

REF: LA-C-005, LA-C-006, LA-C-021, LA-C-025, LA-C-041, LA-C-045

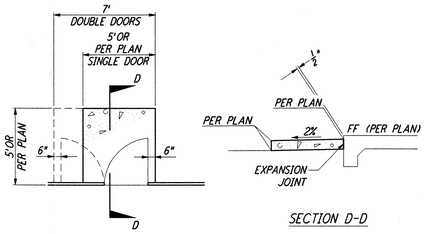

CONCRETE STOOP (2) LA-C-051 — NOT TO SCALE

REF: LA-C-005, LA-C-006, LA-C-025, LA-C-045

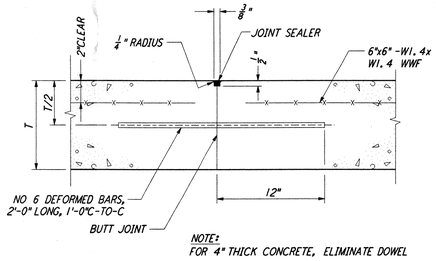

NOTE: FOR 4" THICK CONCRETE, ELIMINATE DOWEL

CONSTRUCTION JOINT (CJ) (6) LA-C-051 — NOT TO SCALE

(SEPARATE POURS OR END OF DAY)

REF: LA-C-005, LA-C-006, LA-C-021, LA-C-025, LA-C-041, LA-C-045

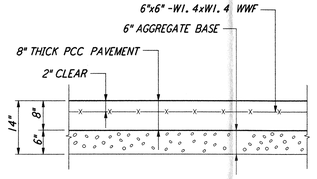

CONCRETE PAVEMENT (3) LA-C-051 — NOT TO SCALE

REF: LA-C-005, LA-C-006, LA-C-021, LA-C-025, LA-C-041, LA-C-045

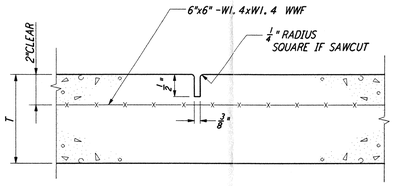

CONTRACTION JOINT (CO) (7) LA-C-051 — NOT TO SCALE

(SPACING: 20'MAX)

REF: LA-C-005, LA-C-006, LA-C-021, LA-C-025, LA-C-041, LA-C-045

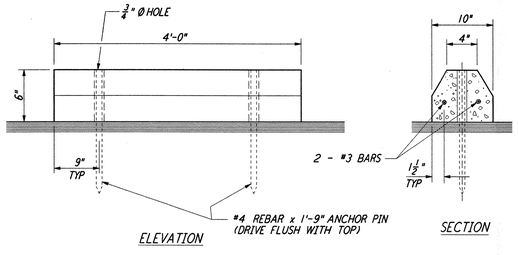

CONCRETE PARKING BUMPER (4) LA-C-051 — NOT TO SCALE

REF: LA-C-005, LA-C-006, LA-C-021, LA-C-025, LA-C-041, LA-C-045

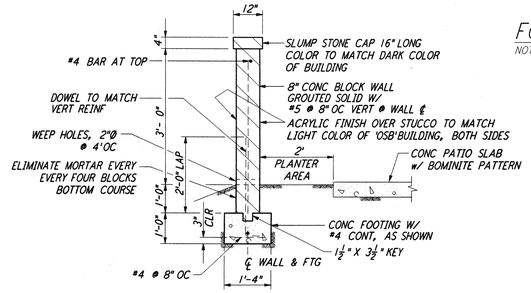

PATIO WALL (8) LA-C-051 — NOT TO SCALE

REF: LA-C-006

NOTES:

1. SEE SHEET LA-C-002 FOR GENERAL NOTES, LEGEND AND ABBREVIATIONS.

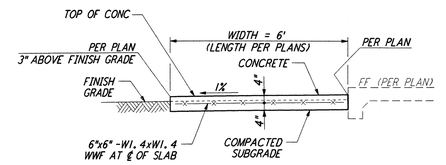

RAISED CONCRETE PAD FOR ELECTRICAL TANSFORMERS (9) LA-C-051 — NOT TO SCALE

REF: LA-C-005

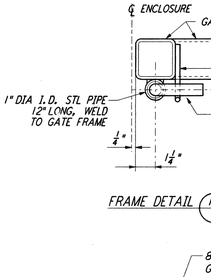

FRAME DETAIL (14) —

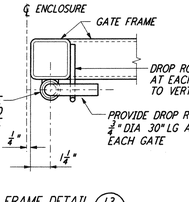

FRAME DETAIL (13) —

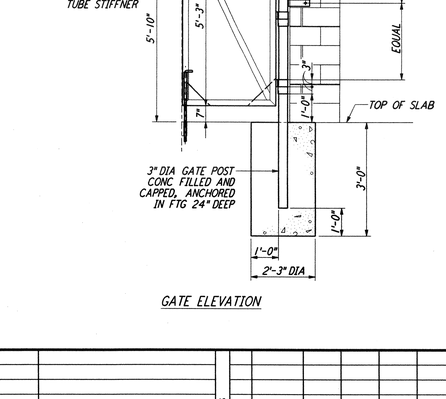

GATE ELEVATION

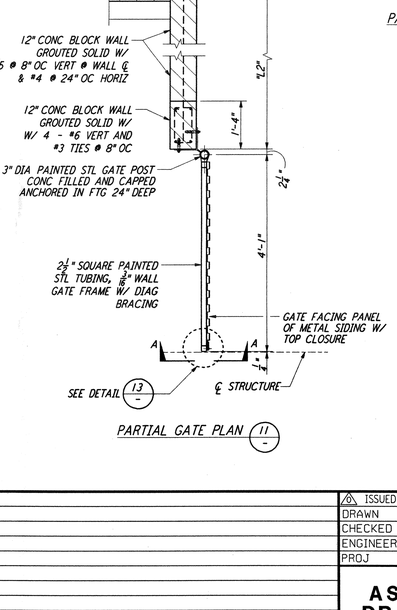

PARTIAL GATE PLAN (11) —

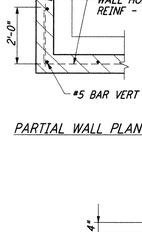

PARTIAL WALL PLAN (12) —

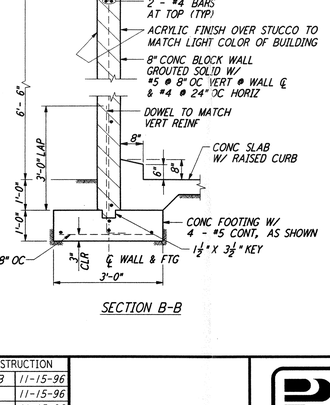

SECTION B-B

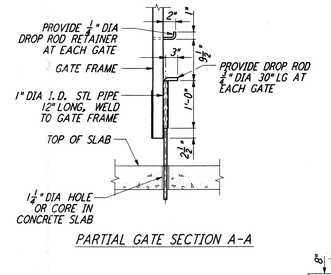

PARTIAL GATE SECTION A-A

BLOCK WALL ENCLOSURE DIMENSIONS					
	"L"	"L1"	"L2"	"W"	"W1"
HAZARDOUS WASTE STORAGE	30'	28'-4"	10'-8½"	15'	13'-8"
TRASH ENCLOSURE	18'	16'-4"	4'-8½"	10'	8'-8"

NOTE:

1. FOR SLAB FINISHED GRADES, SEE GRADING PLAN.

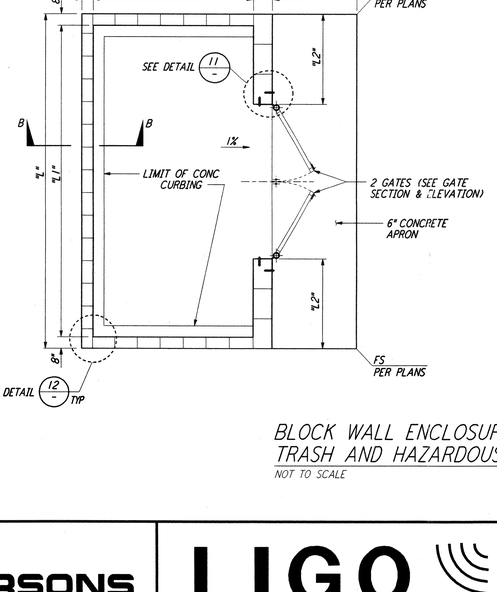

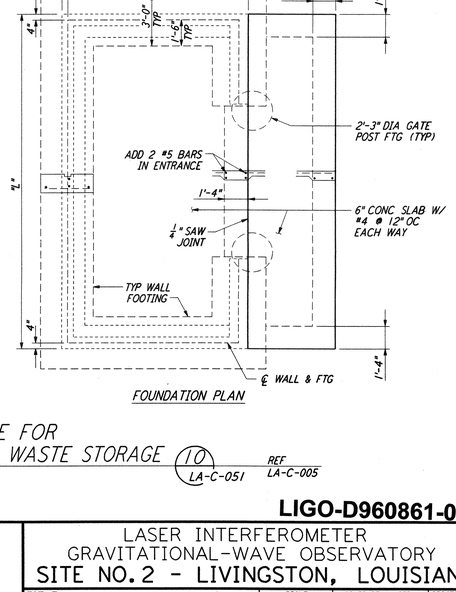

FOUNDATION PLAN

BLOCK WALL ENCLOSURE FOR TRASH AND HAZARDOUS WASTE STORAGE (10) LA-C-051 — NOT TO SCALE

REF: LA-C-005

LIGO-D960861-01-O

REFERENCES

DRAWING NO.	DESCRIPTION

REVISIONS

NO.	DATE	BY	CHKD	ENGR	PROJ	DESCRIPTION
1	08-07-98	WRB				ISSUED FOR AS-BUILT

ISSUED FOR CONSTRUCTION		
DRAWN	WRB	11-15-96
CHECKED	ML	11-15-96
ENGINEER	JB	11-15-96
PROJ	TDM	11-15-96

AS-BUILT DRAWINGS

PARSONS
100 WEST WALNUT STREET
PASADENA, CALIFORNIA

LIGO
CALIFORNIA INSTITUTE OF TECHNOLOGY
MASSACHUSETTS INSTITUTE OF TECHNOLOGY

LASER INTERFEROMETER GRAVITATIONAL-WAVE OBSERVATORY
SITE NO. 2 - LIVINGSTON, LOUISIANA

TITLE: CIVIL SITEWORK DETAILS SHEET 1

SCALE	CONTRACT NUMBER	PROJECT NUMBER
AS NOTED	PP150969	8094

SHEET NUMBER: LA-C-051 REVISIONS: 1

LIGOLAF3.BDR

Sun Aug 23 21:53:47 1998 C:\PLOTTQUE\S3-T3682\ce051.prf 52085 K:\T3682\ce051.qpf