



WALL TYPE SCHEDULE

WALL TYPES LEGEND

WALL KEY	DETAIL PLAN	DESCRIPTION	WALL KEY	DETAIL PLAN	DESCRIPTION	WALL KEY	DETAIL PLAN	DESCRIPTION
18		EXTERIOR INSULATED METAL WALL PANELS (VERTICAL)	11		6" METAL STUDS 5/8" GYPSUM BOARD	4		4" METAL STUD 5/8" GYPSUM BOARD
19		7/8" SMOOTH PLASTER OVER METAL LATH 1/2" PLYWOOD 8" METAL STUDS 1/2" PLYWOOD 7/8" SMOOTH PLASTER OVER METAL LATH	12		6" METAL STUDS 1/4" CERAMIC TILE 1" GROUT/BACKER BOARD 1/4" CERAMIC TILE	5		(WIRE WHERE INSULATION OCCURS) 4" METAL STUDS 1" GROUT/BACKER BOARD 1/4" CERAMIC TILE
20			13		5/8" GYPSUM BOARD 6" METAL STUDS 1" GROUT/BACKER BOARD 1/4" CERAMIC TILE	6		5/8" GYPSUM BOARD 4" METAL STUD 5/8" GYPSUM BOARD
21			14		1/4" CERAMIC TILE 1" GROUT/BACKER BOARD 6" METAL STUDS 1" GROUT/BACKER BOARD 1/4" CERAMIC TILE	7		5/8" GYPSUM BOARD 4" METAL STUD 1" GROUT/BACKER BOARD 1/4" CERAMIC TILE
22			15		6" METAL STUDS 5/8" GYPSUM BOARD 5/8" GYPSUM BOARD	8		4" METAL STUD 5/8" GYPSUM BOARD 5/8" GYPSUM BOARD
23			16		5/8" GYPSUM BOARD 6" METAL STUDS 5/8" GYPSUM BOARD	9		5/8" GYPSUM BOARD 5/8" GYPSUM BOARD 4" METAL STUD 5/8" GYPSUM BOARD 5/8" GYPSUM BOARD
24			17		5/8" GYPSUM BOARD 6" METAL STUDS 5/8" GYPSUM BOARD 5/8" GYPSUM BOARD	10		5/8" GYPSUM BOARD 5/8" GYPSUM BOARD 4" METAL STUD 5/8" GYPSUM BOARD 1" GROUT/BACKER BOARD 1/4" CERAMIC TILE

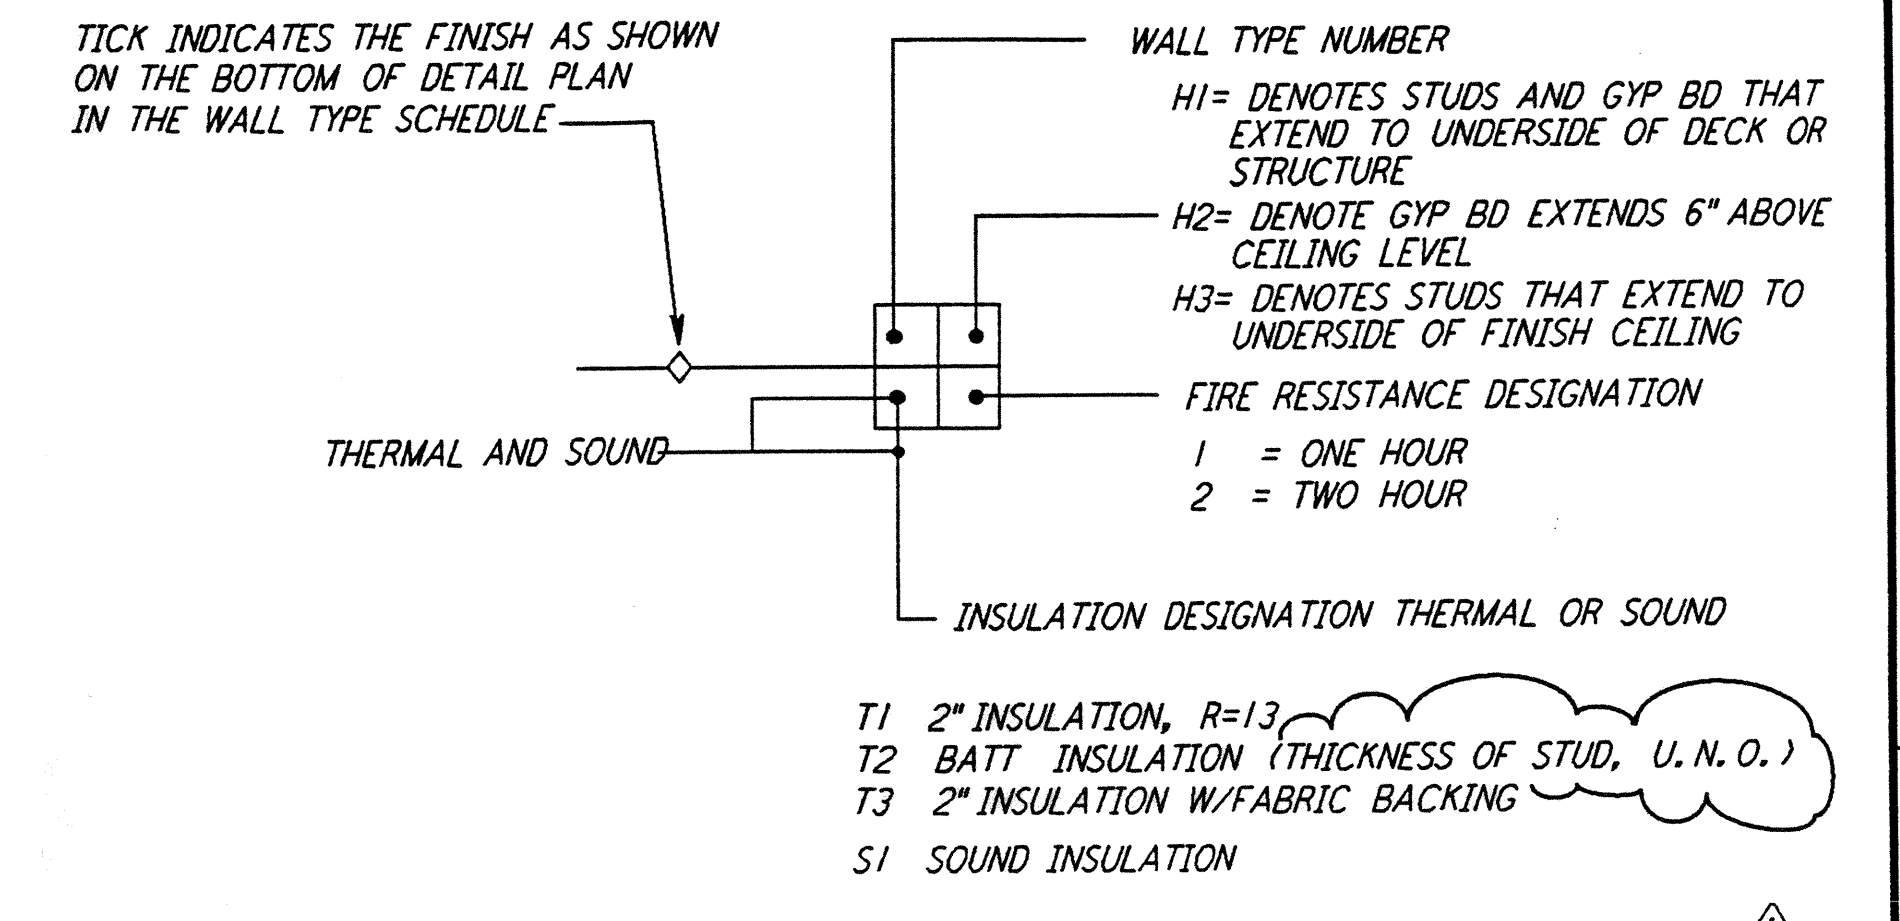

NOTE :
INDICATED INSULATION VALUES FOR THERMAL AND SOUND ARE THE MINIMUM REQUIRED VALUES

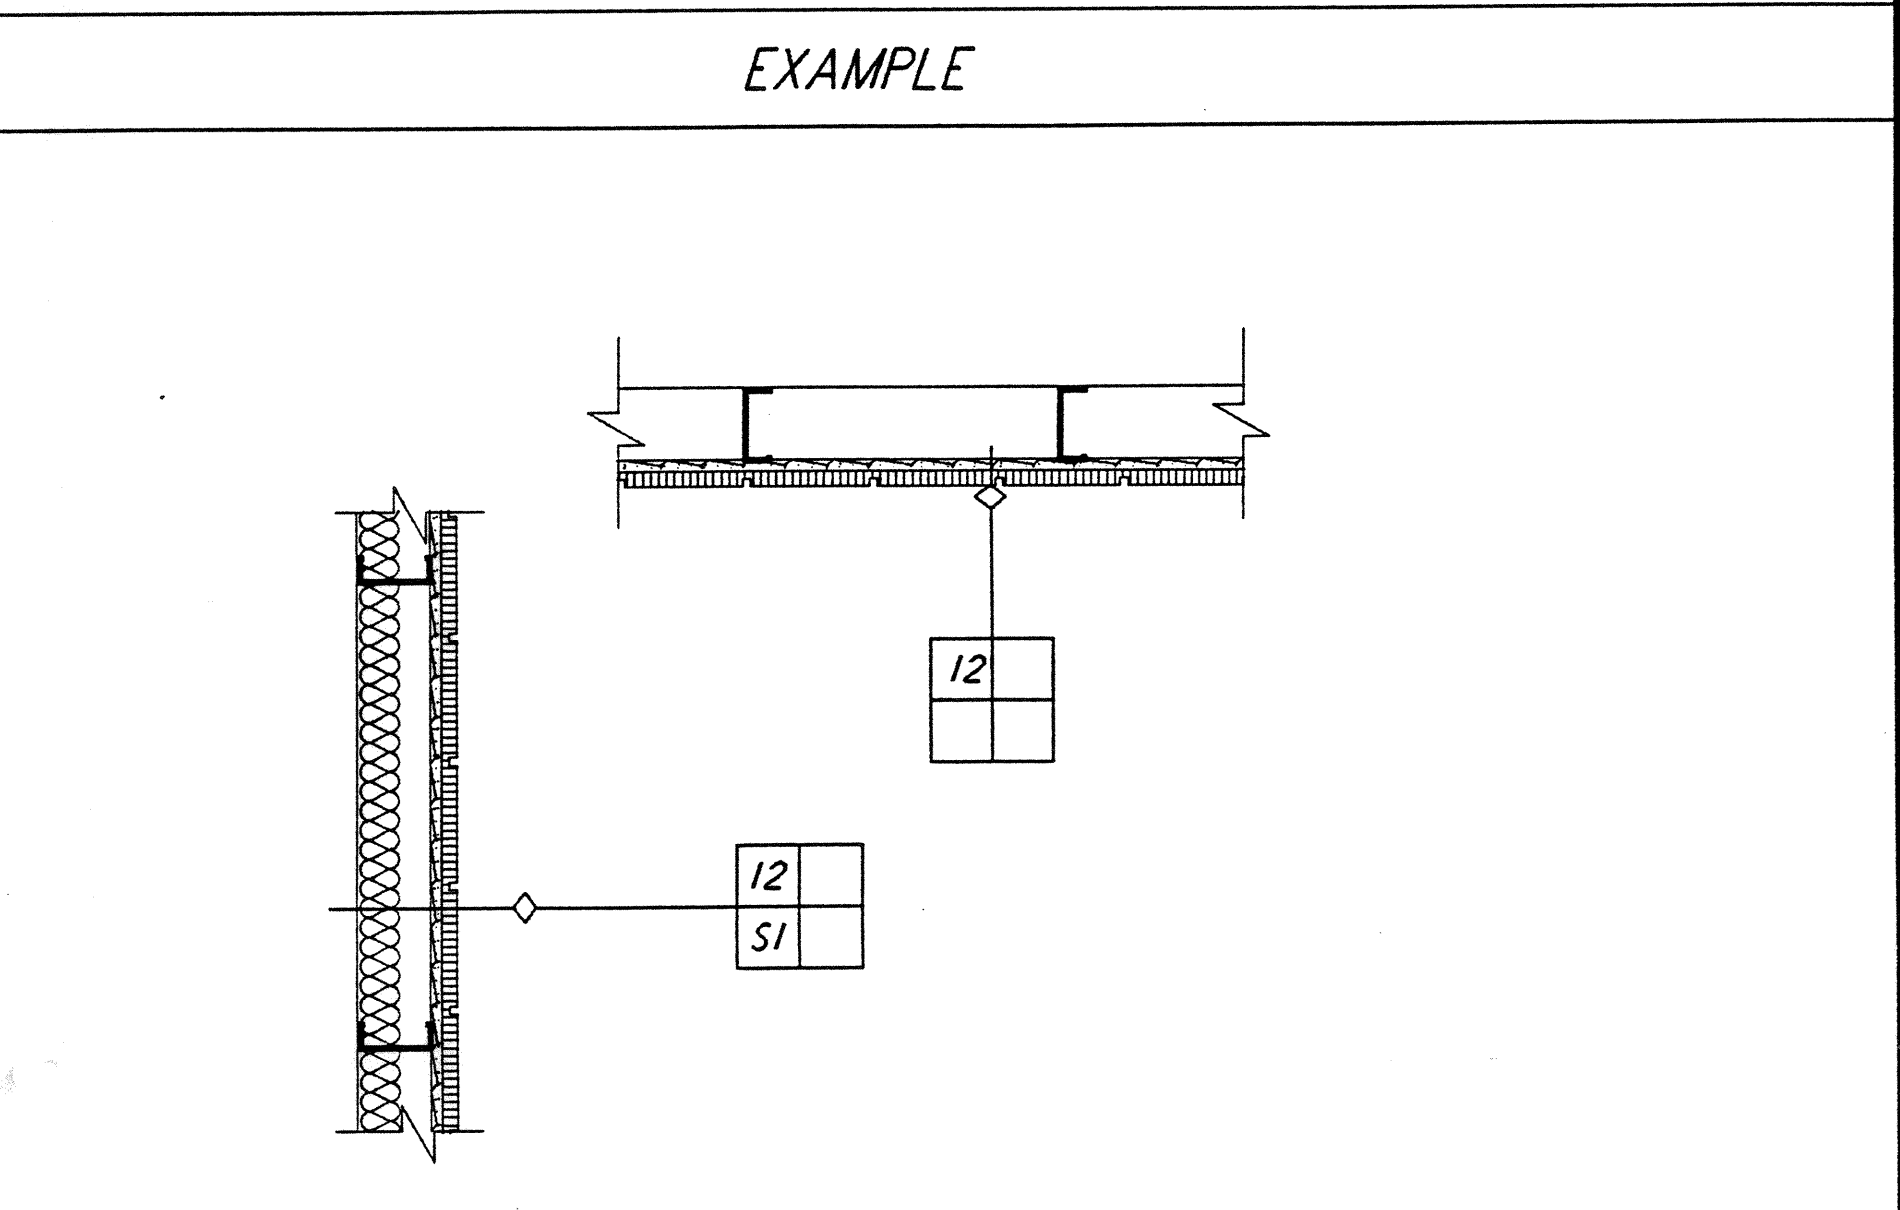


WALL KEY	DETAIL PLAN	DESCRIPTION
1		2 1/2" METAL STUD 5/8" GYPSUM BOARD
2		5/8" GYPSUM BOARD 2 1/2" METAL STUD 5/8" GYPSUM BOARD
3		(WIRE WHERE INSULATION OCCURS) 2 1/2" METAL STUDS 1" GROUT/BACKER BOARD 1/4" CERAMIC TILE

This document and the design it covers are the property of PARSONS. They are loaned only with the borrower's expressed written agreement that they will not be reproduced, copied, loaned, exhibited, or used in any other way, except by written consent from PARSONS to the borrower.

REF: 10 1/17/11/27 1371 53770002 JAVLUIS NOLANES V. BRAC VIKER/CD/PTP

ISSUED FOR CONSTRUCTION	
DRAWN	CKT 11-15-96
CHECKED	TB 11-15-96
ENGINEER	SF 11-15-96
PROJ	MDW 11-15-96
CORNER STATION VSEA PARTITION	
DRAWING NO.	DESCRIPTION
NO.	DATE
1	2-28-97
BY	CHKD
CKT	TB
AK	TJM
ENGR	PROJ

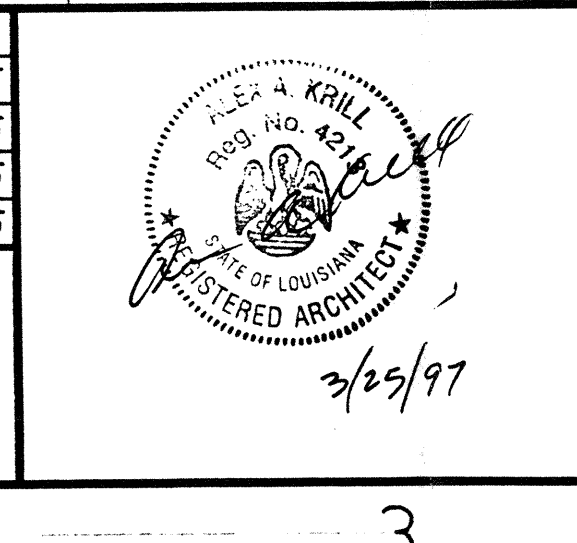

100 WEST WALNUT STREET
PASADENA, CALIFORNIA

CALIFORNIA INSTITUTE OF TECHNOLOGY
MASSACHUSETTS INSTITUTE OF TECHNOLOGY

LASER INTERFEROMETER
GRAVITATIONAL-WAVE OBSERVATORY
SITE NO. 2 - LIVINGSTON, LOUISIANA

ARCHITECTURAL WALL TYPE SCHEDULES

CONTRACT NUMBER: PP150969
PROJECT NUMBER: 8094

SHEET NUMBER: LA-A-428

REVISIONS

REVISION NO. DATE BY CHKD ENGR PROJ DESCRIPTION