




ELEVATION AT COLUMN LINES 11, 12, 13, 14 & 15  
 $\frac{3}{8}'' = 1'-0''$

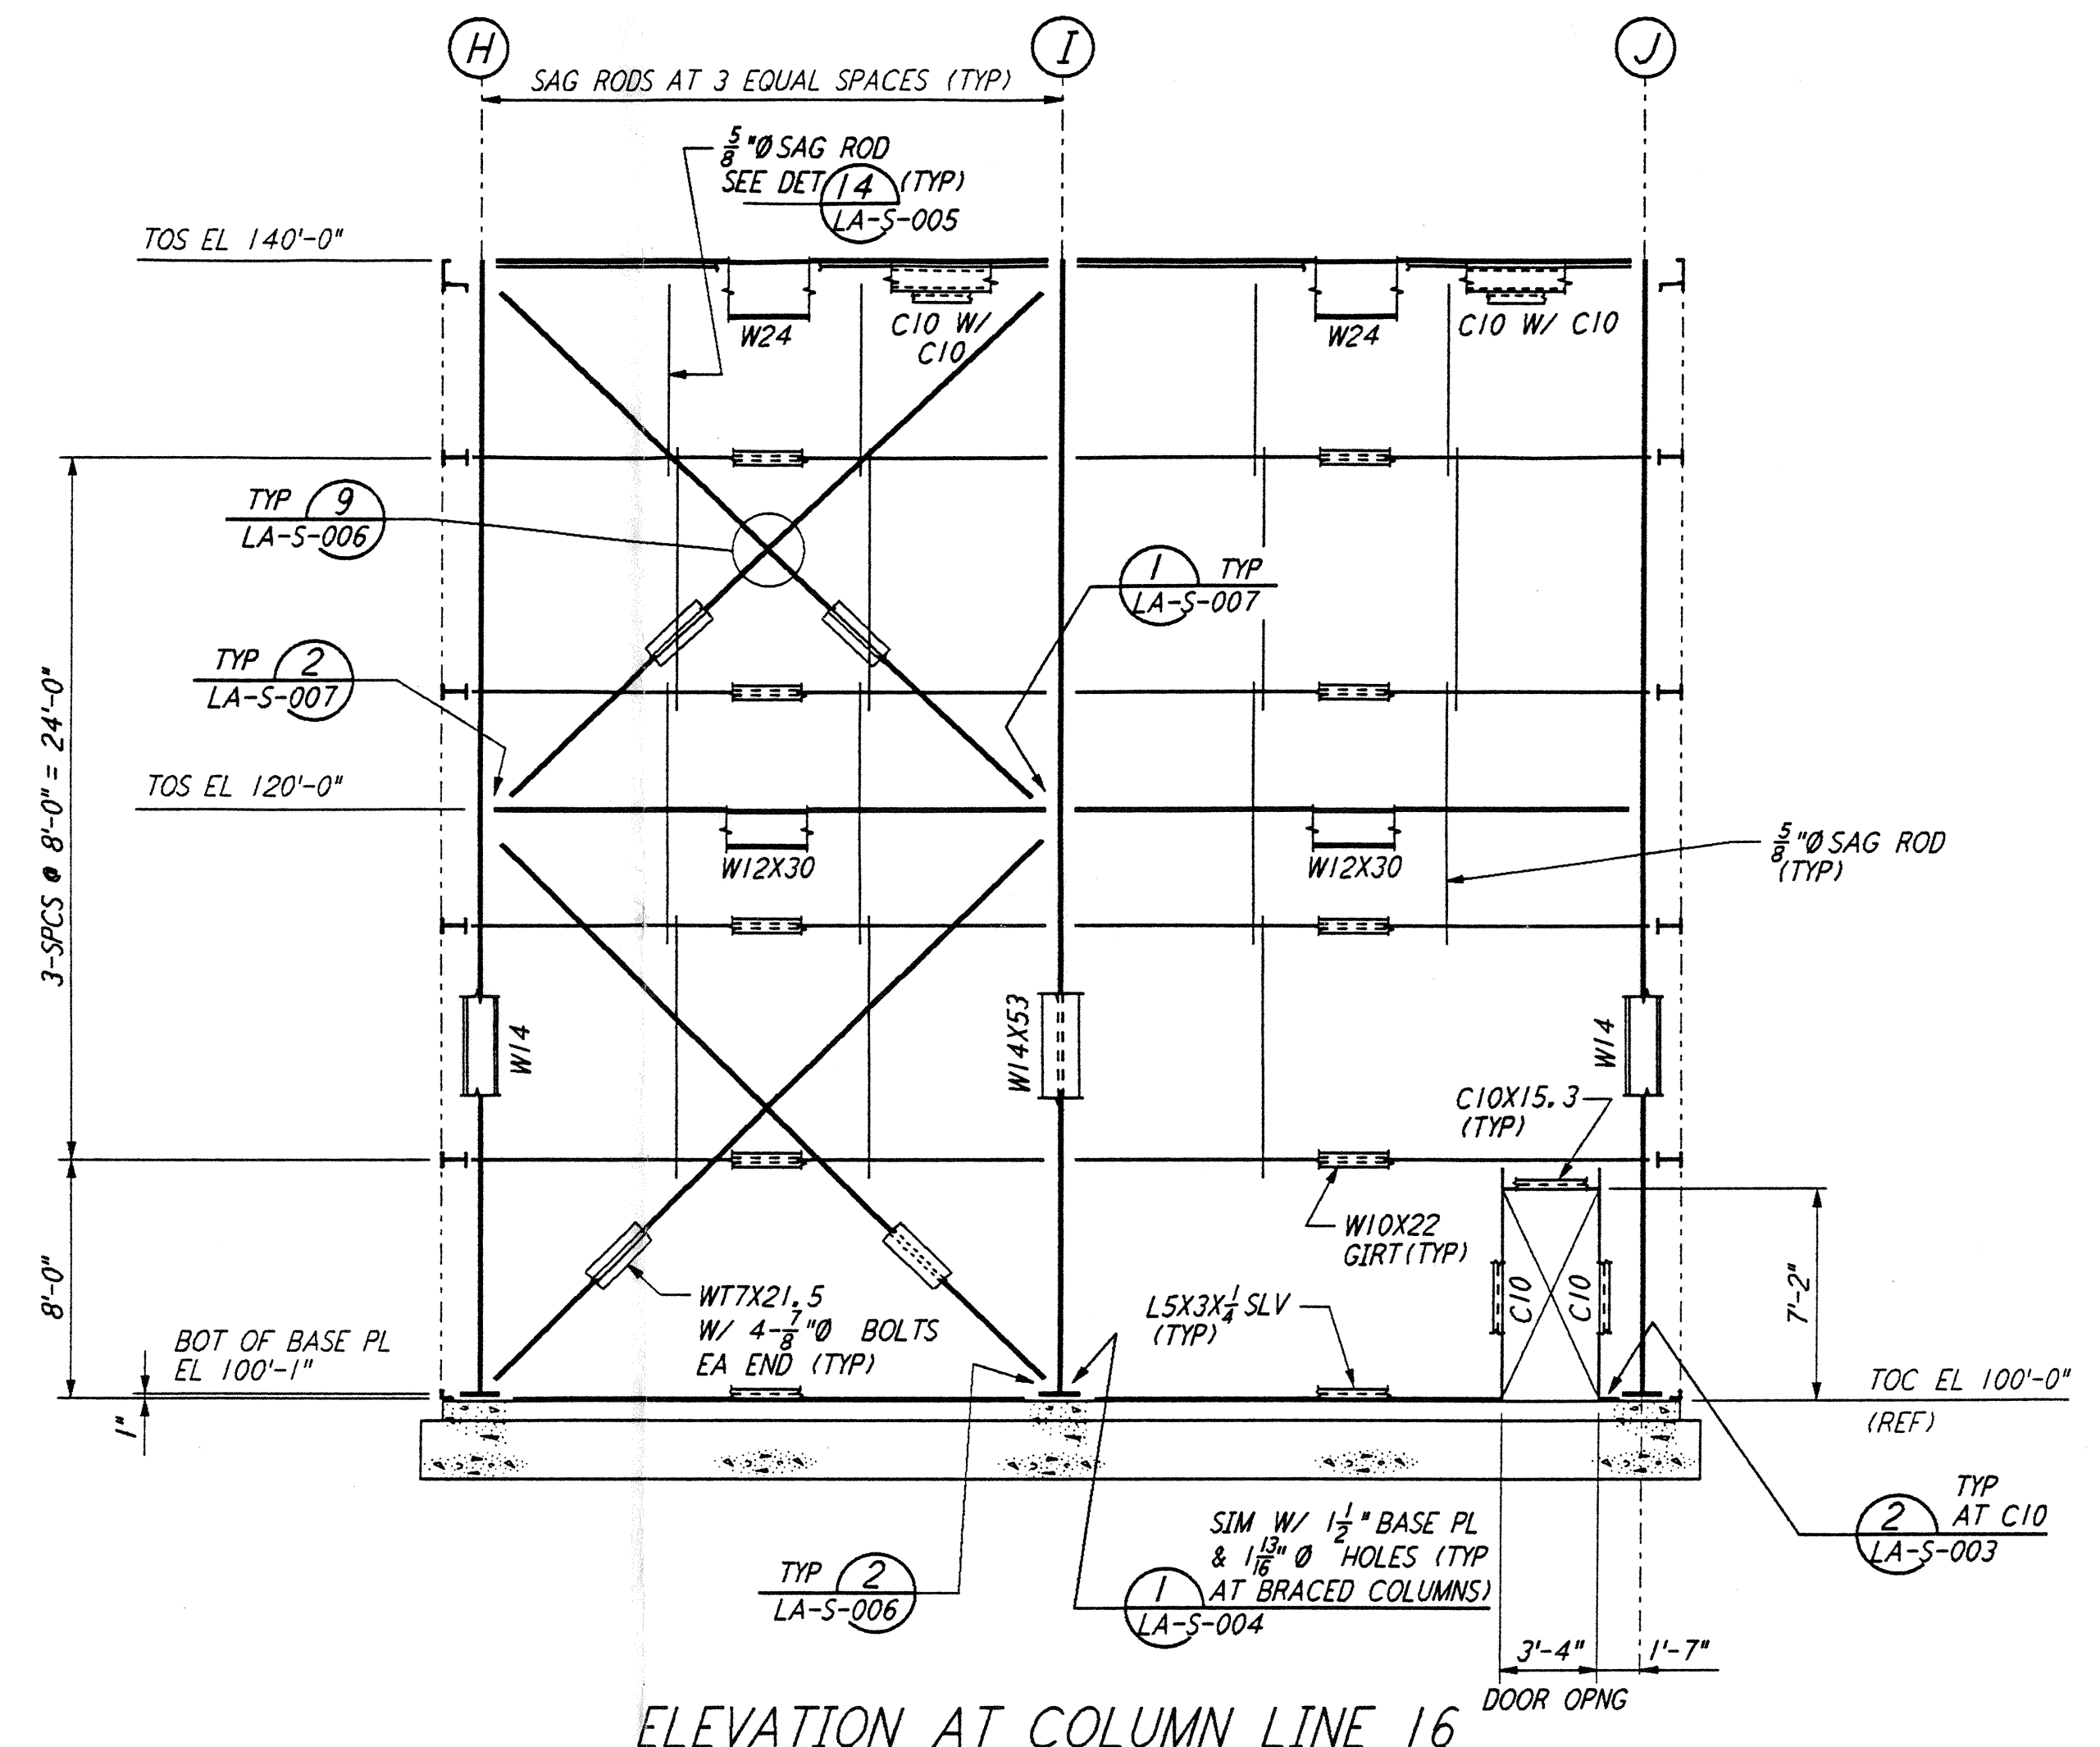

ELEVATION AT COLUMN LINE 16  
 $\frac{3}{8}'' = 1'-0''$

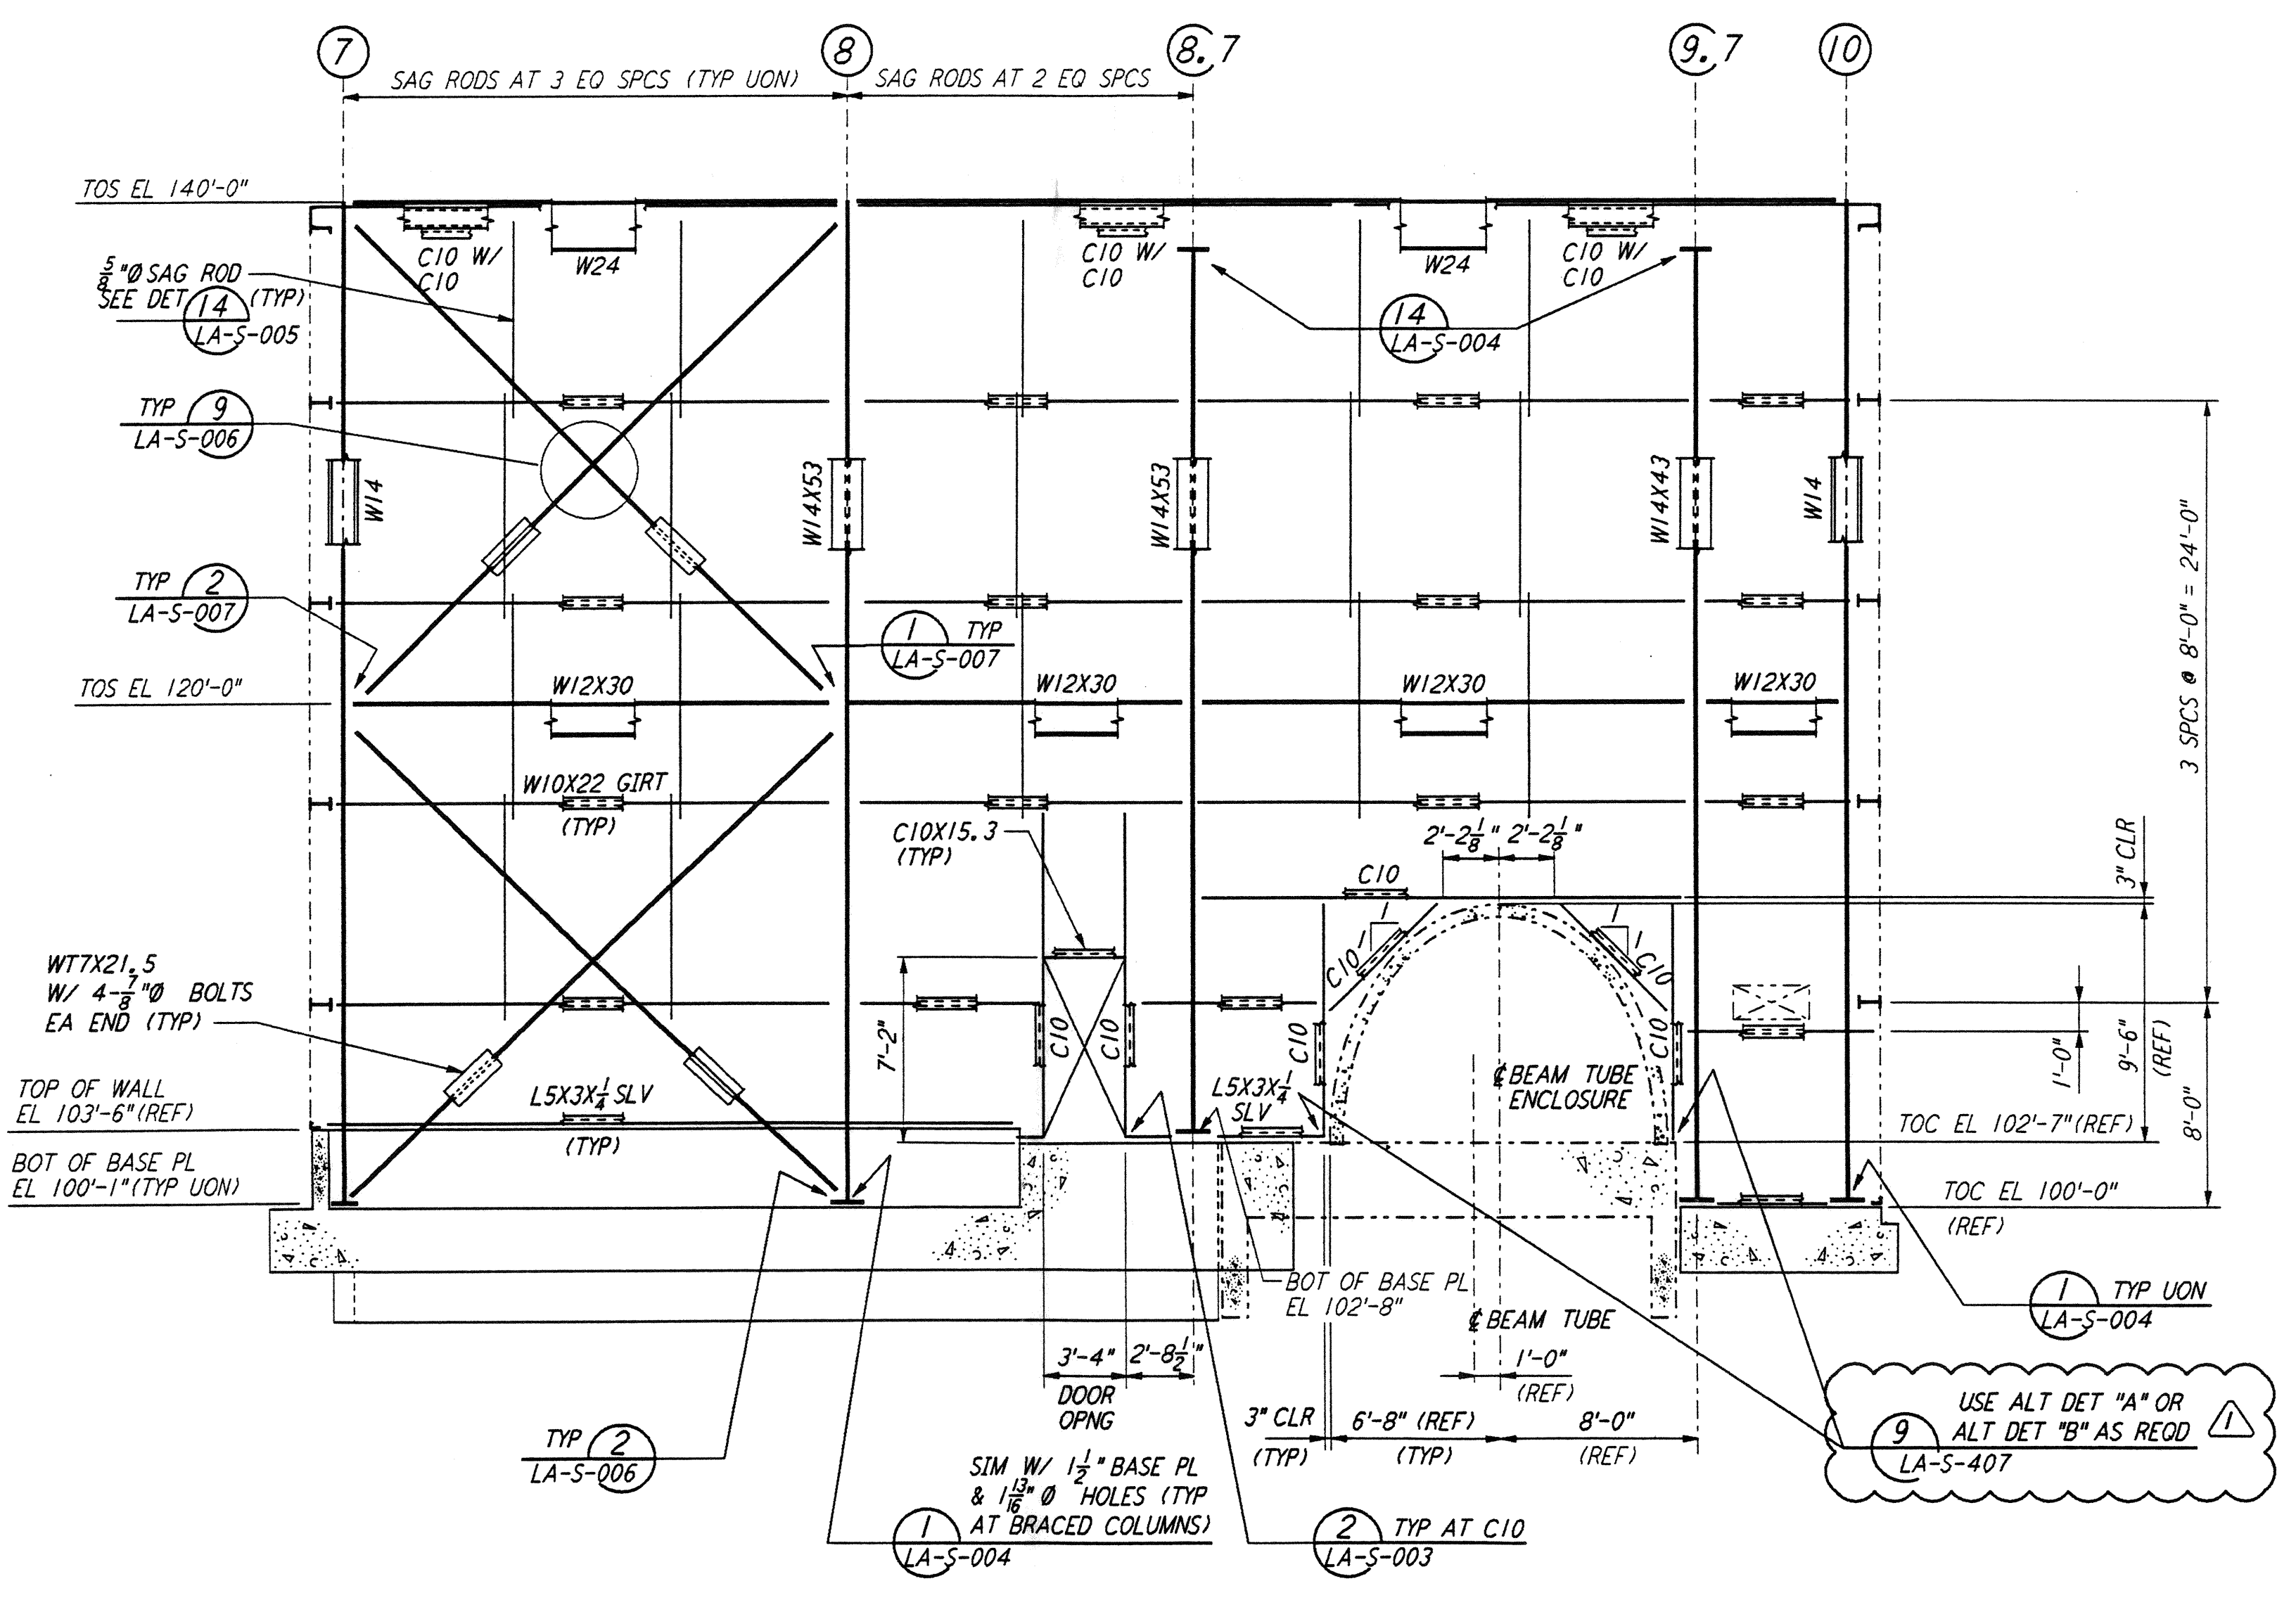


ELEVATION AT COLUMN LINE A  
 $\frac{3}{8}'' = 1'-0''$

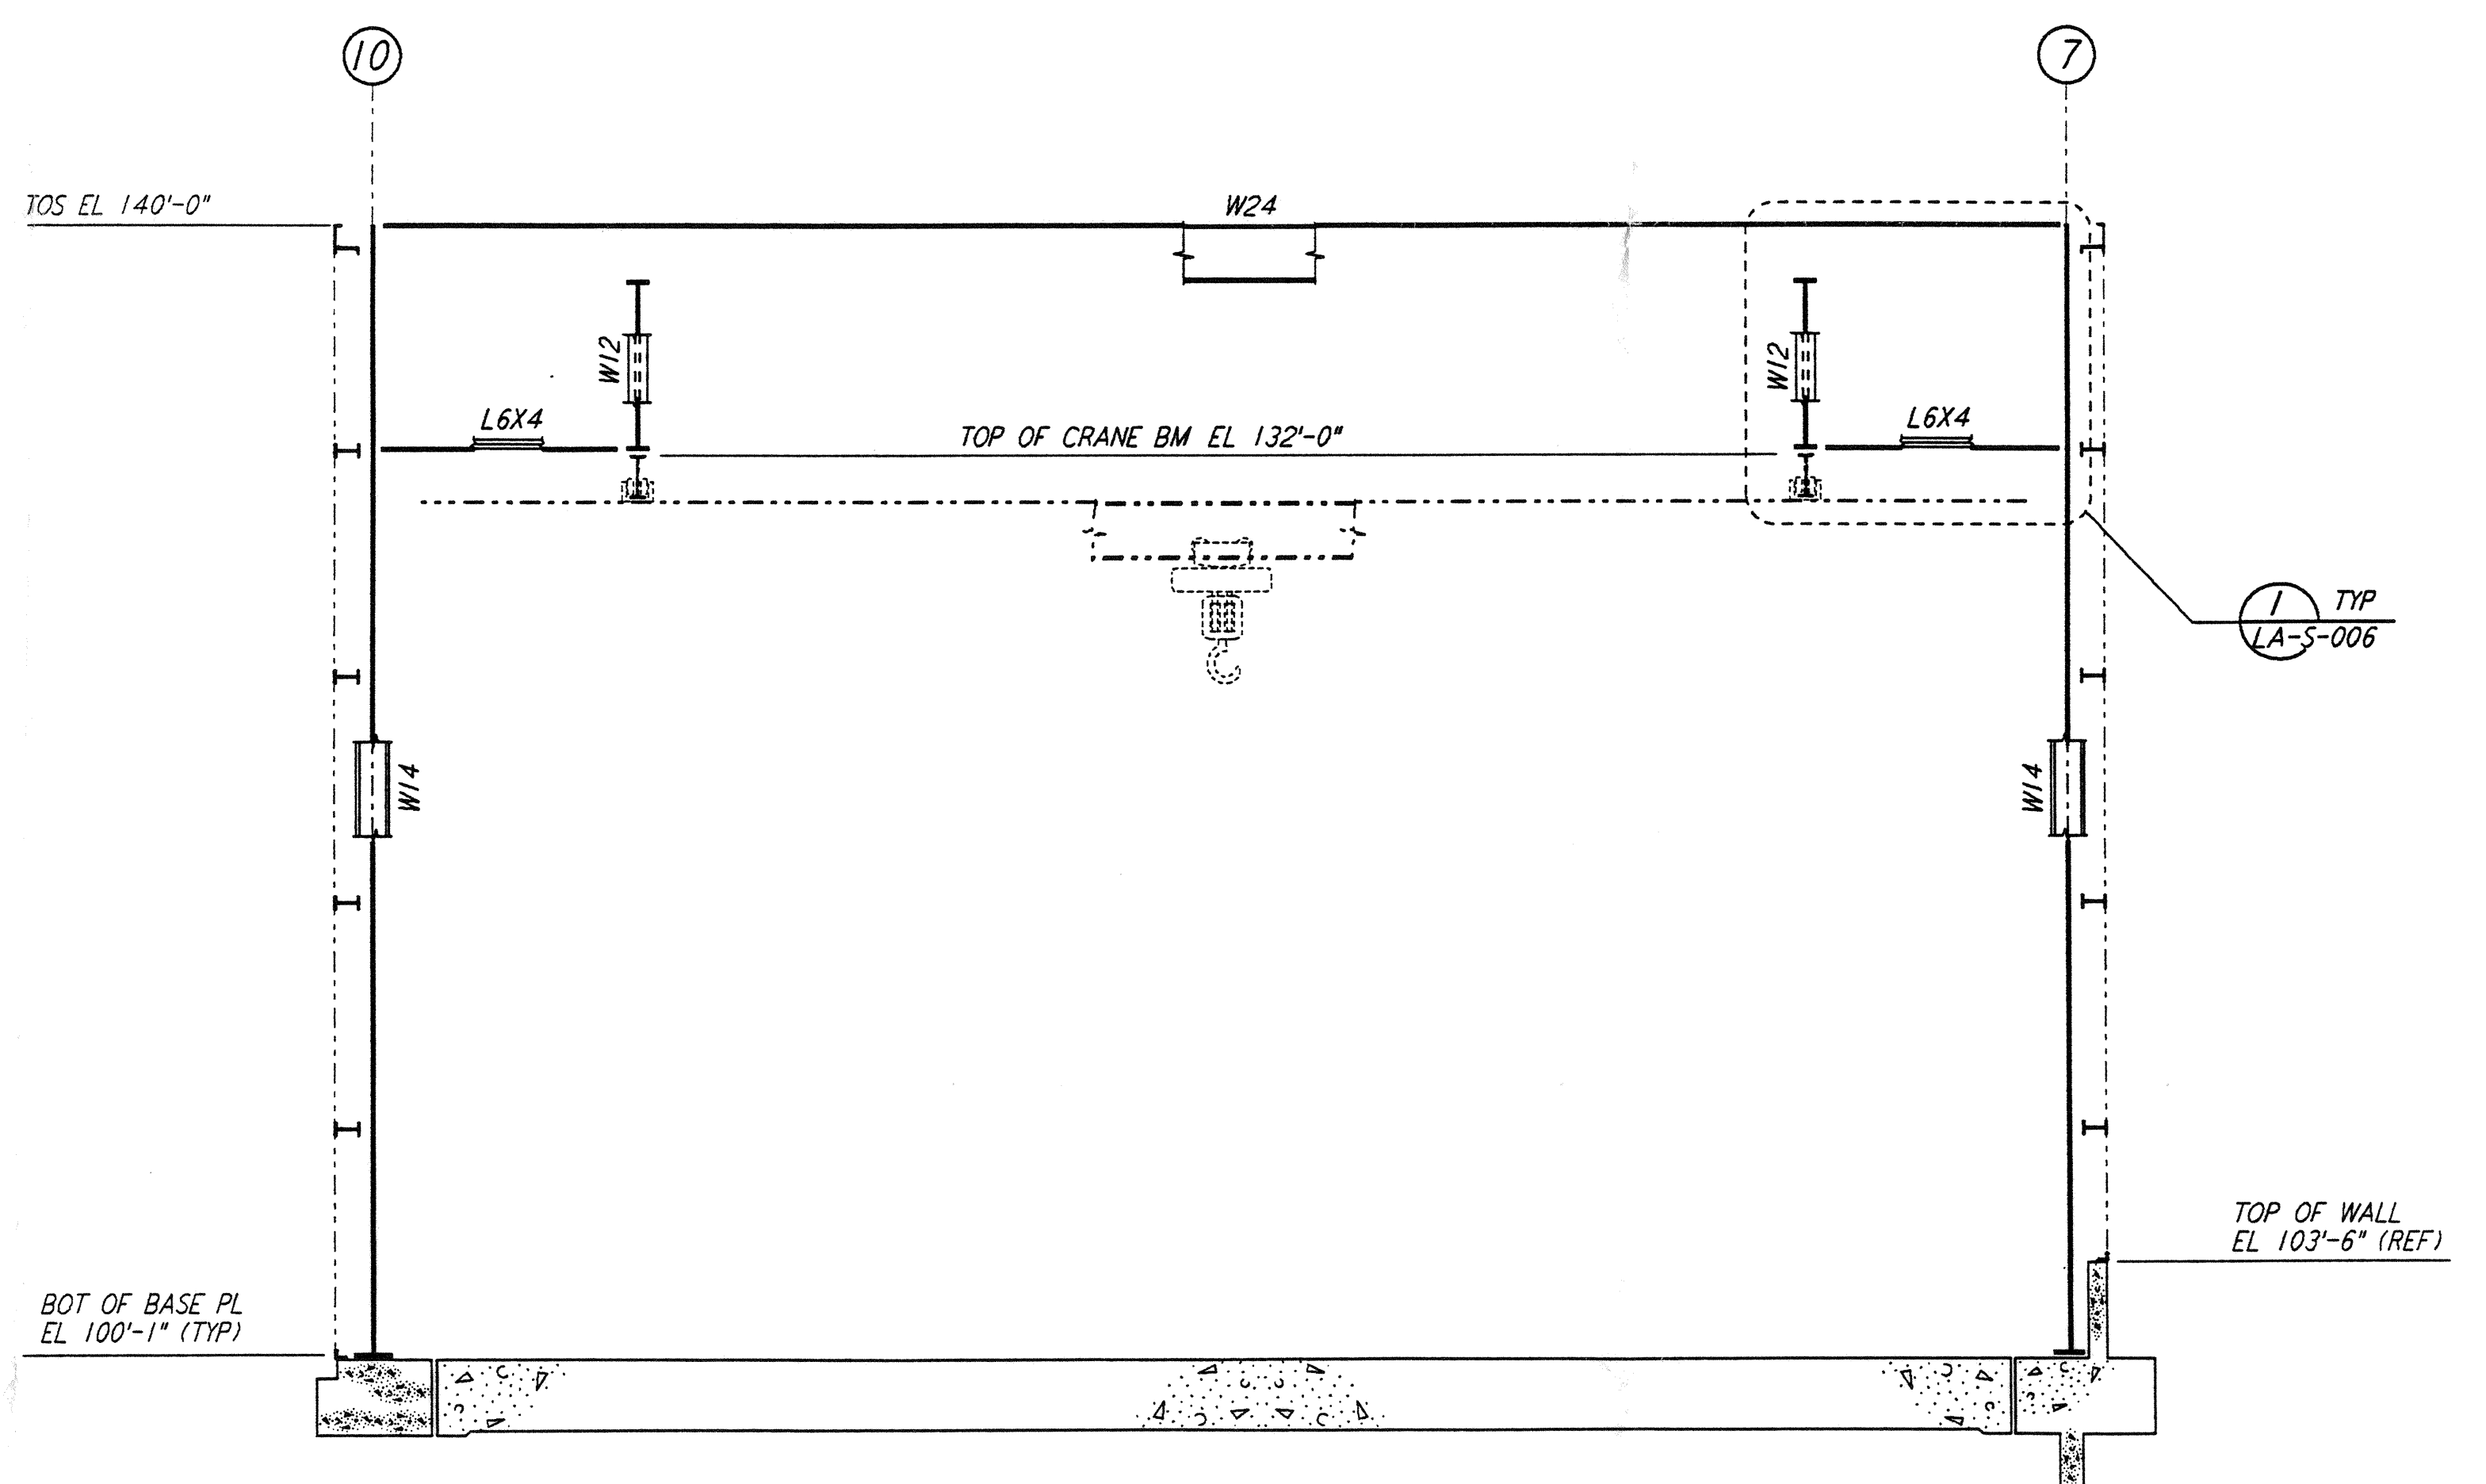

ELEVATION AT COLUMN LINES B, C, D, E & F  
 $\frac{3}{8}'' = 1'-0''$

NOTE:  
 1. FOR NOTES SEE DRAWING LA-S-107.

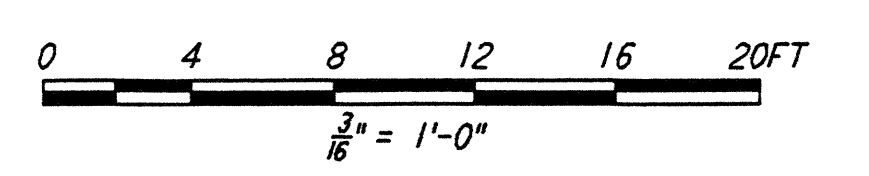


LIGO-D960927-01-0

not be reproduced, copied, loaned, exhibited, or used in any other way, except by written consent from PARSONS to the borrower.

This document and the design it covers are the property of PARSONS. They are loaned only with the borrower's expressed written agreement that they will not be reproduced, copied, loaned, exhibited, or used in any other way, except by written consent from PARSONS to the borrower.

NO.	DATE	BY	CHKD	ENGR	PROJ	DESCRIPTION
1	2-28-97	RM	A.B.	PH		ADDED DET REF AT ELEV LN A

ISSUED FOR CONSTRUCTION	DRAWN	CHECKED	ENGINEER	PROJ
	MCS	DDM	BP	TDM
	11-15-96	11-15-96	11-15-96	11-15-96

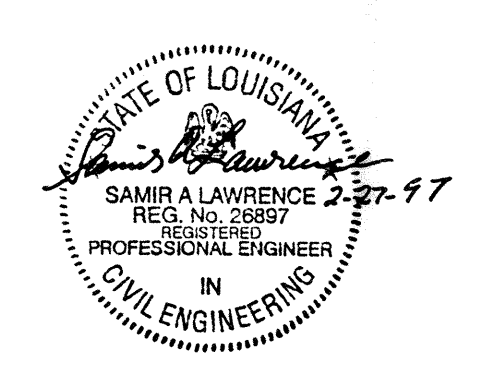

**PARSONS**  
 100 WEST WALNUT STREET  
 PASADENA, CALIFORNIA

**LIGO**  
 CALIFORNIA INSTITUTE OF TECHNOLOGY  
 MASSACHUSETTS INSTITUTE OF TECHNOLOGY

LASER INTERFEROMETER  
 GRAVITATIONAL-WAVE OBSERVATORY  
 SITE NO. 2 - LIVINGSTON, LOUISIANA

STRUCTURAL  
 CORNER STATION  
 LVEA FRAMING ELEVATIONS  
 SHEET 5

SCALE: AS NOTED  
 CONTRACT NUMBER: PP150969  
 PROJECT NUMBER: 8094

**LA-S-111**