DATE: 02/25/97 TIME: 12:34:56
DESIGN FILE: I:\ligo\site2\s#\las111.dgz

This document and the design it covers are the property of **PARSONS**. They are loaned only with the borrower's expressed written agreement that they will not be reproduced, copied, loaned, exhibited, or used in any other way, except by written consent from **PARSONS** to the borrower.

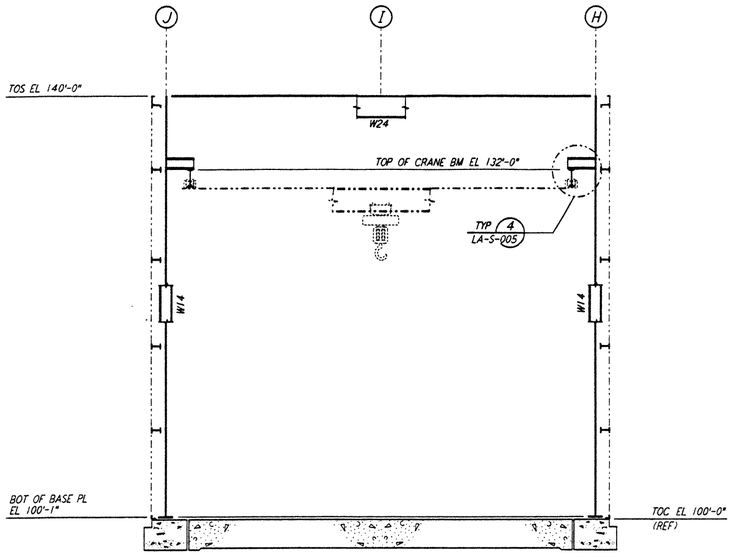

ELEVATION AT COLUMN LINES 11, 12, 13, 14 & 15

3/8" = 1'-0"

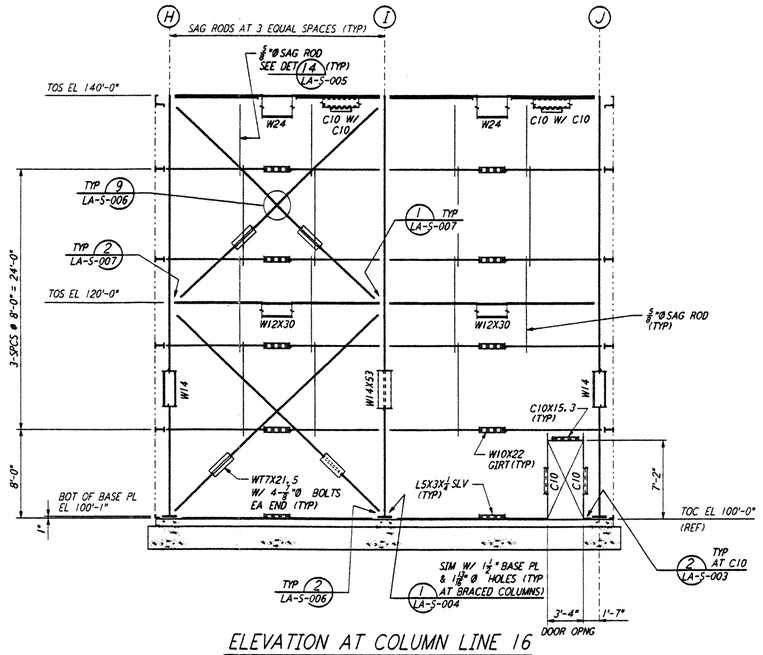

ELEVATION AT COLUMN LINE 16

3/8" = 1'-0"

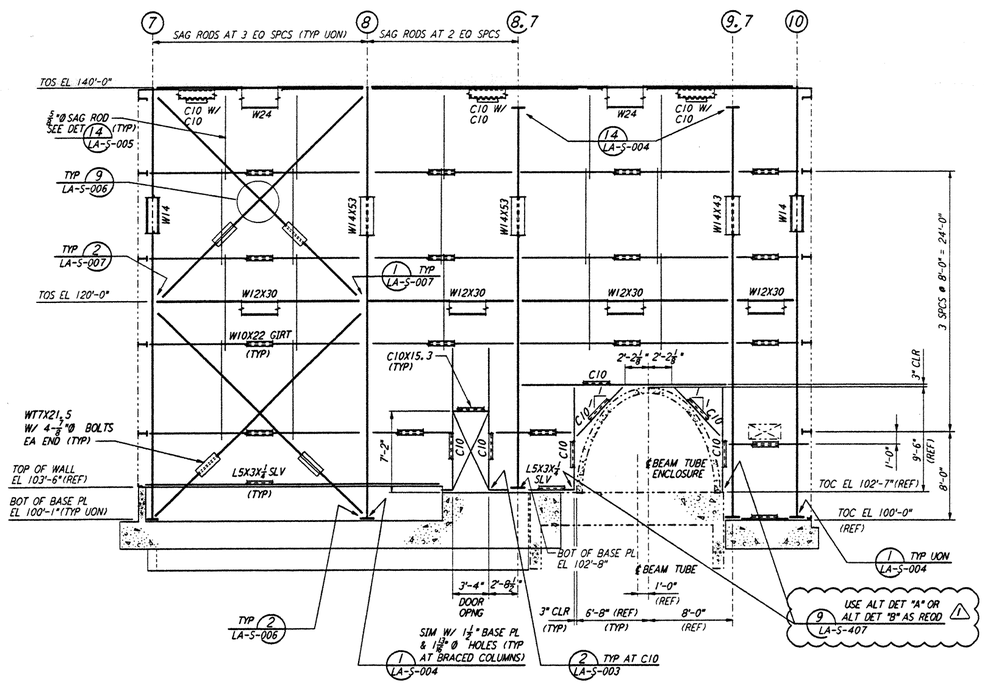

ELEVATION AT COLUMN LINE A

3/8" = 1'-0"

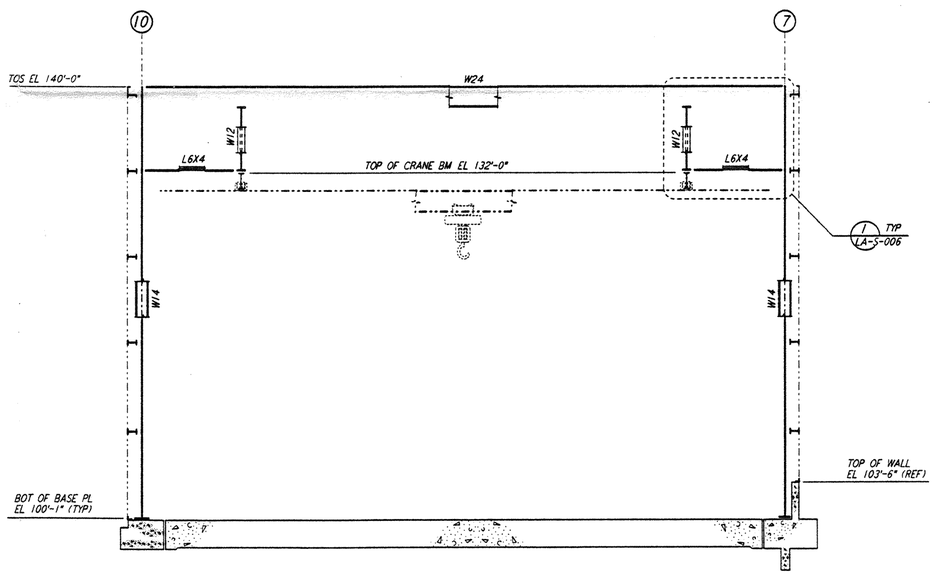

ELEVATION AT COLUMN LINES B, C, D, E & F

3/8" = 1'-0"

NOTE:

1. FOR NOTES SEE DRAWING LA-S-107.

0 4 8 12 16 20FT

3/8" = 1'-0"

LIGO-D960927-01-O

REFERENCES		REVISIONS							
DRAWING NO.	DESCRIPTION	NO.	DATE	BY	CHKD	ENGR	PROJ	DESCRIPTION
		1	2-28-97	RM	RAB	MH		ADDED DET REF AT ELEV LN A

ISSUED FOR CONSTRUCTION		
DRAWN	MCS	11-15-96
CHECKED	DDM	11-15-96
ENGINEER	BP	11-15-96
PROJ	TDM	11-15-96

STATE OF LOUISIANA — SAMIR A. LAWRENCE 2-27-97 — REG. NO. 19997 — PROFESSIONAL ENGINEER IN CIVIL ENGINEERING

PARSONS
100 WEST WALNUT STREET
PASADENA, CALIFORNIA

LIGO
CALIFORNIA INSTITUTE OF TECHNOLOGY
MASSACHUSETTS INSTITUTE OF TECHNOLOGY

LASER INTERFEROMETER GRAVITATIONAL-WAVE OBSERVATORY
SITE NO. 2 - LIVINGSTON, LOUISIANA

TITLE: STRUCTURAL CORNER STATION LVEA FRAMING ELEVATIONS SHEET 5

SCALE	CONTRACT NUMBER	PROJECT NUMBER
AS NOTED	PP150969	8094

SHEET NUMBER: LA-S-111 REVISIONS: 1

LIGOLAF.BOR

tue Feb 25 12:34:14 1997 s:\s2\dgz\plots\las111.plt
tue Feb 25 12:34:14 1997 s:\s2\dgz\plots\las111.plt