




This document and the design it covers are the property of PARSONS. They are loaned only with the borrower's expressed written agreement that they will not be reproduced, copied, loaned, exhibited, or used in any other way, except by written consent from PARSONS to the borrower.

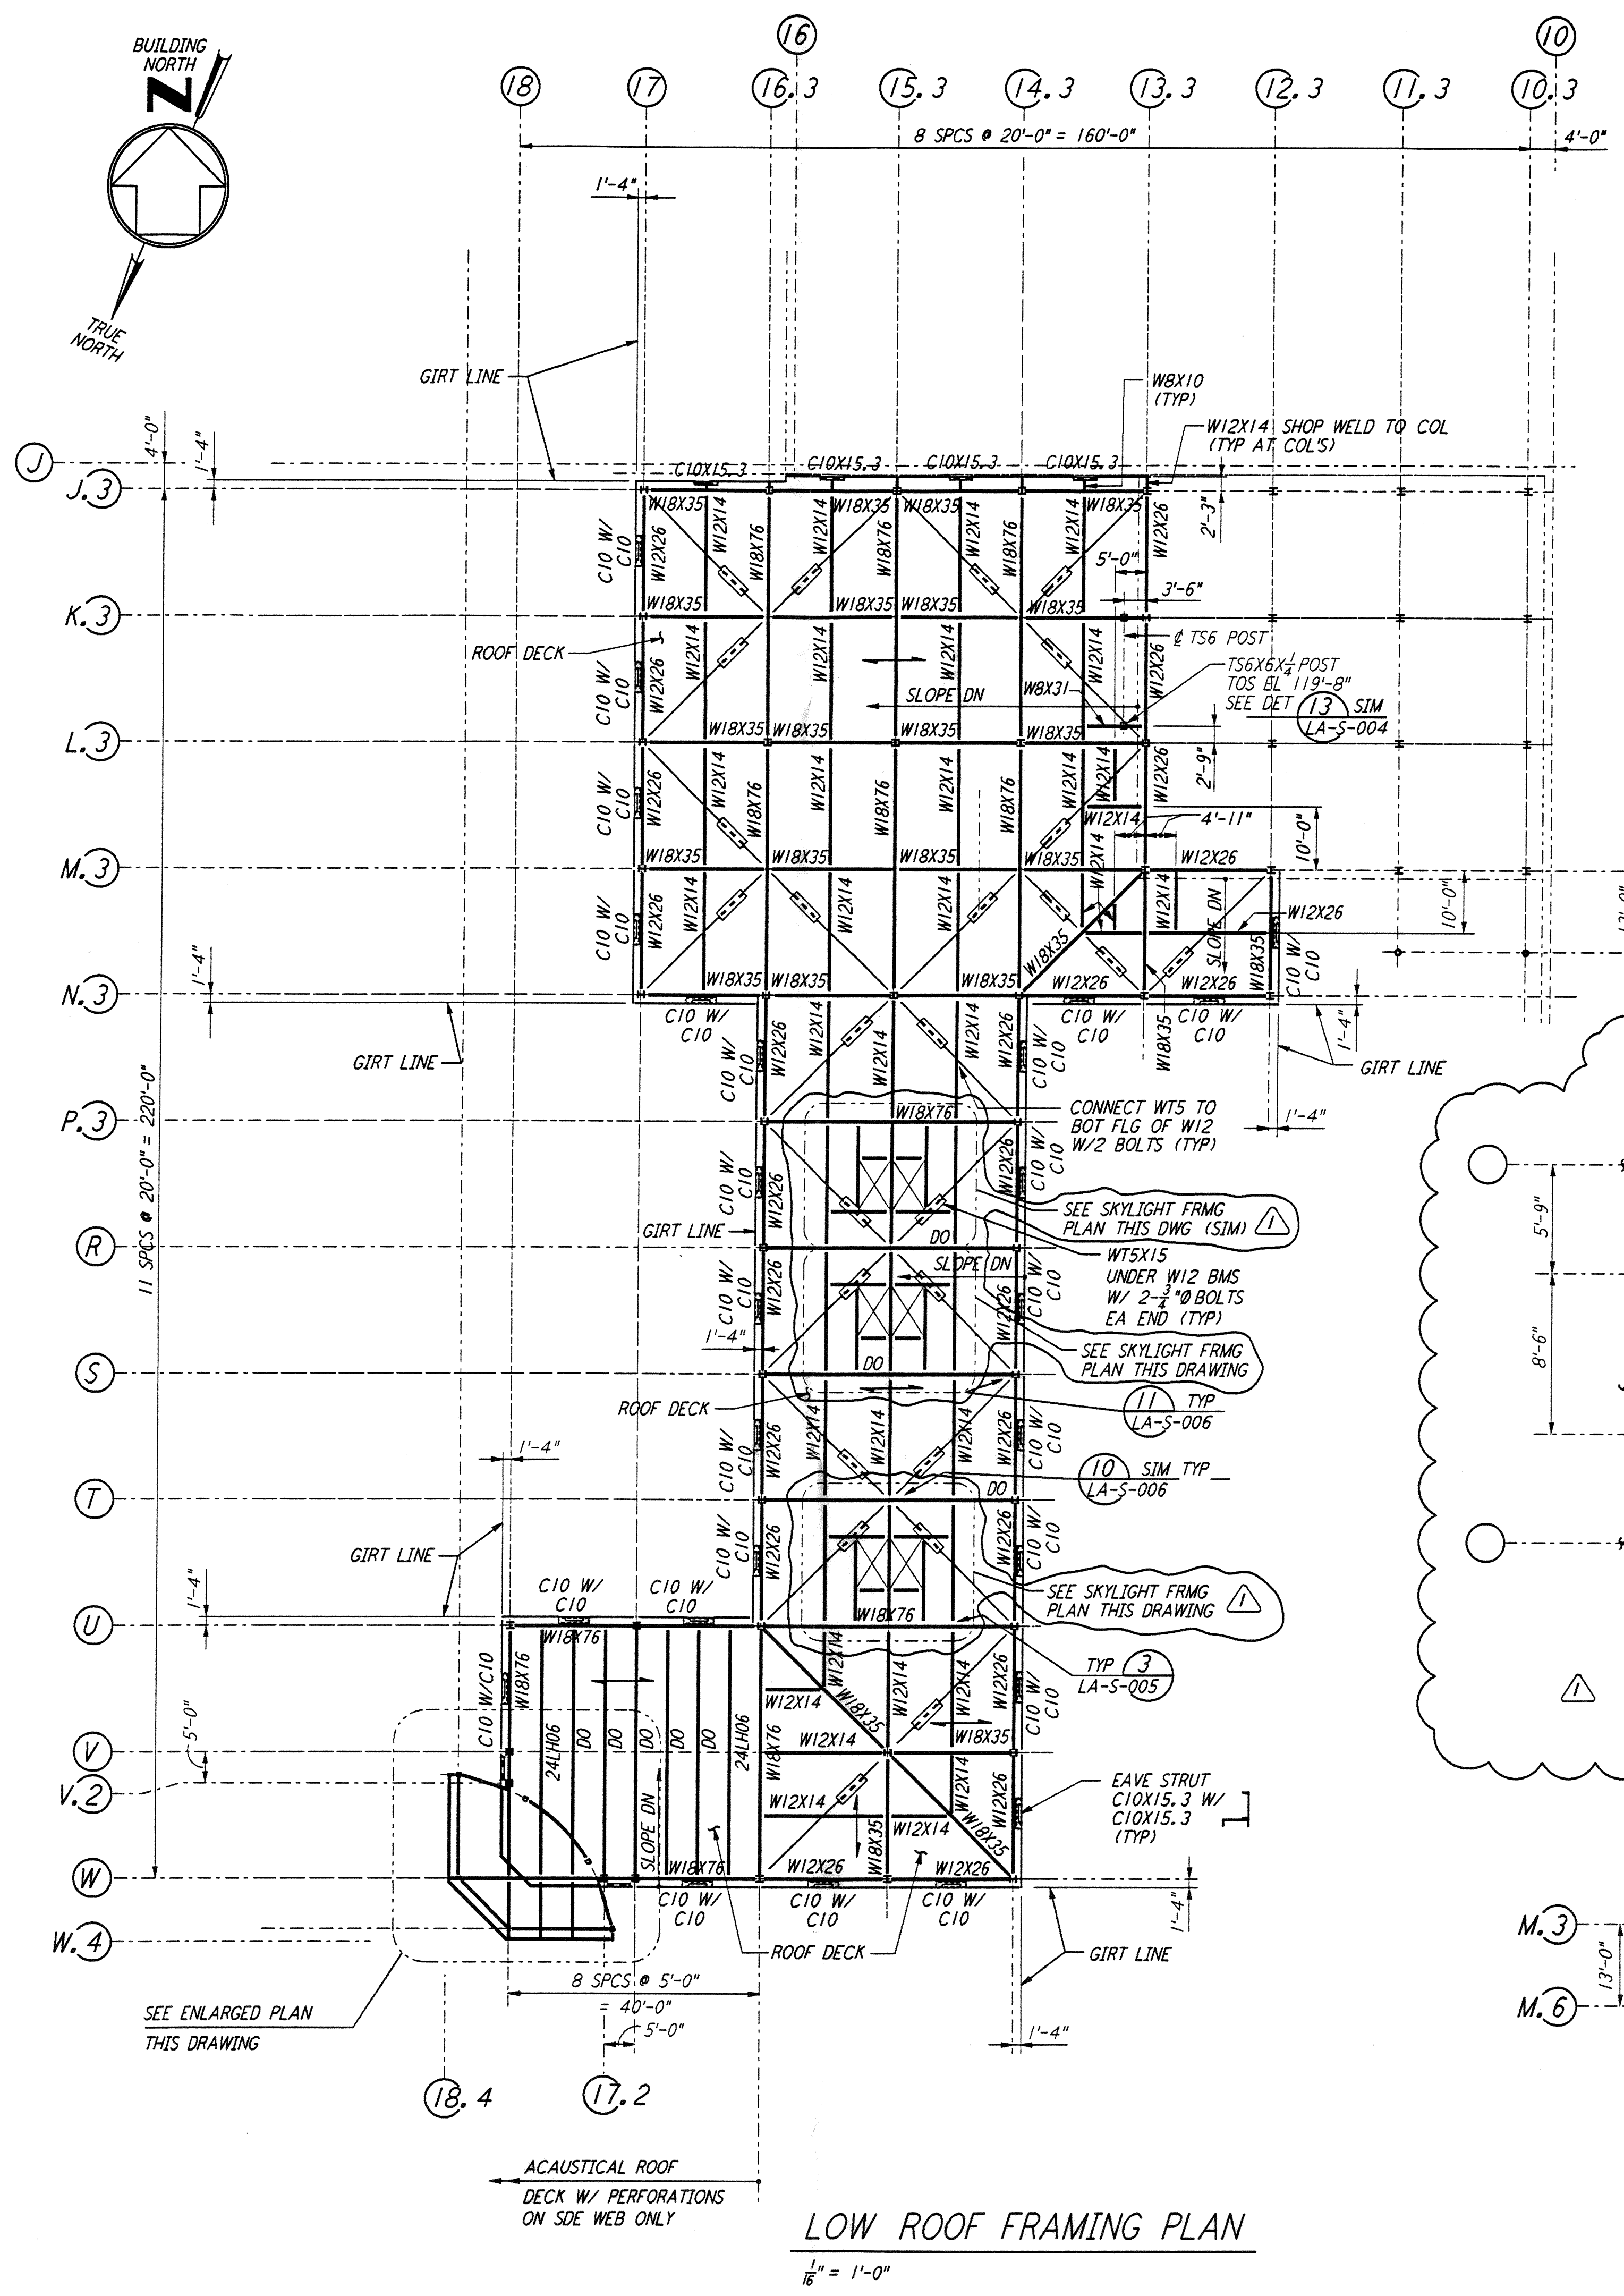


LOW ROOF FRAMING PLAN

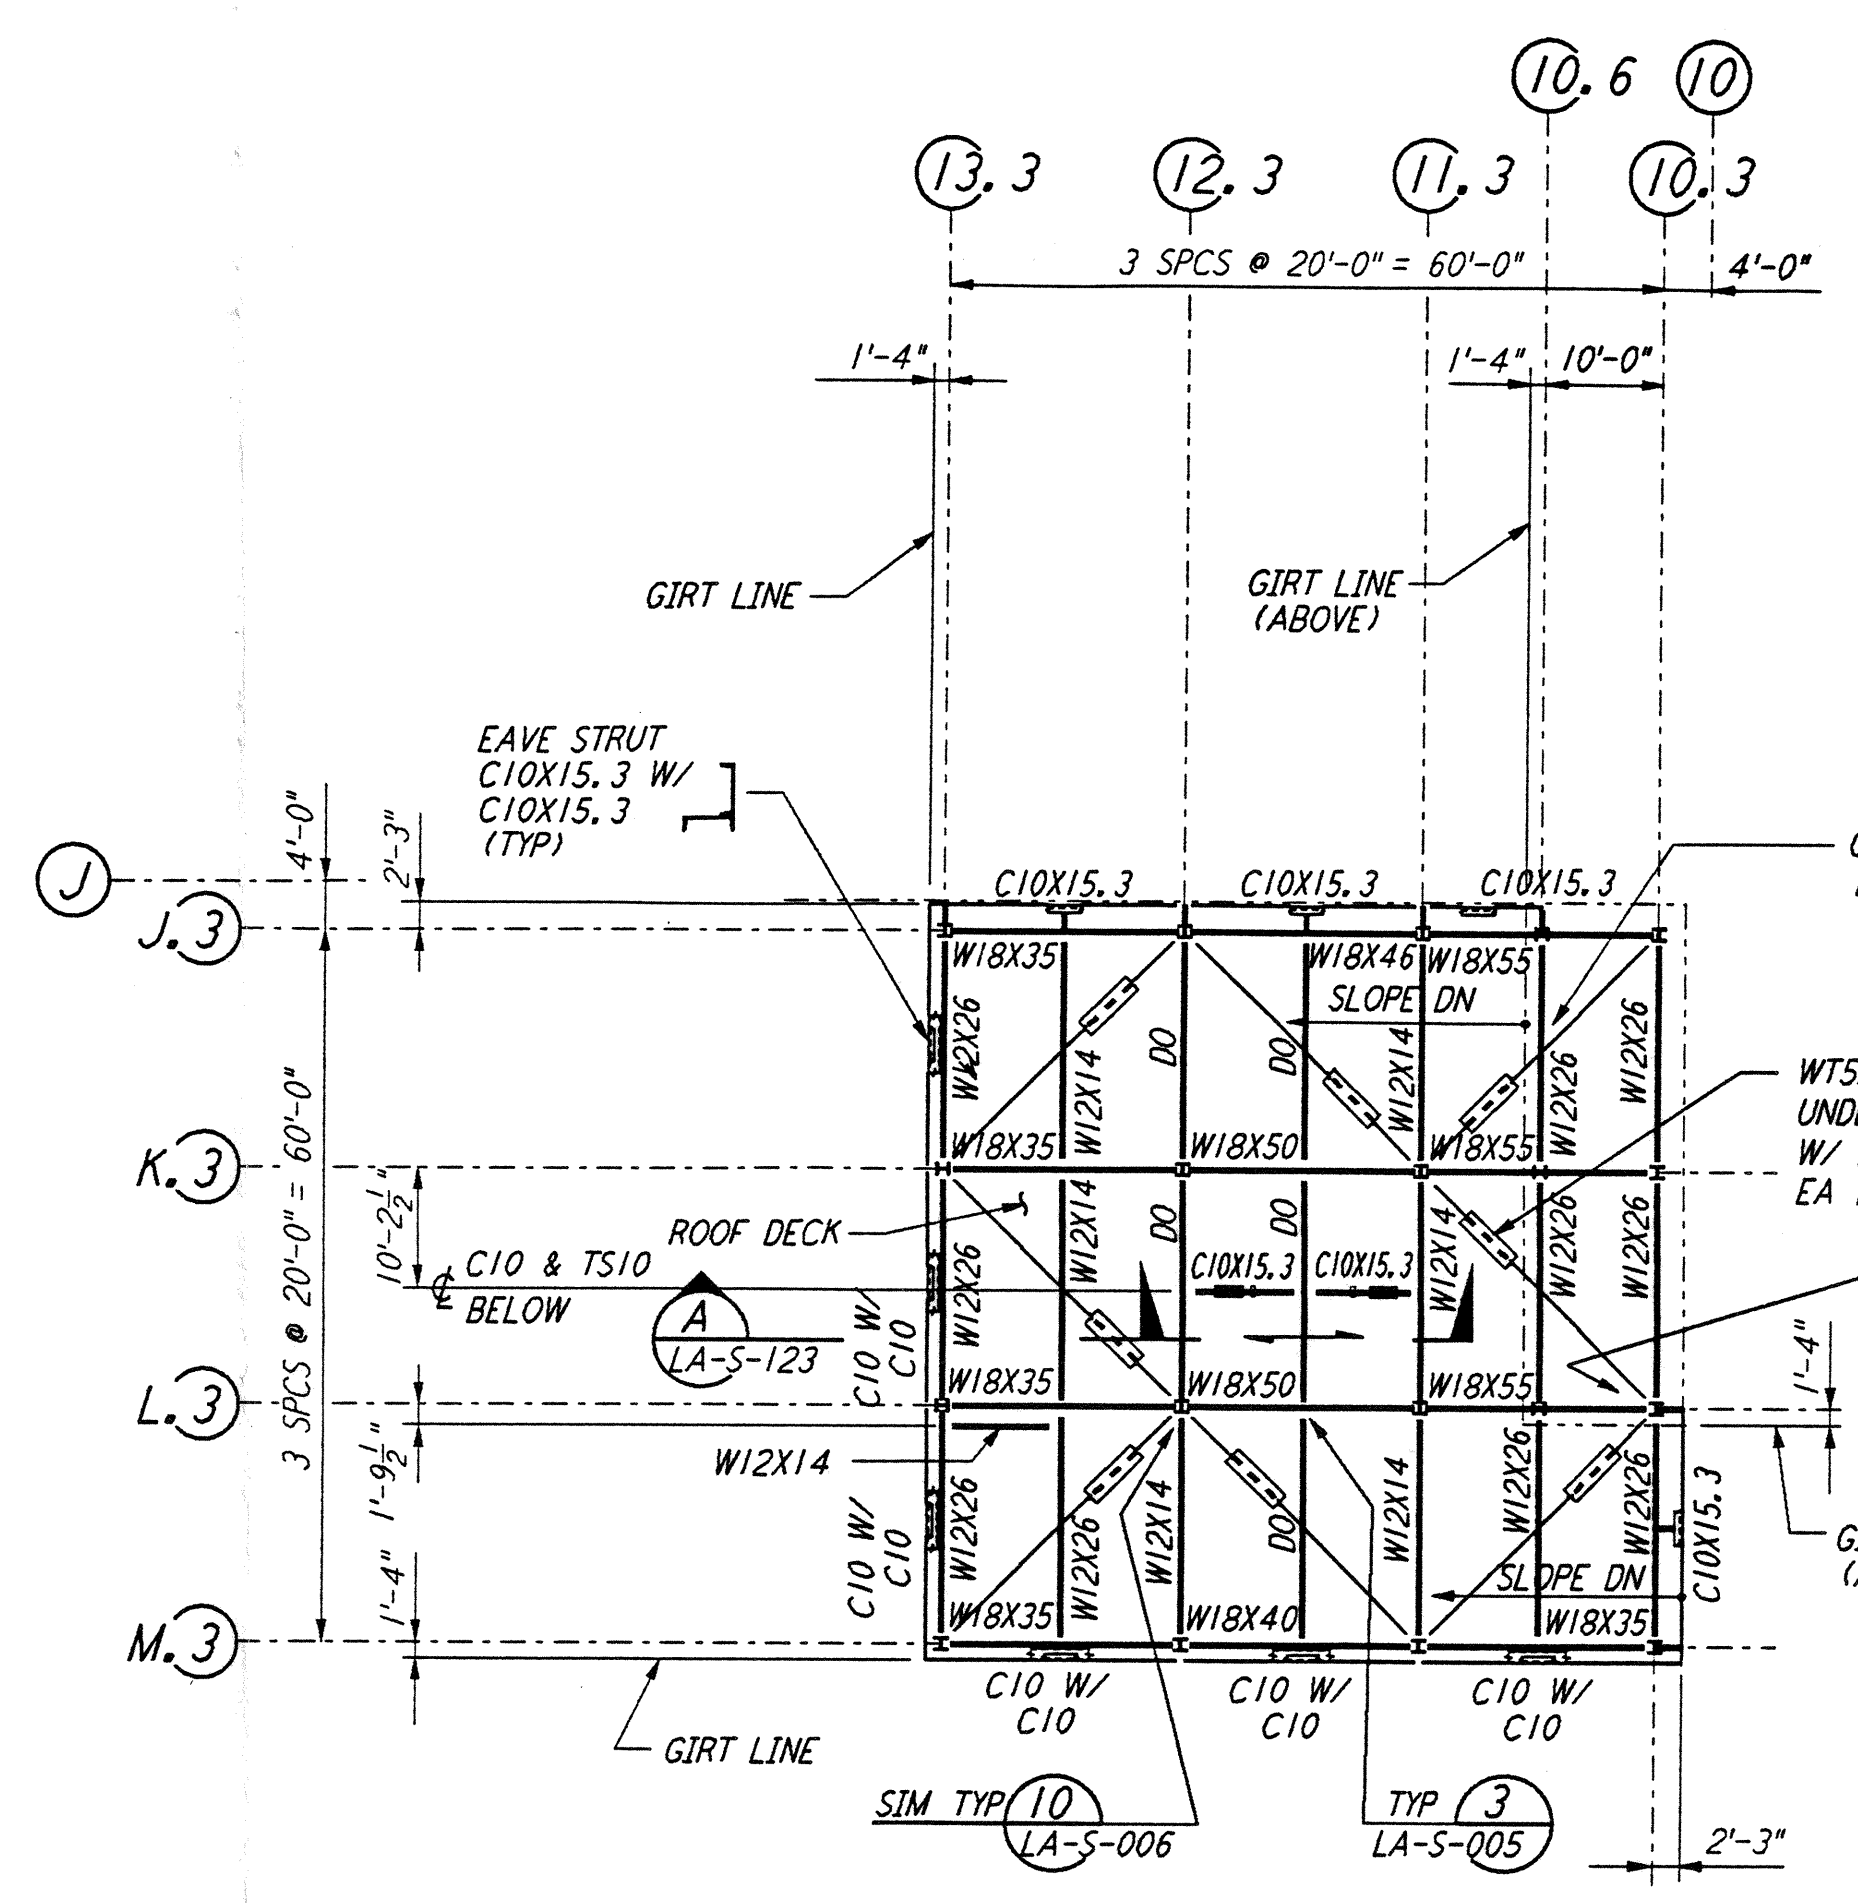


HIGH ROOF FRAMING PLAN
 1/8" = 1'-0"

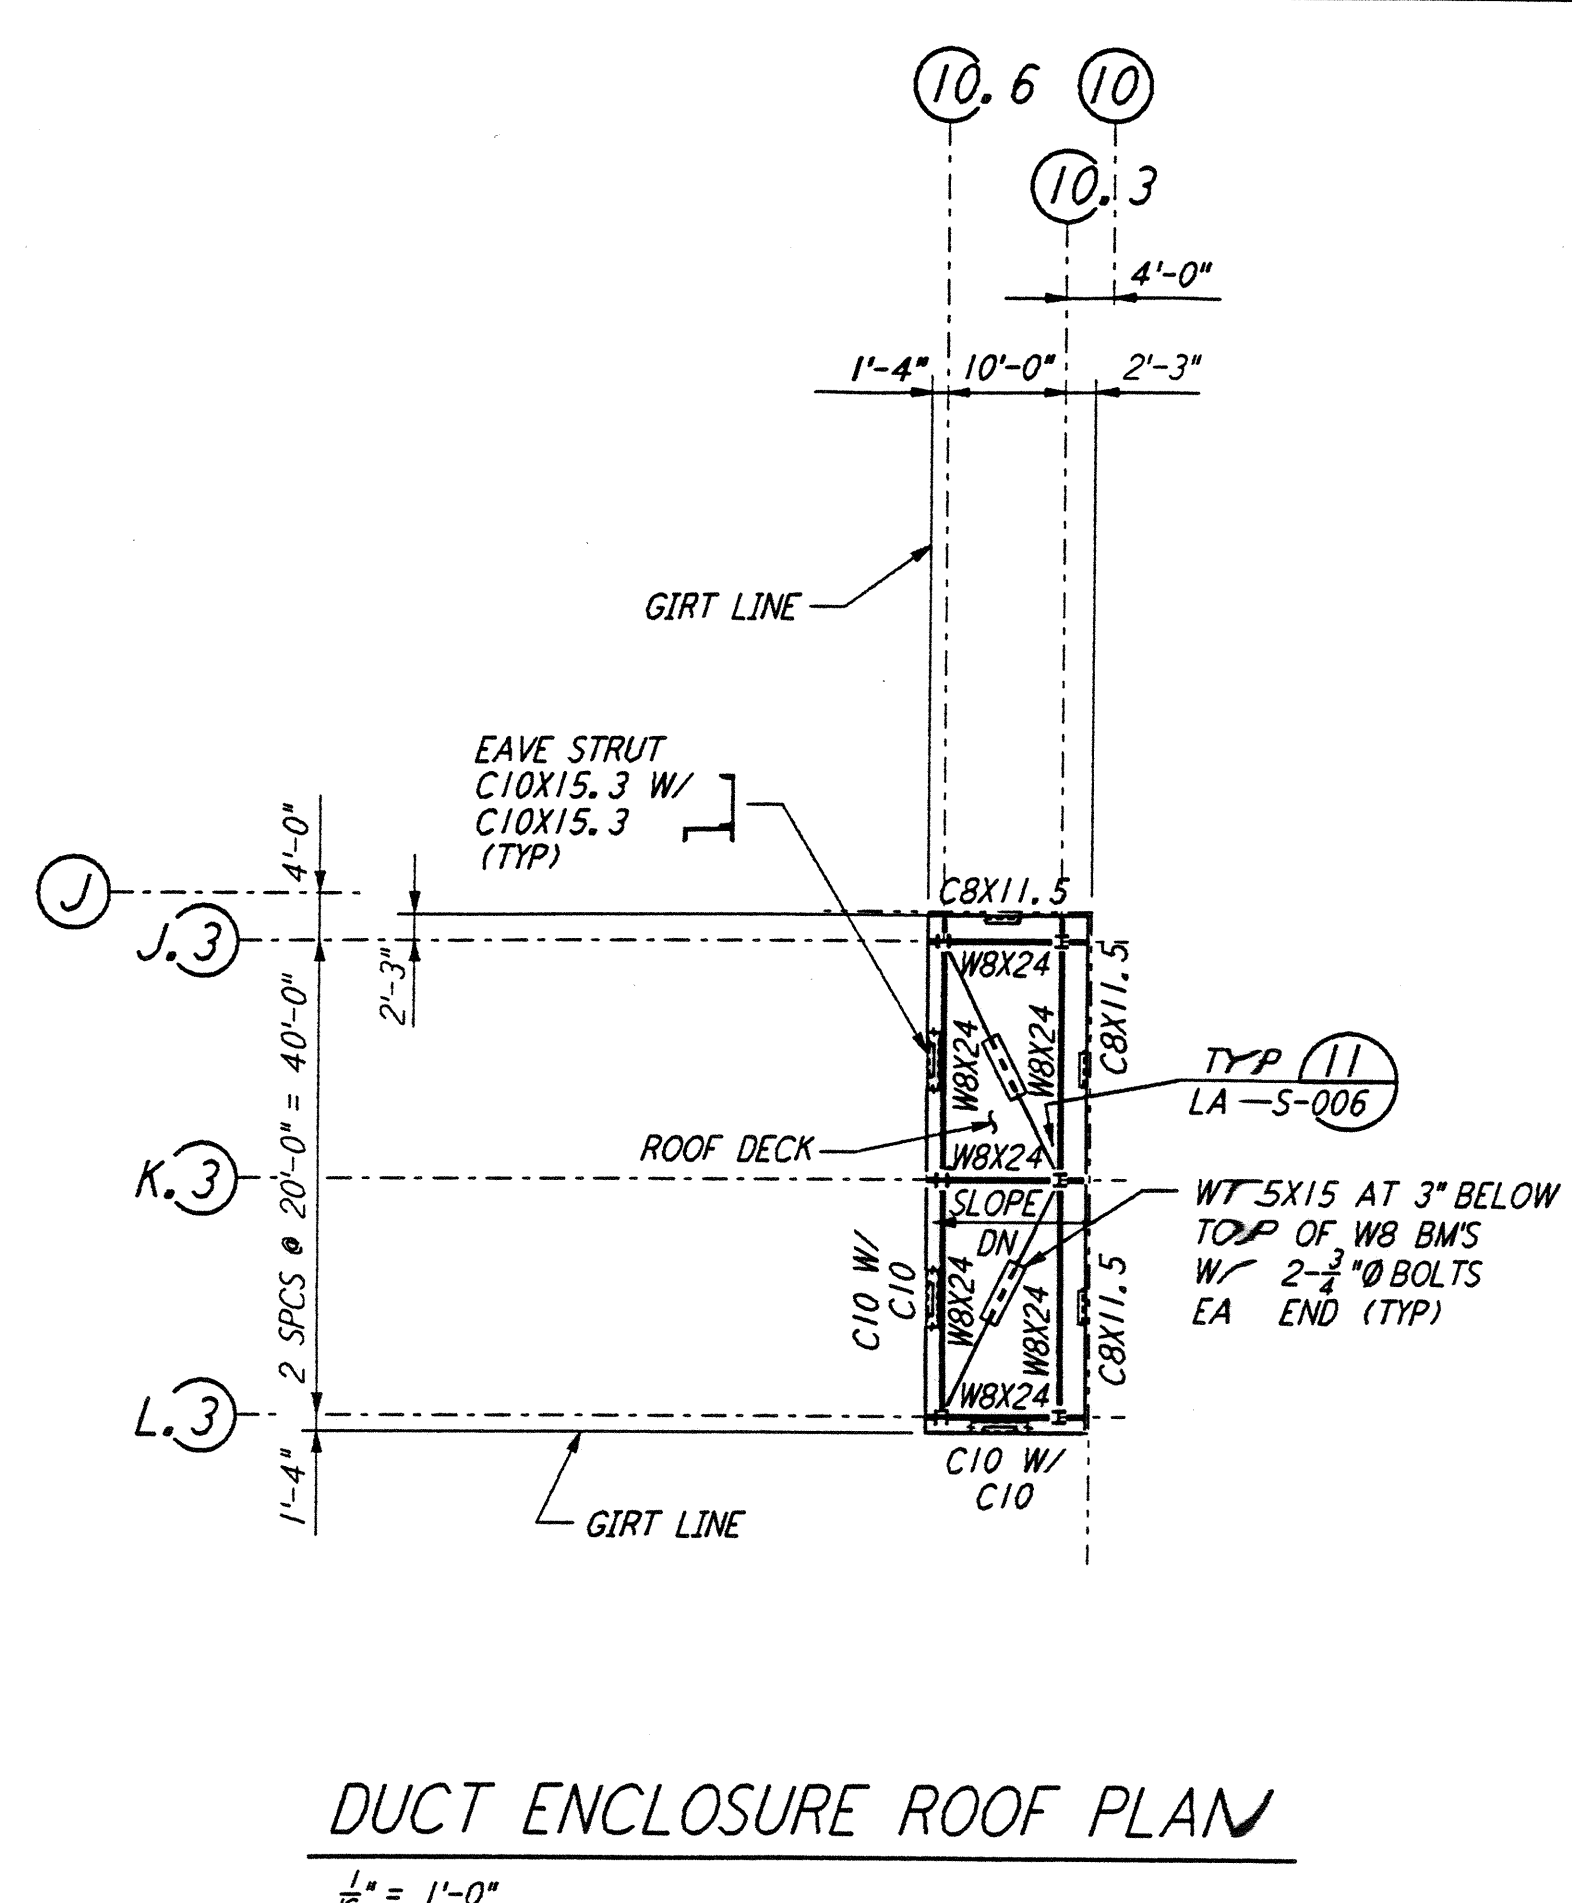


DUCT ENCLOSURE ROOF PLAN

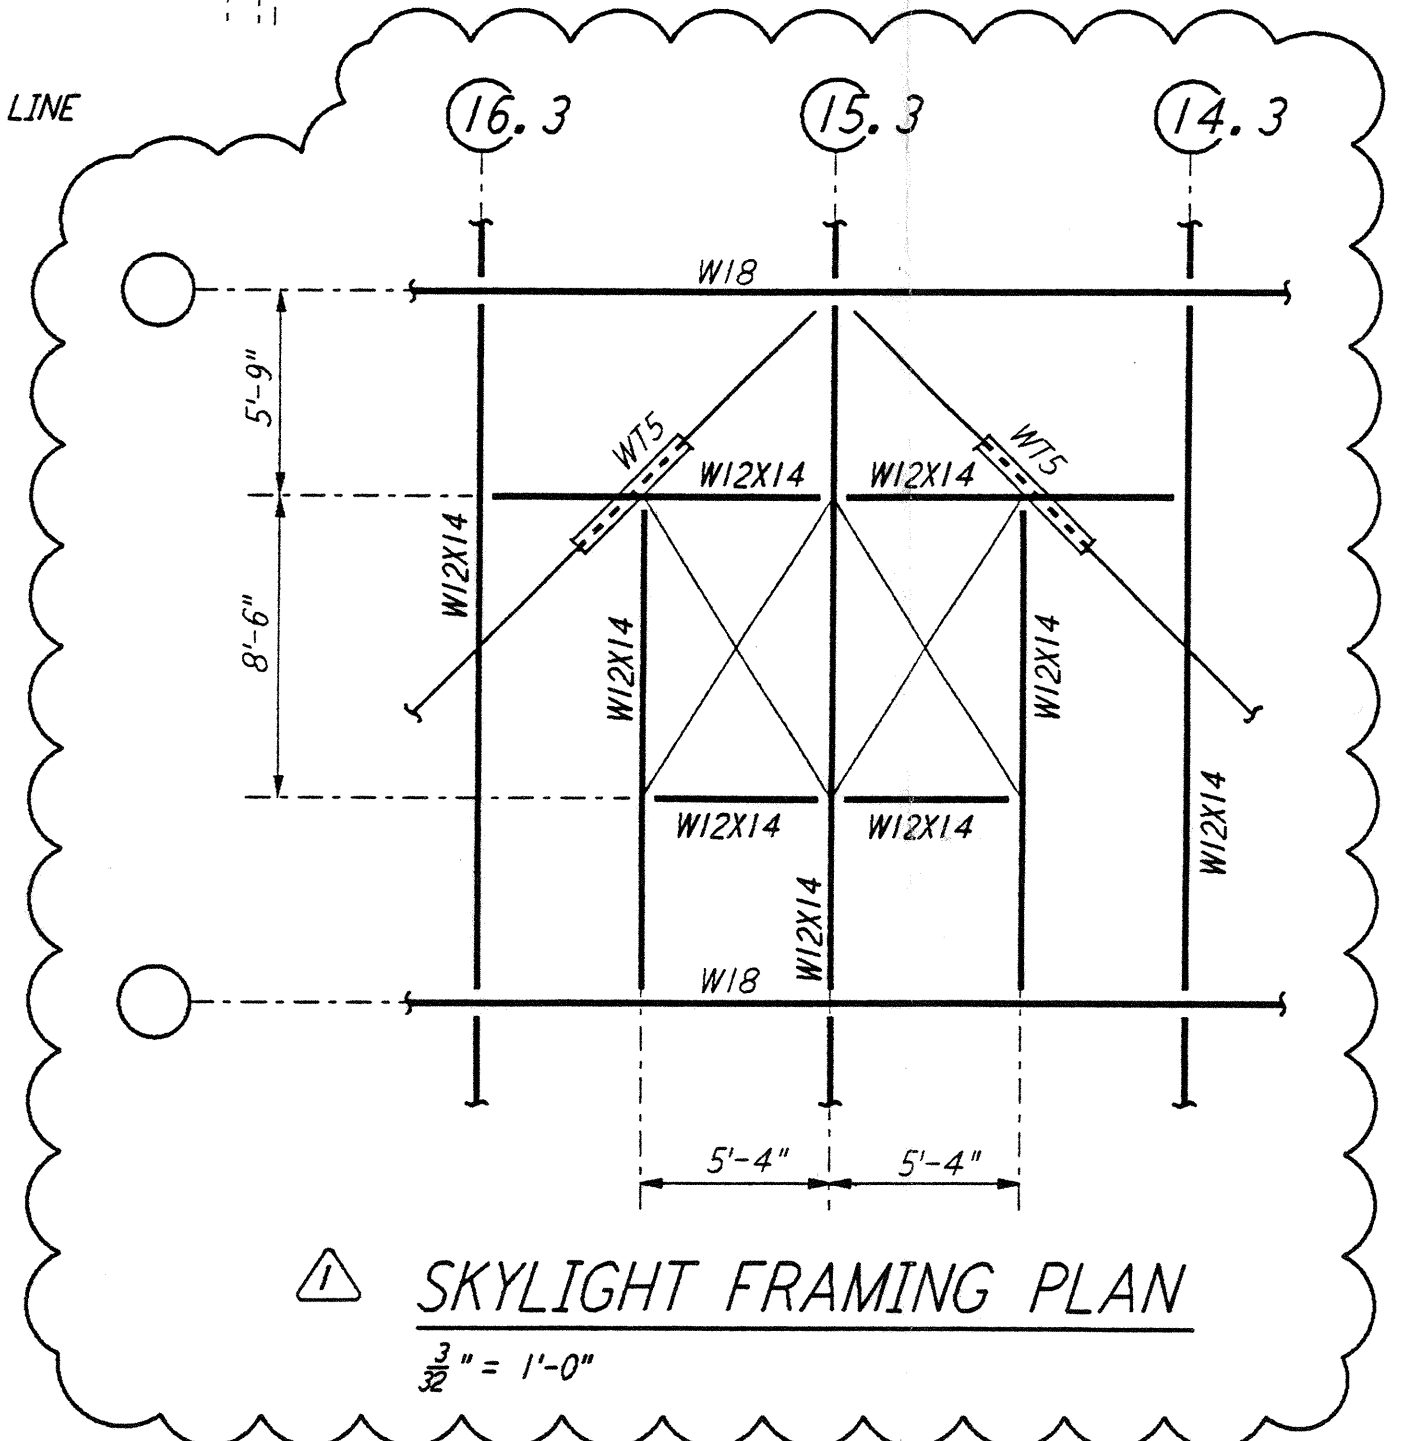

SKYLIGHT FRAMING PLAN


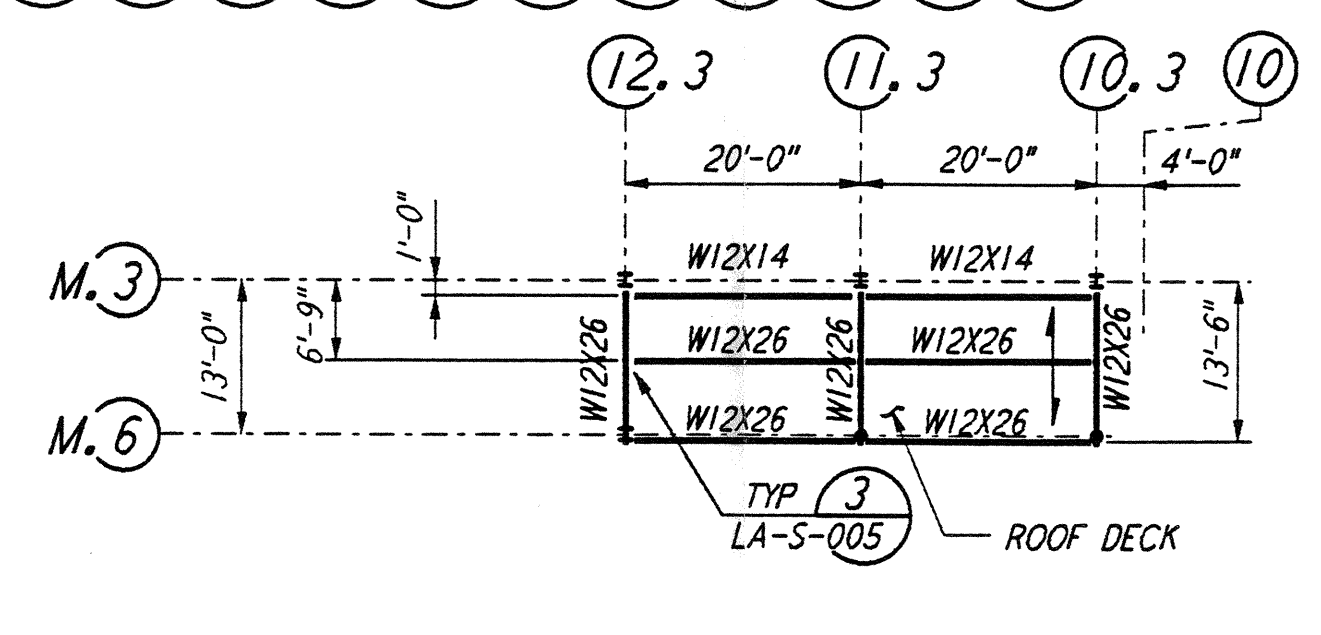


CANOPY FRAMING PLAN
 1/8" = 1'-0"

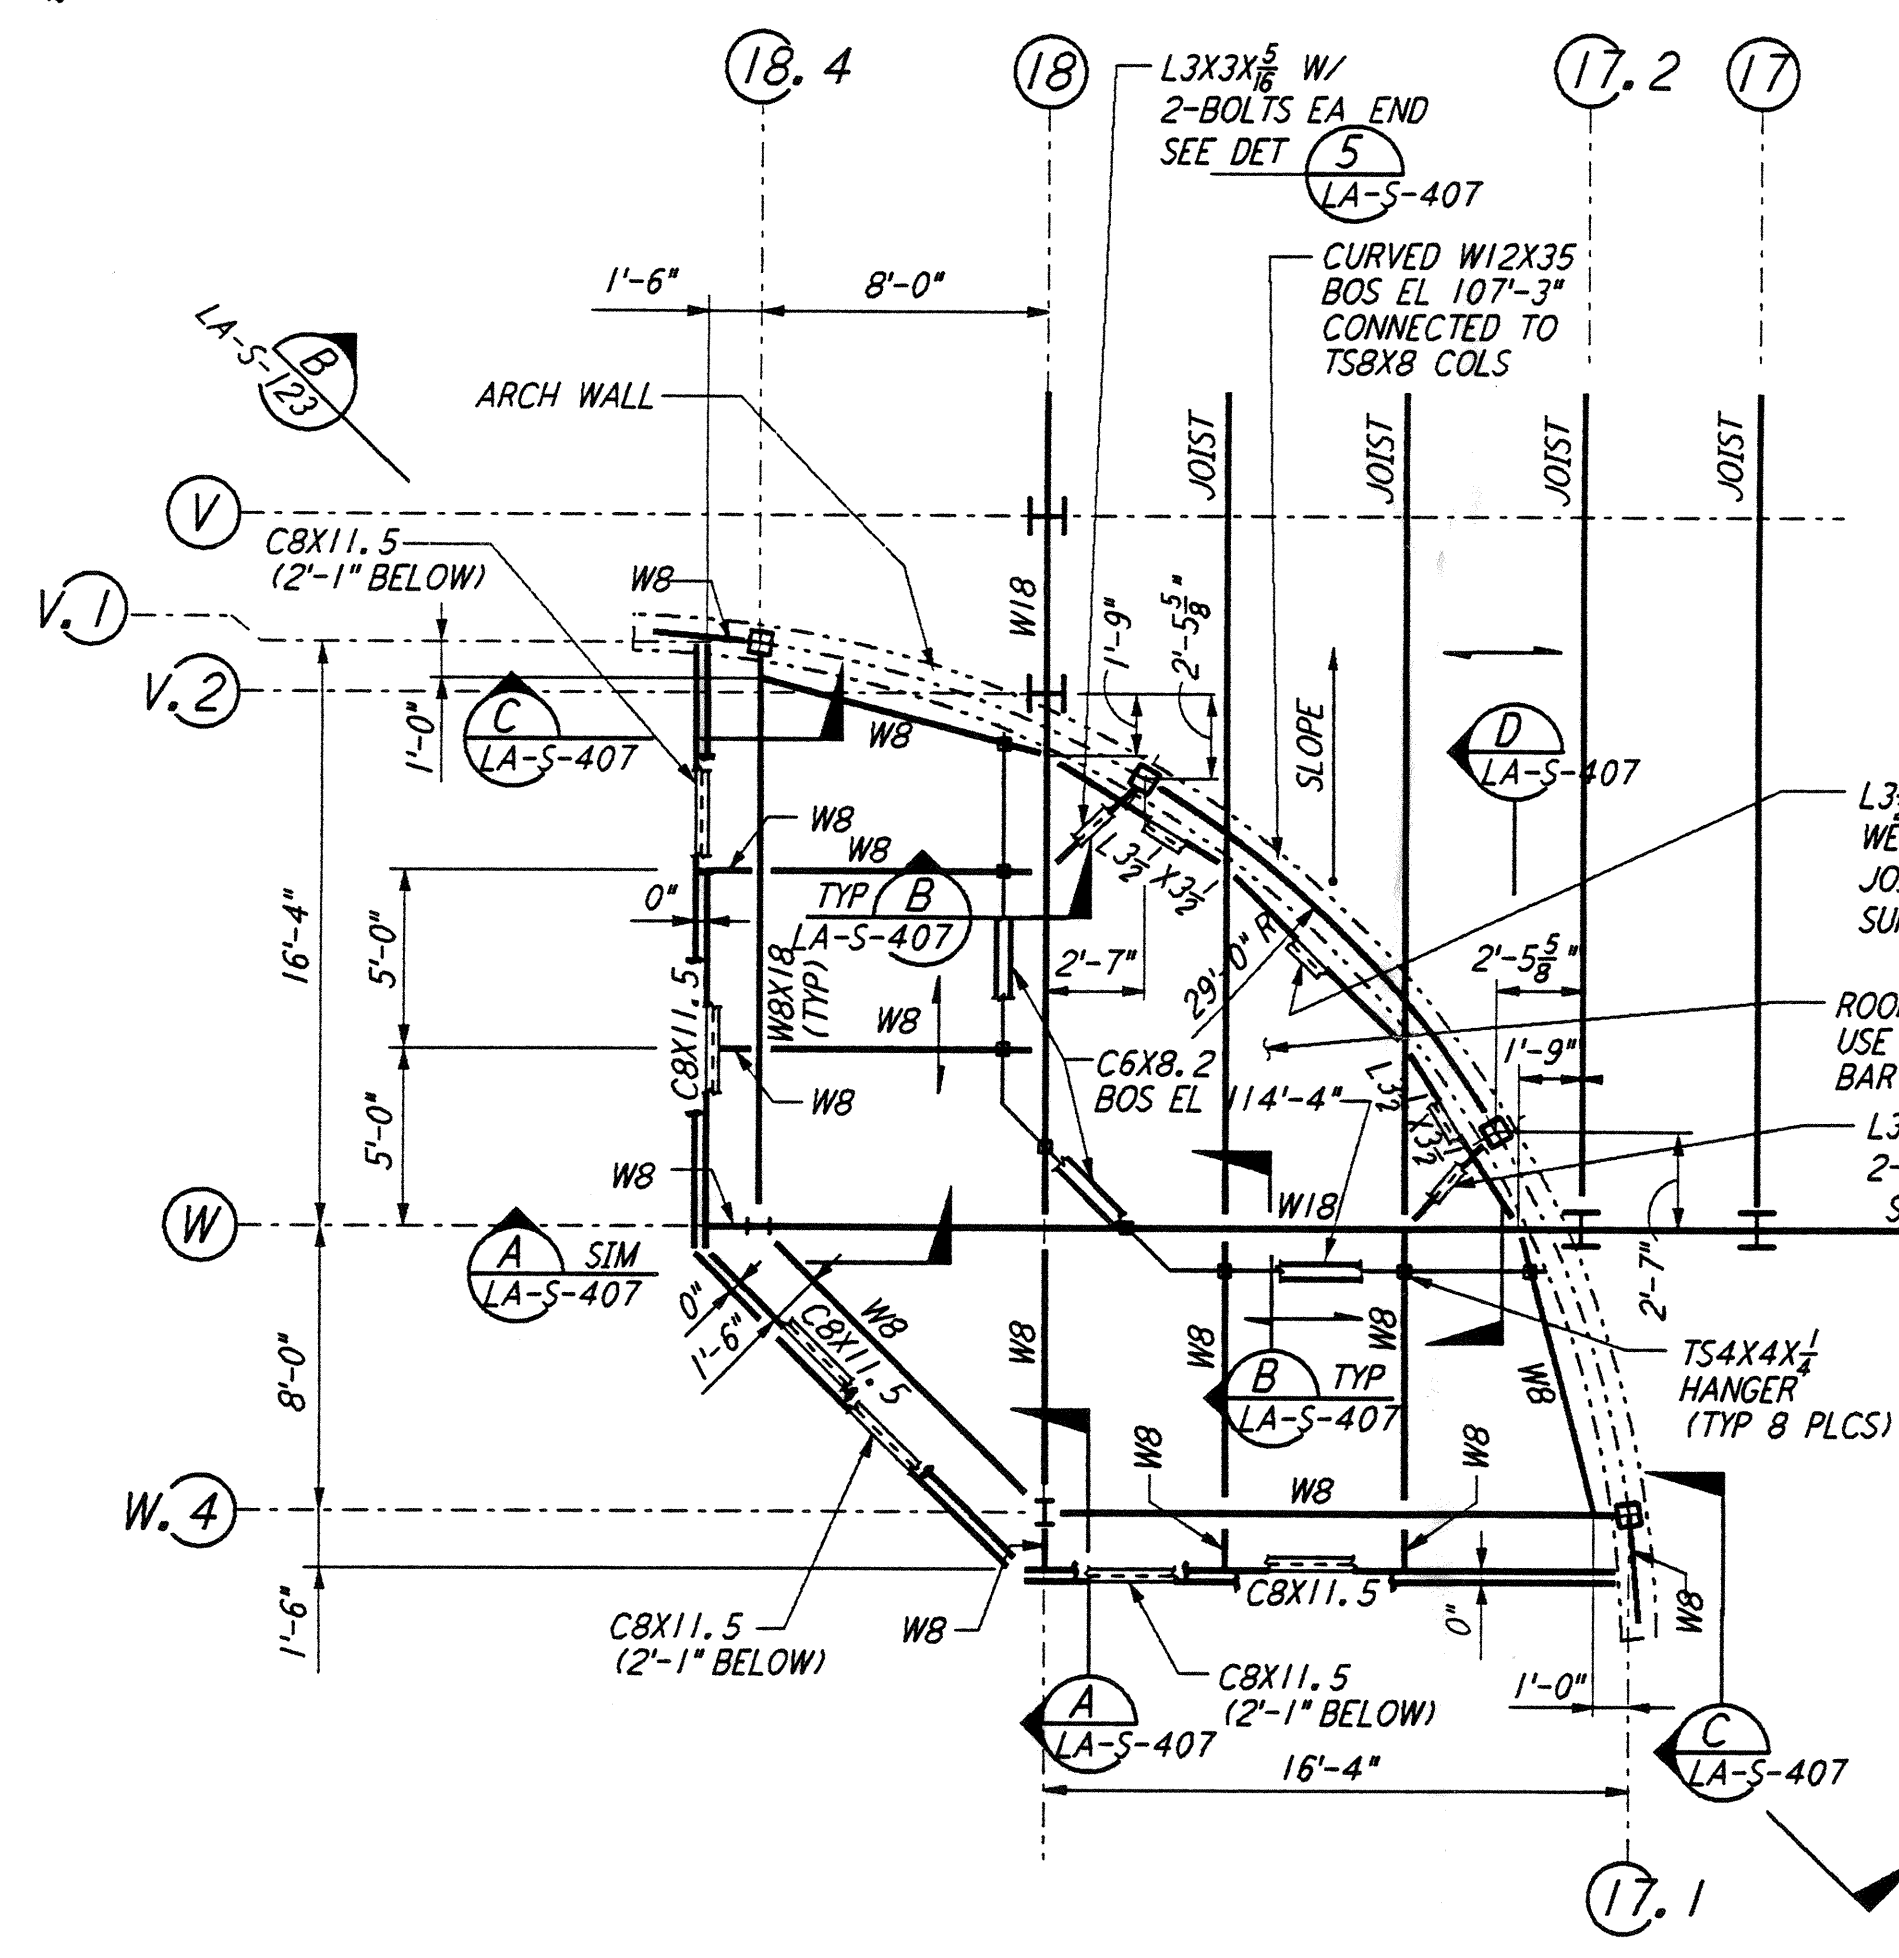

ENLARGED FRAMING PLAN
 3/8" = 1'-0"

NOTE:
 1. FOR STRUCTURAL GENERAL NOTES, ABBREVIATIONS AND LEGEND, SEE DWG LA-S-001.

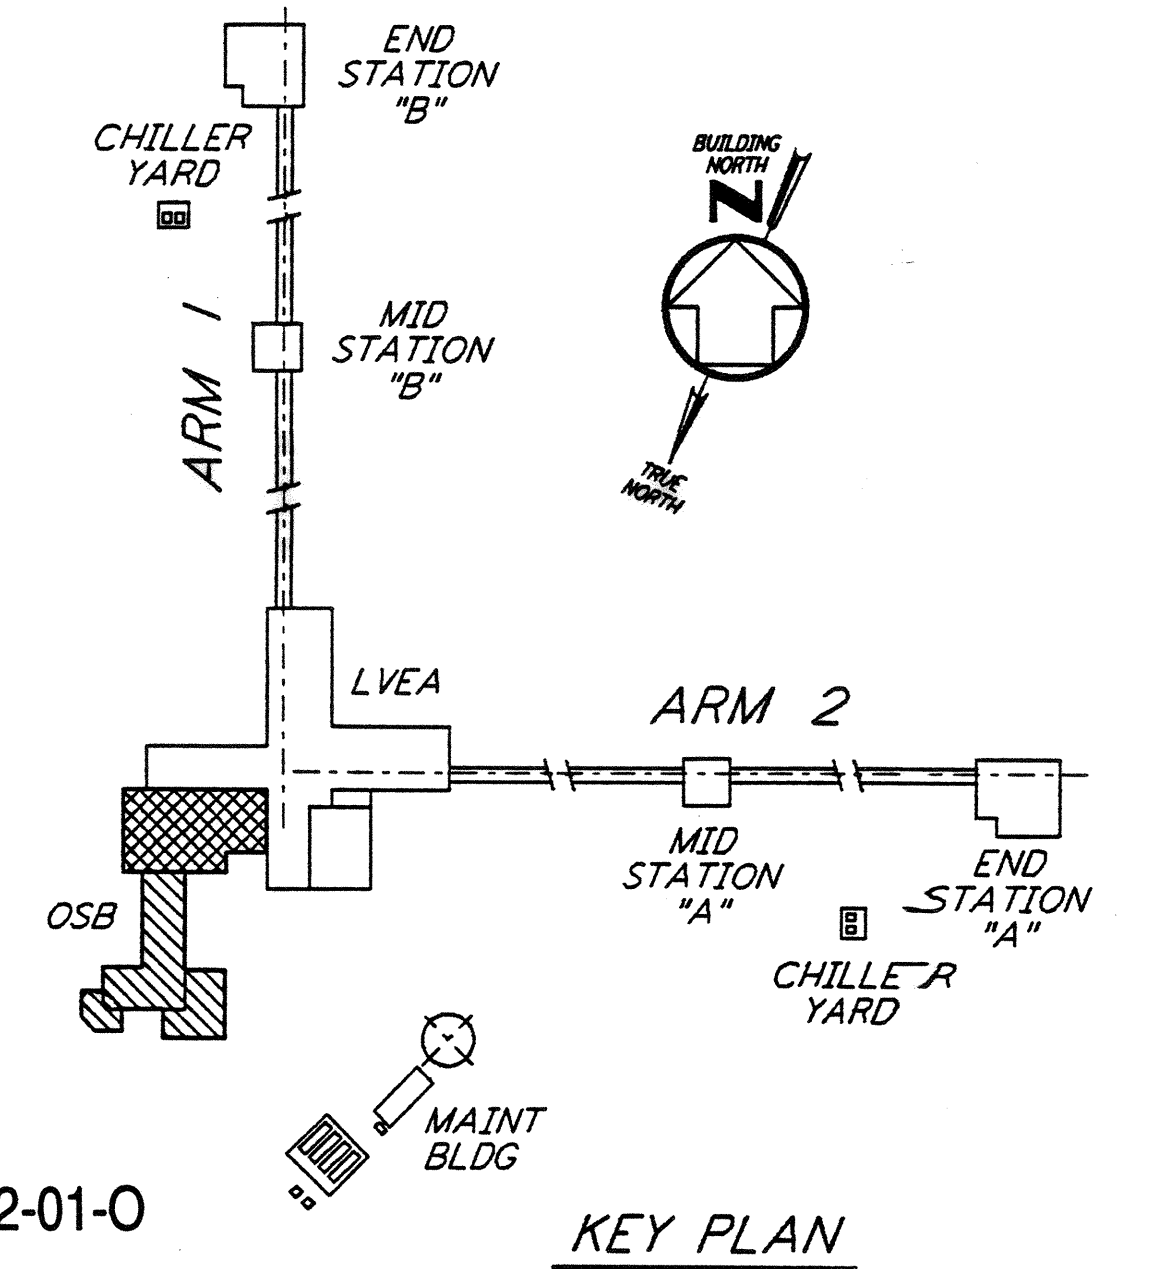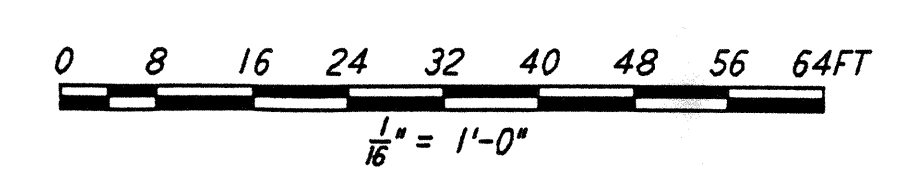


KEY PLAN

LIGO-D960932-01-0

NO.	DATE	BY	CHKD	ENGR	PROJ	DESCRIPTION
1	2-28-97	RM	A.B	HA		ADDED SKYLIGHT FRMG

NO.	DATE	BY	CHKD	ENGR	PROJ	DESCRIPTION
1	2-28-97	RM	A.B	HA		ADDED SKYLIGHT FRMG

ISSUED FOR CONSTRUCTION	DRAWN	CHECKED	ENGINEER	PROJ
MCS	DDM	BP	TDM	

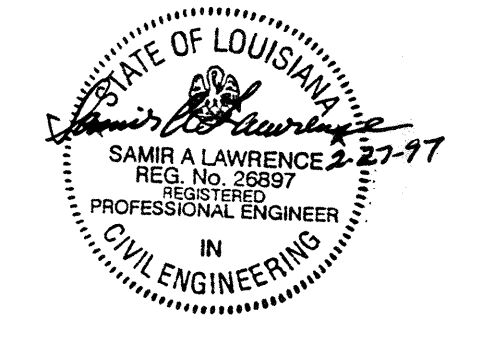

100 WEST WALNUT STREET
 PASADENA, CALIFORNIA



CALIFORNIA INSTITUTE OF TECHNOLOGY
 MASSACHUSETTS INSTITUTE OF TECHNOLOGY

LASER INTERFEROMETER
 GRAVITATIONAL-WAVE OBSERVATORY
 SITE NO. 2 - LIVINGSTON, LOUISIANA

STRUCTURAL CORNER STATION OSB ROOF FRAMING PLANS

SCALE: AS NOTED
 CONTRACT NO: PPI50969
 PROJECT NUMBER: 8094

LA-S-116