DATE: 08/13/98 TIME: 13:19:38
DESIGN FILE: I:\ligo\site2\st\las307.dgz

This document and the design it covers are the property of **PARSONS**. They are loaned only with the borrower's expressed written agreement that they will not be reproduced, copied, loaned, exhibited, or used in any other way, except by written consent from **PARSONS** to the borrower.

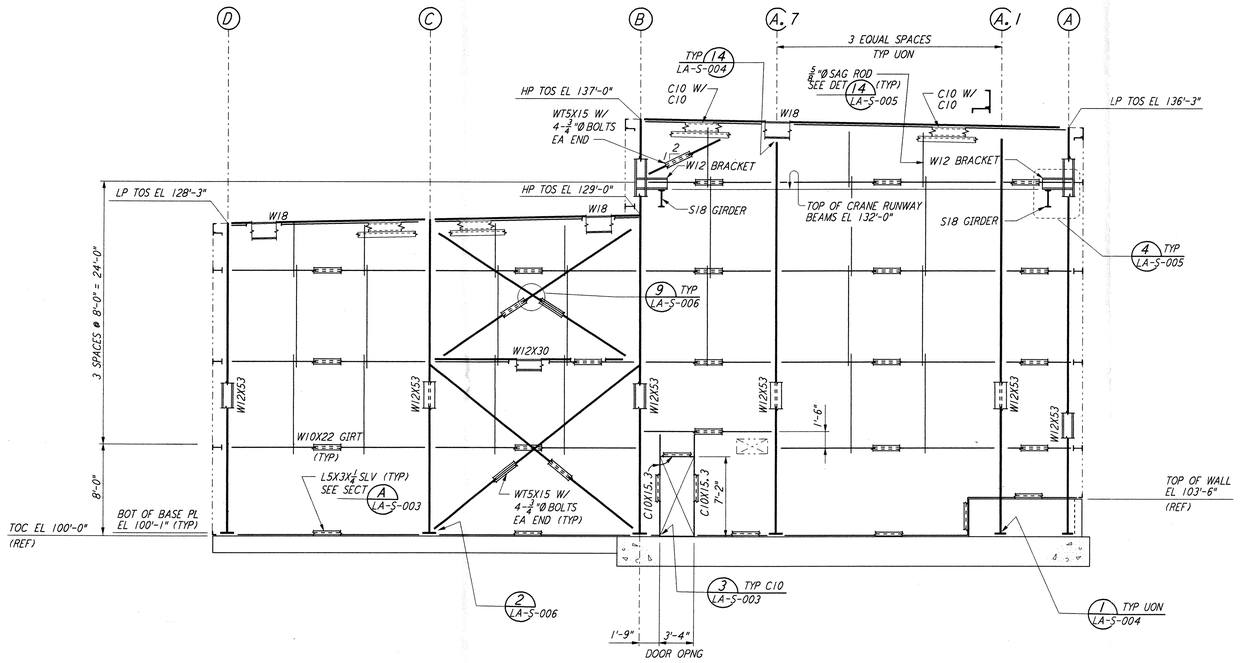

LOOKING NORTH - FOR END STATION "B" ON ARM 1
LOOKING WEST - FOR END STATION "A" ON ARM 2
ELEVATION AT COLUMN LINE 5
3/16" = 1'-0"

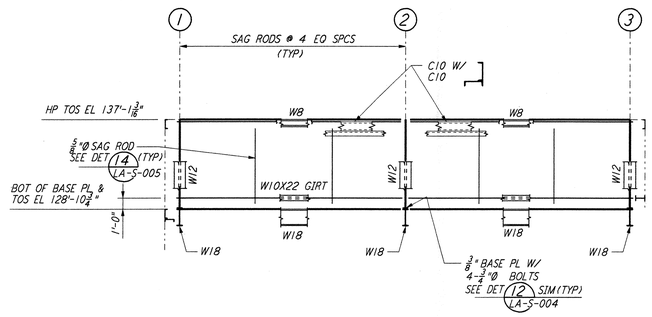

LOOKING WEST - FOR END STATION "B" ON ARM 1
LOOKING NORTH - FOR END STATION "A" ON ARM 2
ELEVATION AT COLUMN LINE B.1
3/16" = 1'-0"

NOTE:

FOR NOTES SEE DRAWING LA-S-305.

0 4 8 12 16 20FT
3/16" = 1'-0"

LIGO-D960951-01-O

REFERENCES		REVISIONS							
DRAWING NO.	DESCRIPTION	NO.	DATE	BY	CHKD	ENGR	PROJ	DESCRIPTION
		1	08-07-98	WA	[illegible]	[illegible]	[illegible]	ISSUED FOR AS-BUILT

ISSUED FOR CONSTRUCTION		
DRAWN	MCS	11-15-96
CHECKED	DDM	11-15-96
ENGINEER	BP	11-15-96
PROJ	TDM	11-15-96

AS-BUILT DRAWINGS

PARSONS
100 WEST WALNUT STREET
PASADENA, CALIFORNIA

LIGO
CALIFORNIA INSTITUTE OF TECHNOLOGY
MASSACHUSETTS INSTITUTE OF TECHNOLOGY

LASER INTERFEROMETER GRAVITATIONAL-WAVE OBSERVATORY
SITE NO. 2 - LIVINGSTON, LOUISIANA

TITLE: **STRUCTURAL END STATIONS "A" & "B" FRAMING ELEVATIONS SHEET 3**

SCALE	CONTRACT NUMBER	PROJECT NUMBER
AS NOTED	PP150969	8094

SHEET NUMBER: **LA-S-307** REVISIONS: 1

LIGOLAF.BDR

I:\LIGO\SITE2\ST\LAS307.DGZ 8-DEC-1998 13:19:01