


This document and the design it covers are the property of PARSONS. They are loaned only with the borrower's expressed written agreement that they will not be reproduced, copied, loaned, exhibited, or used in any other way, except by written consent from PARSONS to the borrower.

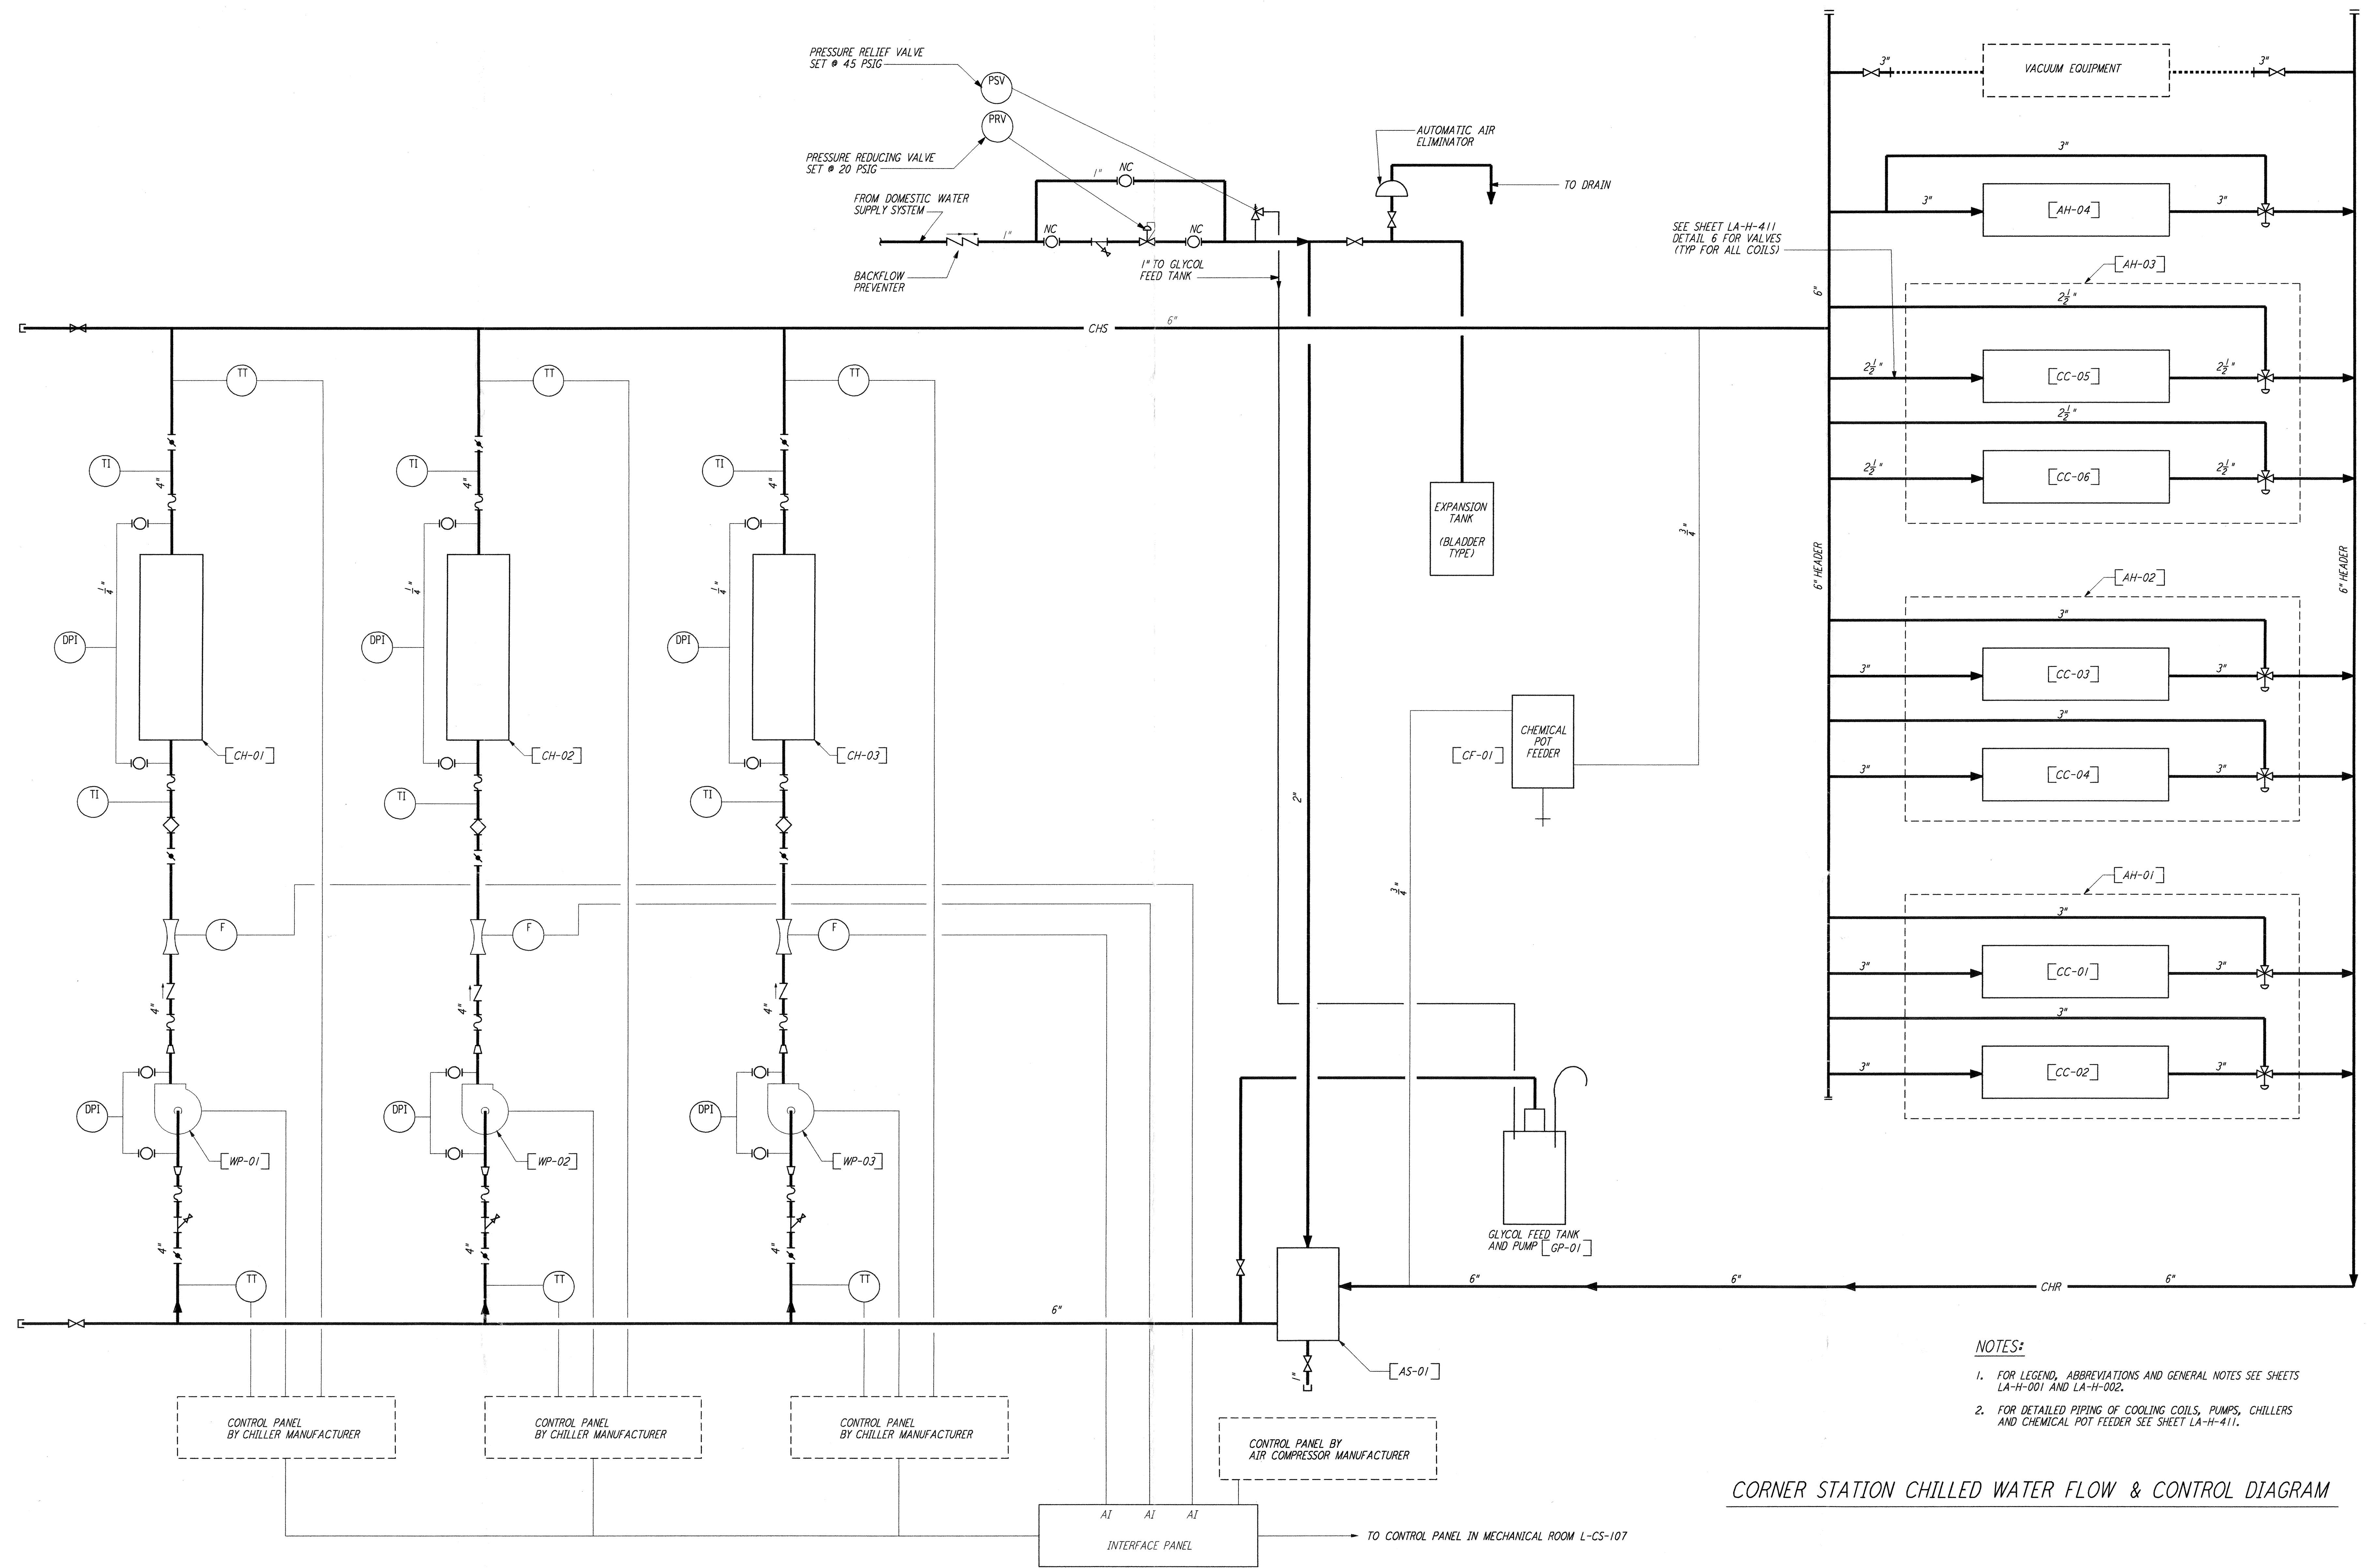



- NOTES:**
- FOR LEGEND, ABBREVIATIONS AND GENERAL NOTES SEE SHEETS LA-H-001 AND LA-H-002.
  - FOR DETAILED PIPING OF COOLING COILS, PUMPS, CHILLERS AND CHEMICAL POT FEEDER SEE SHEET LA-H-411.

**CORNER STATION CHILLED WATER FLOW & CONTROL DIAGRAM**

NO.	DATE	BY	CHKD	ENGR	PROJ	DESCRIPTION
2	5-21-99	AO	AA	AA		ISSUED AS REVISED AS-BUILT
1	8-7-98	DJB	AA	AA	MDW	ISSUED FOR AS-BUILT

ISSUED FOR CONSTRUCTION  
 DRAWN CLP 11-15-96  
 CHECKED MN 10-25-96  
 ENGINEER AA 1-23-96  
 PROJ TDM 11-15-96

**AS-BUILT DRAWINGS**

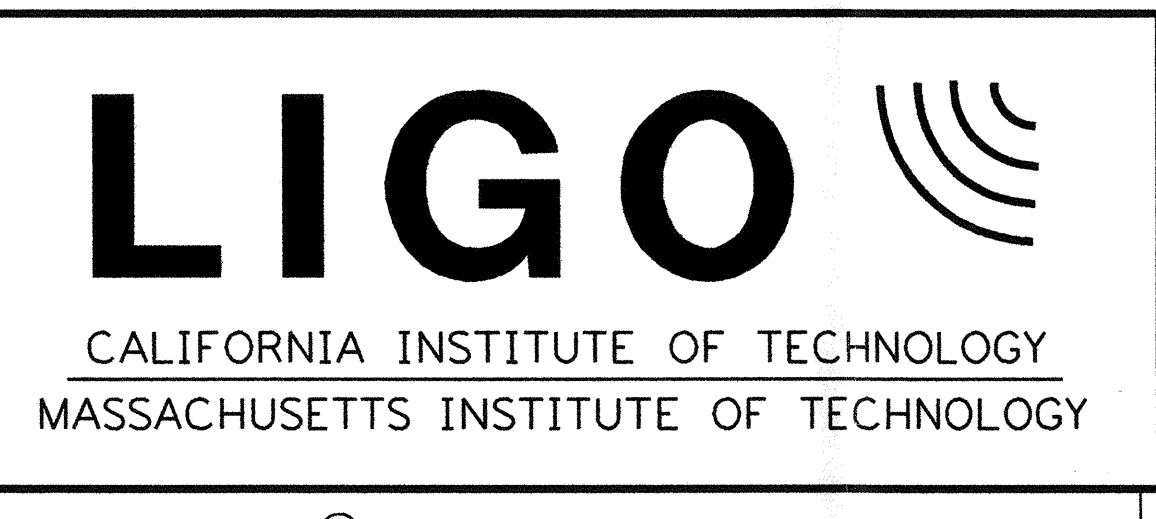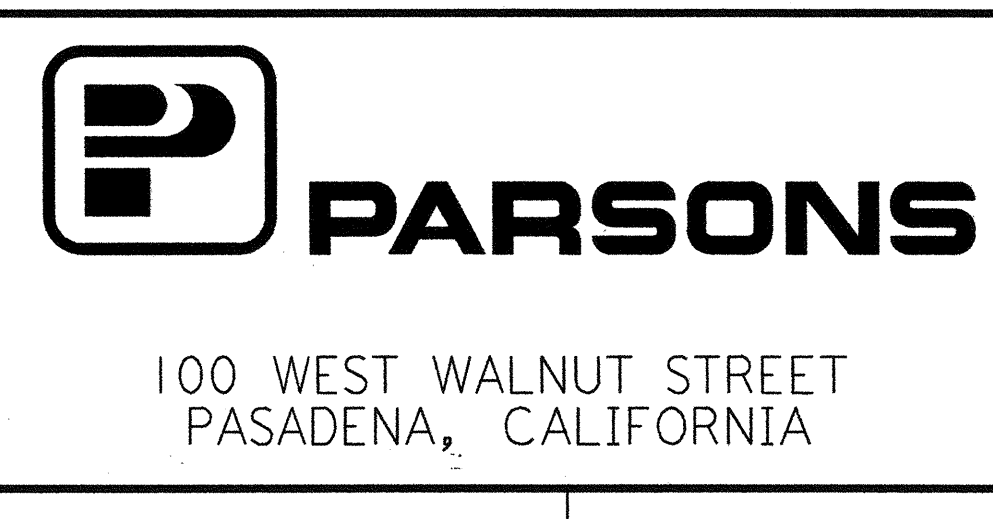

**LIGO-D960974-02-O**

LASER INTERFEROMETER  
 GRAVITATIONAL-WAVE OBSERVATORY  
 SITE NO.2 - LIVINGSTON, LOUISIANA

HVAC  
 CORNER STATION  
 CHILLED WATER  
 FLOW DIAGRAM

TITLE: NONE CONTRACT NUMBER: PPI50969 PROJECT NUMBER: 8094  
 SHEET NUMBER: LA-H-121