DATE: 02/25/97 TIME: 17:09:13
DESIGN FILE: I:\ligo\site2\ee\lae110.d3z

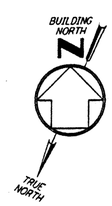

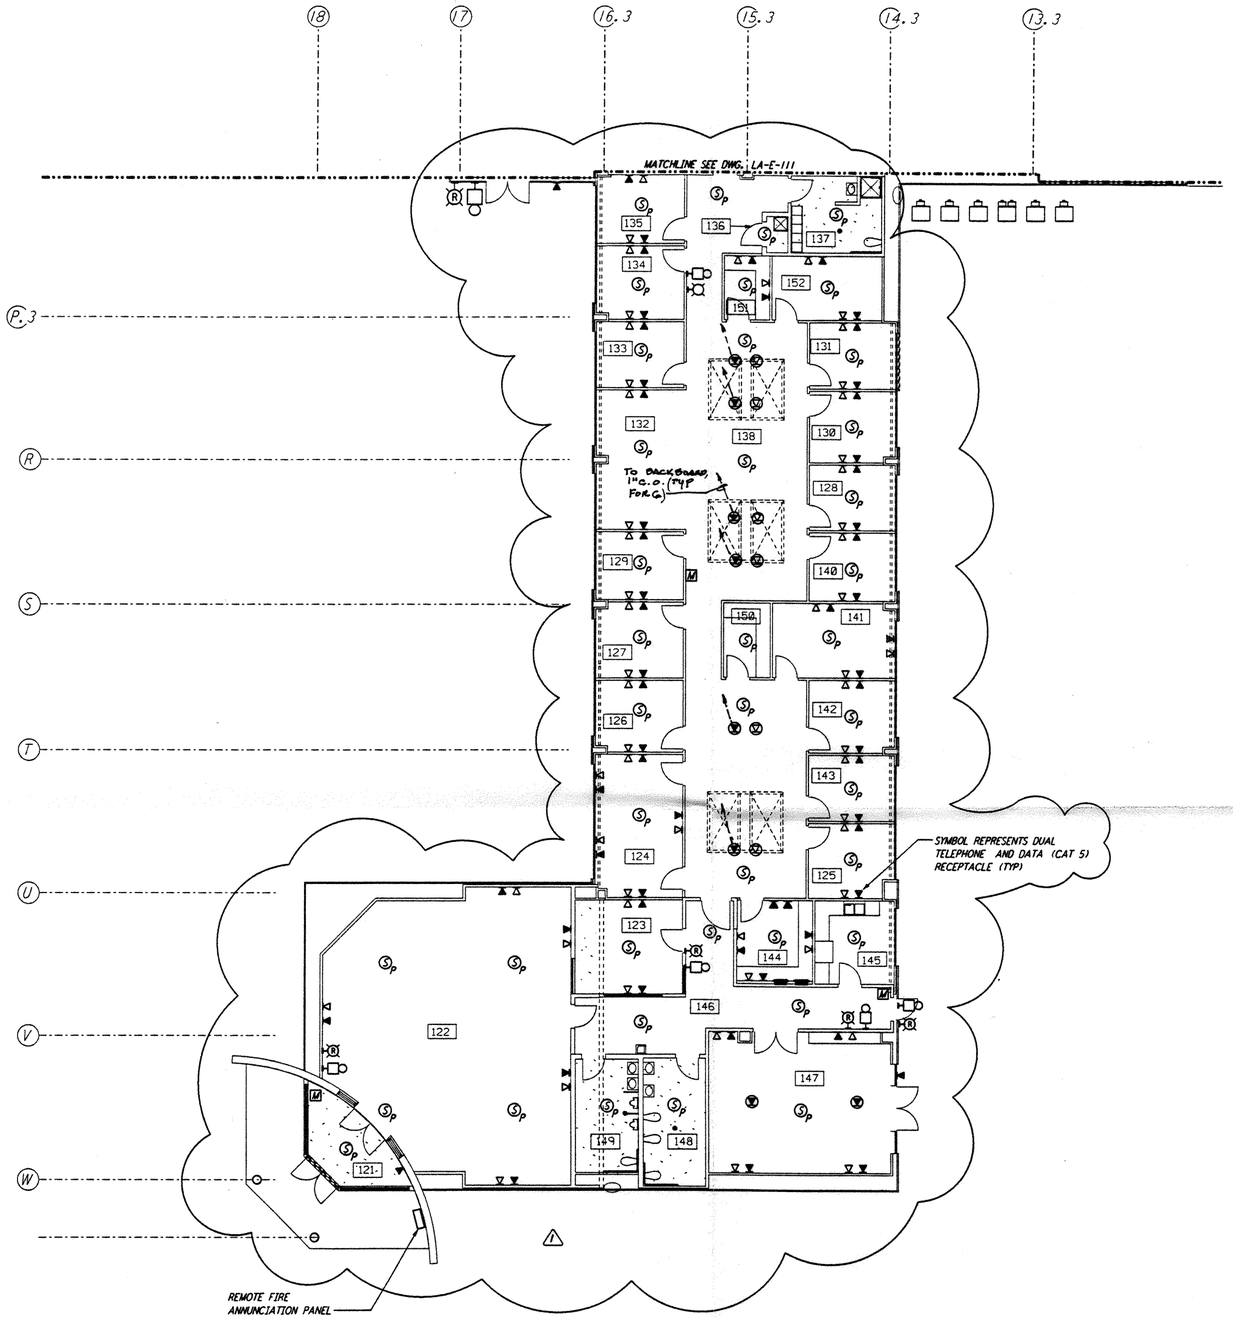

NOTES:

1. FOR PLAN SYMBOLS SEE DWG LA-E-002.
2. WIRING FOR FIRE DETECTION SHALL BE CLASS "A". FOR FIRE ALARM DEVICES SHALL BE CLASS "B". WIRING INSTALLED IN CONCEALED CONDUIT FOR FIRE DETECTION AND SECURITY SYSTEMS SHALL BE DONE BY OTHERS.
3. DUCT MOUNTED SMOKE DETECTORS SHALL BE PROVIDED WITH AN AUXILIARY RELAY CONTACT (N.C.) FOR EQUIPMENT SHUT-DOWN.
4. COORDINATE AHU LOCATIONS WITH DUCT MOUNTED SMOKE DETECTORS.
5. TELEPHONE AND DATA RECEPTACLES SHOWN IN MIDDLE OF ROOMS SHALL BE PROVIDED WITH INBEDDED 3/4" CONDUIT TO NEAREST PERMANENT WALL. WITH RISER TO ABOVE CEILING CAVITY.
6. DATA AND PHONE LINES SHALL BE HOMERUN FROM WALL AND FLOOR RECEPTACLES TO BACKBOARD IN ROOM 163.
7. WIRE RUNS IN CEILING CAVITY SHALL BE ORDERLY.

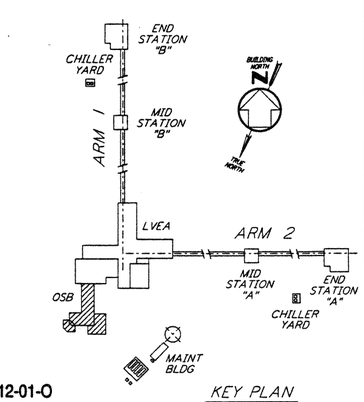

KEY PLAN

0 8 16 24 32FT
1/8" = 1'-0"

LIGO-D961012-01-O

This document and the design it covers are the property of **PARSONS**. They are loaned only with the borrower's expressed written agreement that they will not be reproduced, copied, loaned, exhibited, or used in any other way, except by written consent from **PARSONS** to the borrower.

REFERENCES

DRAWING NO.	DESCRIPTION

REVISIONS

NO.	DATE	BY	CHKD	ENGR	PROJ	DESCRIPTION
1	2-28-97	J.G.	RGC	TBP/[illegible]		GENERAL REVISIONS

ISSUED FOR CONSTRUCTION		
DRAWN	M.M.	11-15-96
CHECKED	J.C.L.	7-24-96
ENGINEER	K.C.R.	10-25-96
PROJ	T.D.M.	11-15-96

Wai C. Y. Tsang 4/27/97
DIP 9/30/96

PARSONS
100 WEST WALNUT STREET
PASADENA, CALIFORNIA

LIGO
CALIFORNIA INSTITUTE OF TECHNOLOGY
MASSACHUSETTS INSTITUTE OF TECHNOLOGY

LASER INTERFEROMETER
GRAVITATIONAL-WAVE OBSERVATORY
SITE NO. 2 - LIVINGSTON, LOUISIANA

TITLE: ELECTRICAL CORNER STATION OSB OFFICE AREA FIRE DET & COMM PLAN

SCALE	CONTRACT NUMBER	PROJECT NUMBER
NONE	PP150969	8094

SHEET NUMBER: LA-E-110
REVISIONS: 1

LIGOLAF3.BDR