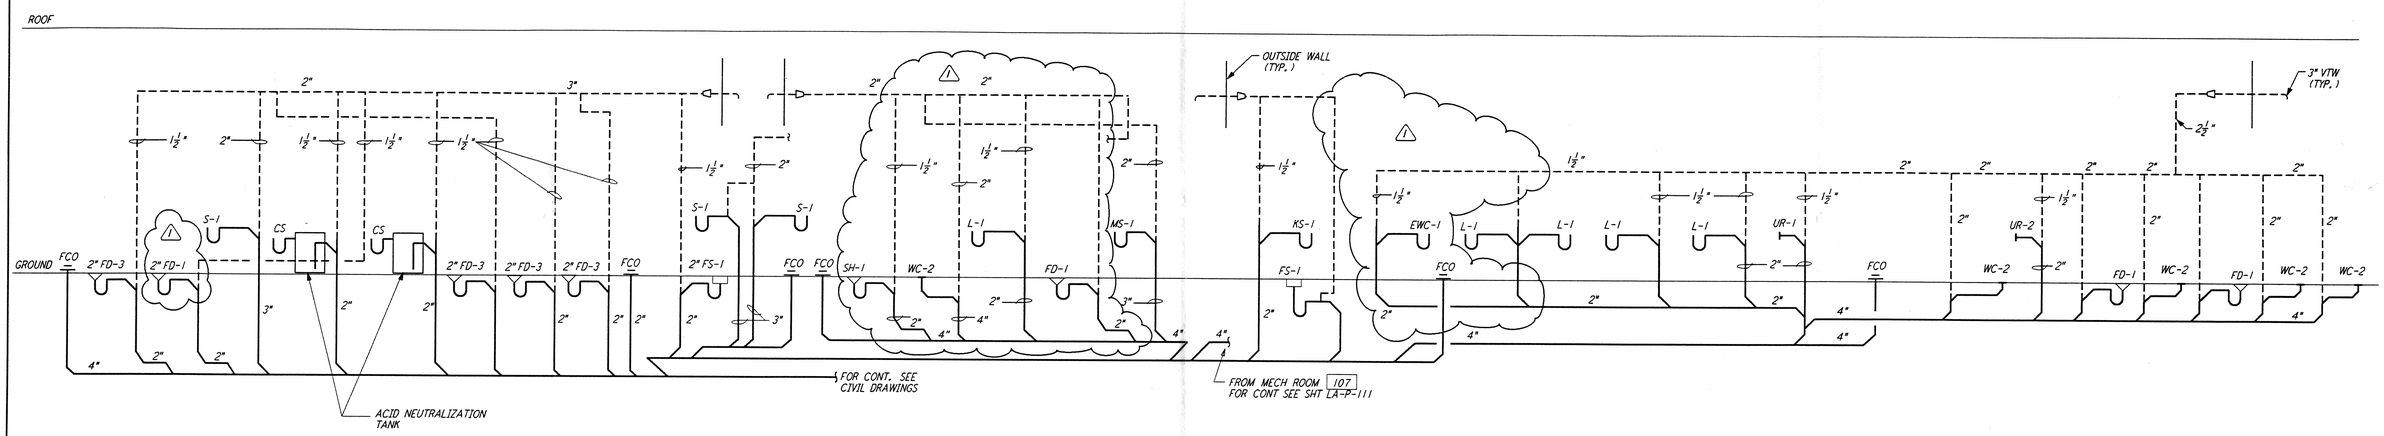

WASTE AND VENT RISER DIAGRAM

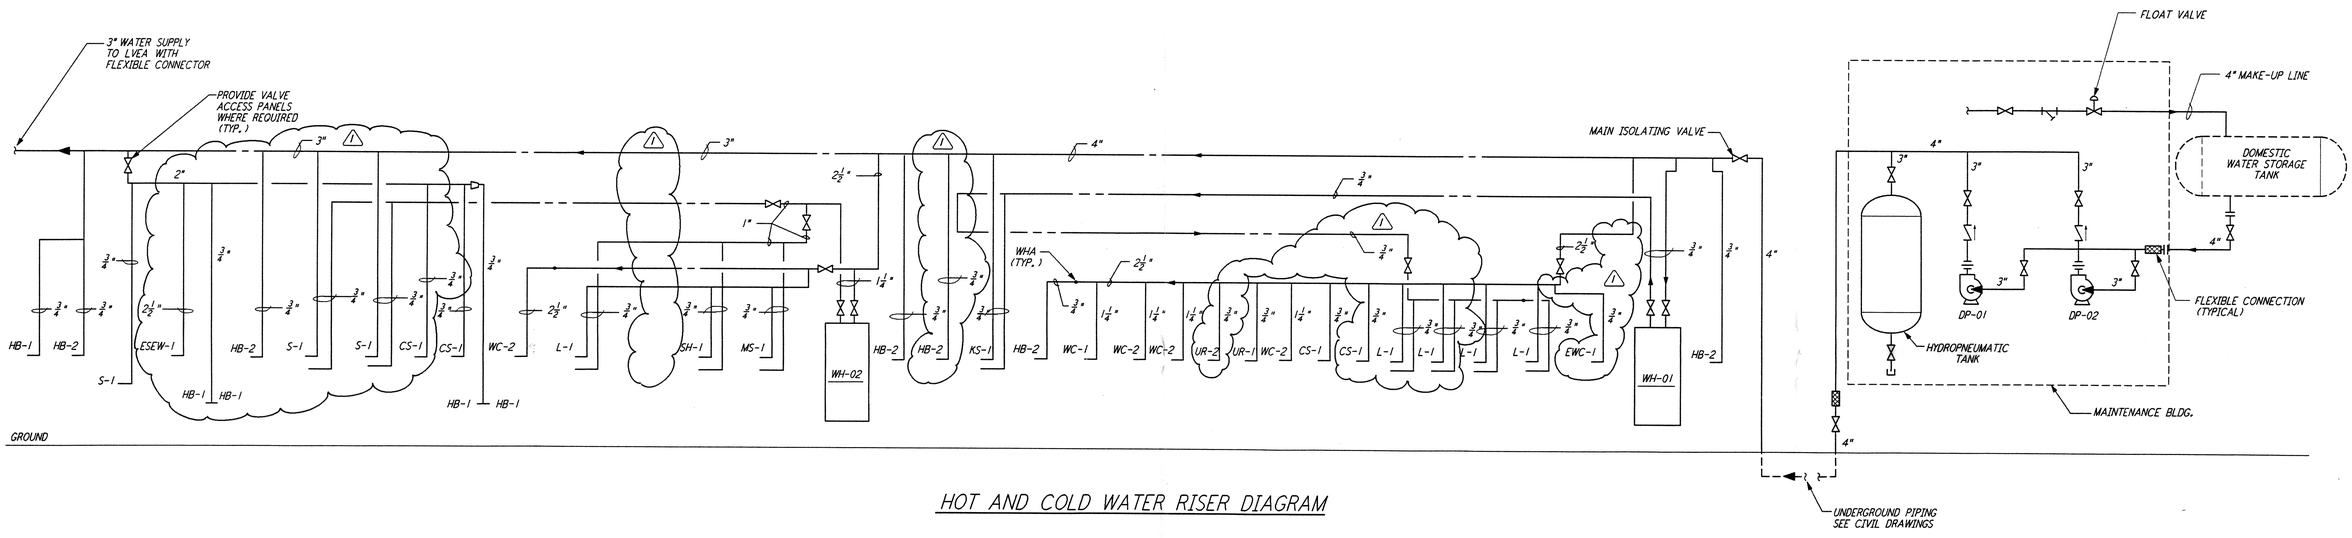

HOT AND COLD WATER RISER DIAGRAM

LIGO-D961051-01-O

REFERENCES	
DRAWING NO.	DESCRIPTION

REVISIONS						
NO.	DATE	BY	CHKD	ENGR	PROJ	DESCRIPTION
1	3-20-97	WNK	AA	AA	TDM	REVISED PLUMBING RISER DIAGRAMS

ISSUED FOR CONSTRUCTION		
DRAWN	DG	11-15-96
CHECKED	ME	10-25-96
ENGINEER	AA	10-25-96
PROJ	TDM	11-15-96

STATE OF LOUISIANA — MARK A. ELKAN — REG. No. 26842 — REGISTERED PROFESSIONAL ENGINEER — 3/20/97 — PROFESSIONAL ENGINEERING — EXP. 9/30/98

PARSONS
100 WEST WALNUT STREET
PASADENA, CALIFORNIA

LIGO
CALIFORNIA INSTITUTE OF TECHNOLOGY
MASSACHUSETTS INSTITUTE OF TECHNOLOGY

LASER INTERFEROMETER GRAVITATIONAL-WAVE OBSERVATORY
SITE NO. 2 - LIVINGSTON, LOUISIANA

TITLE	SCALE	CONTRACT NUMBER	PROJECT NUMBER
PLUMBING CORNER STATION RISER DIAGRAM	NONE	PP150969	8094
	SHEET NUMBER: LA-P-131		REVISIONS: 1

This document and the design it covers are the property of PARSONS. They are loaned only with the borrower's expressed written agreement that they will not be reproduced, copied, loaned, exhibited, or used in any other way, except by written consent from PARSONS to the borrower.