
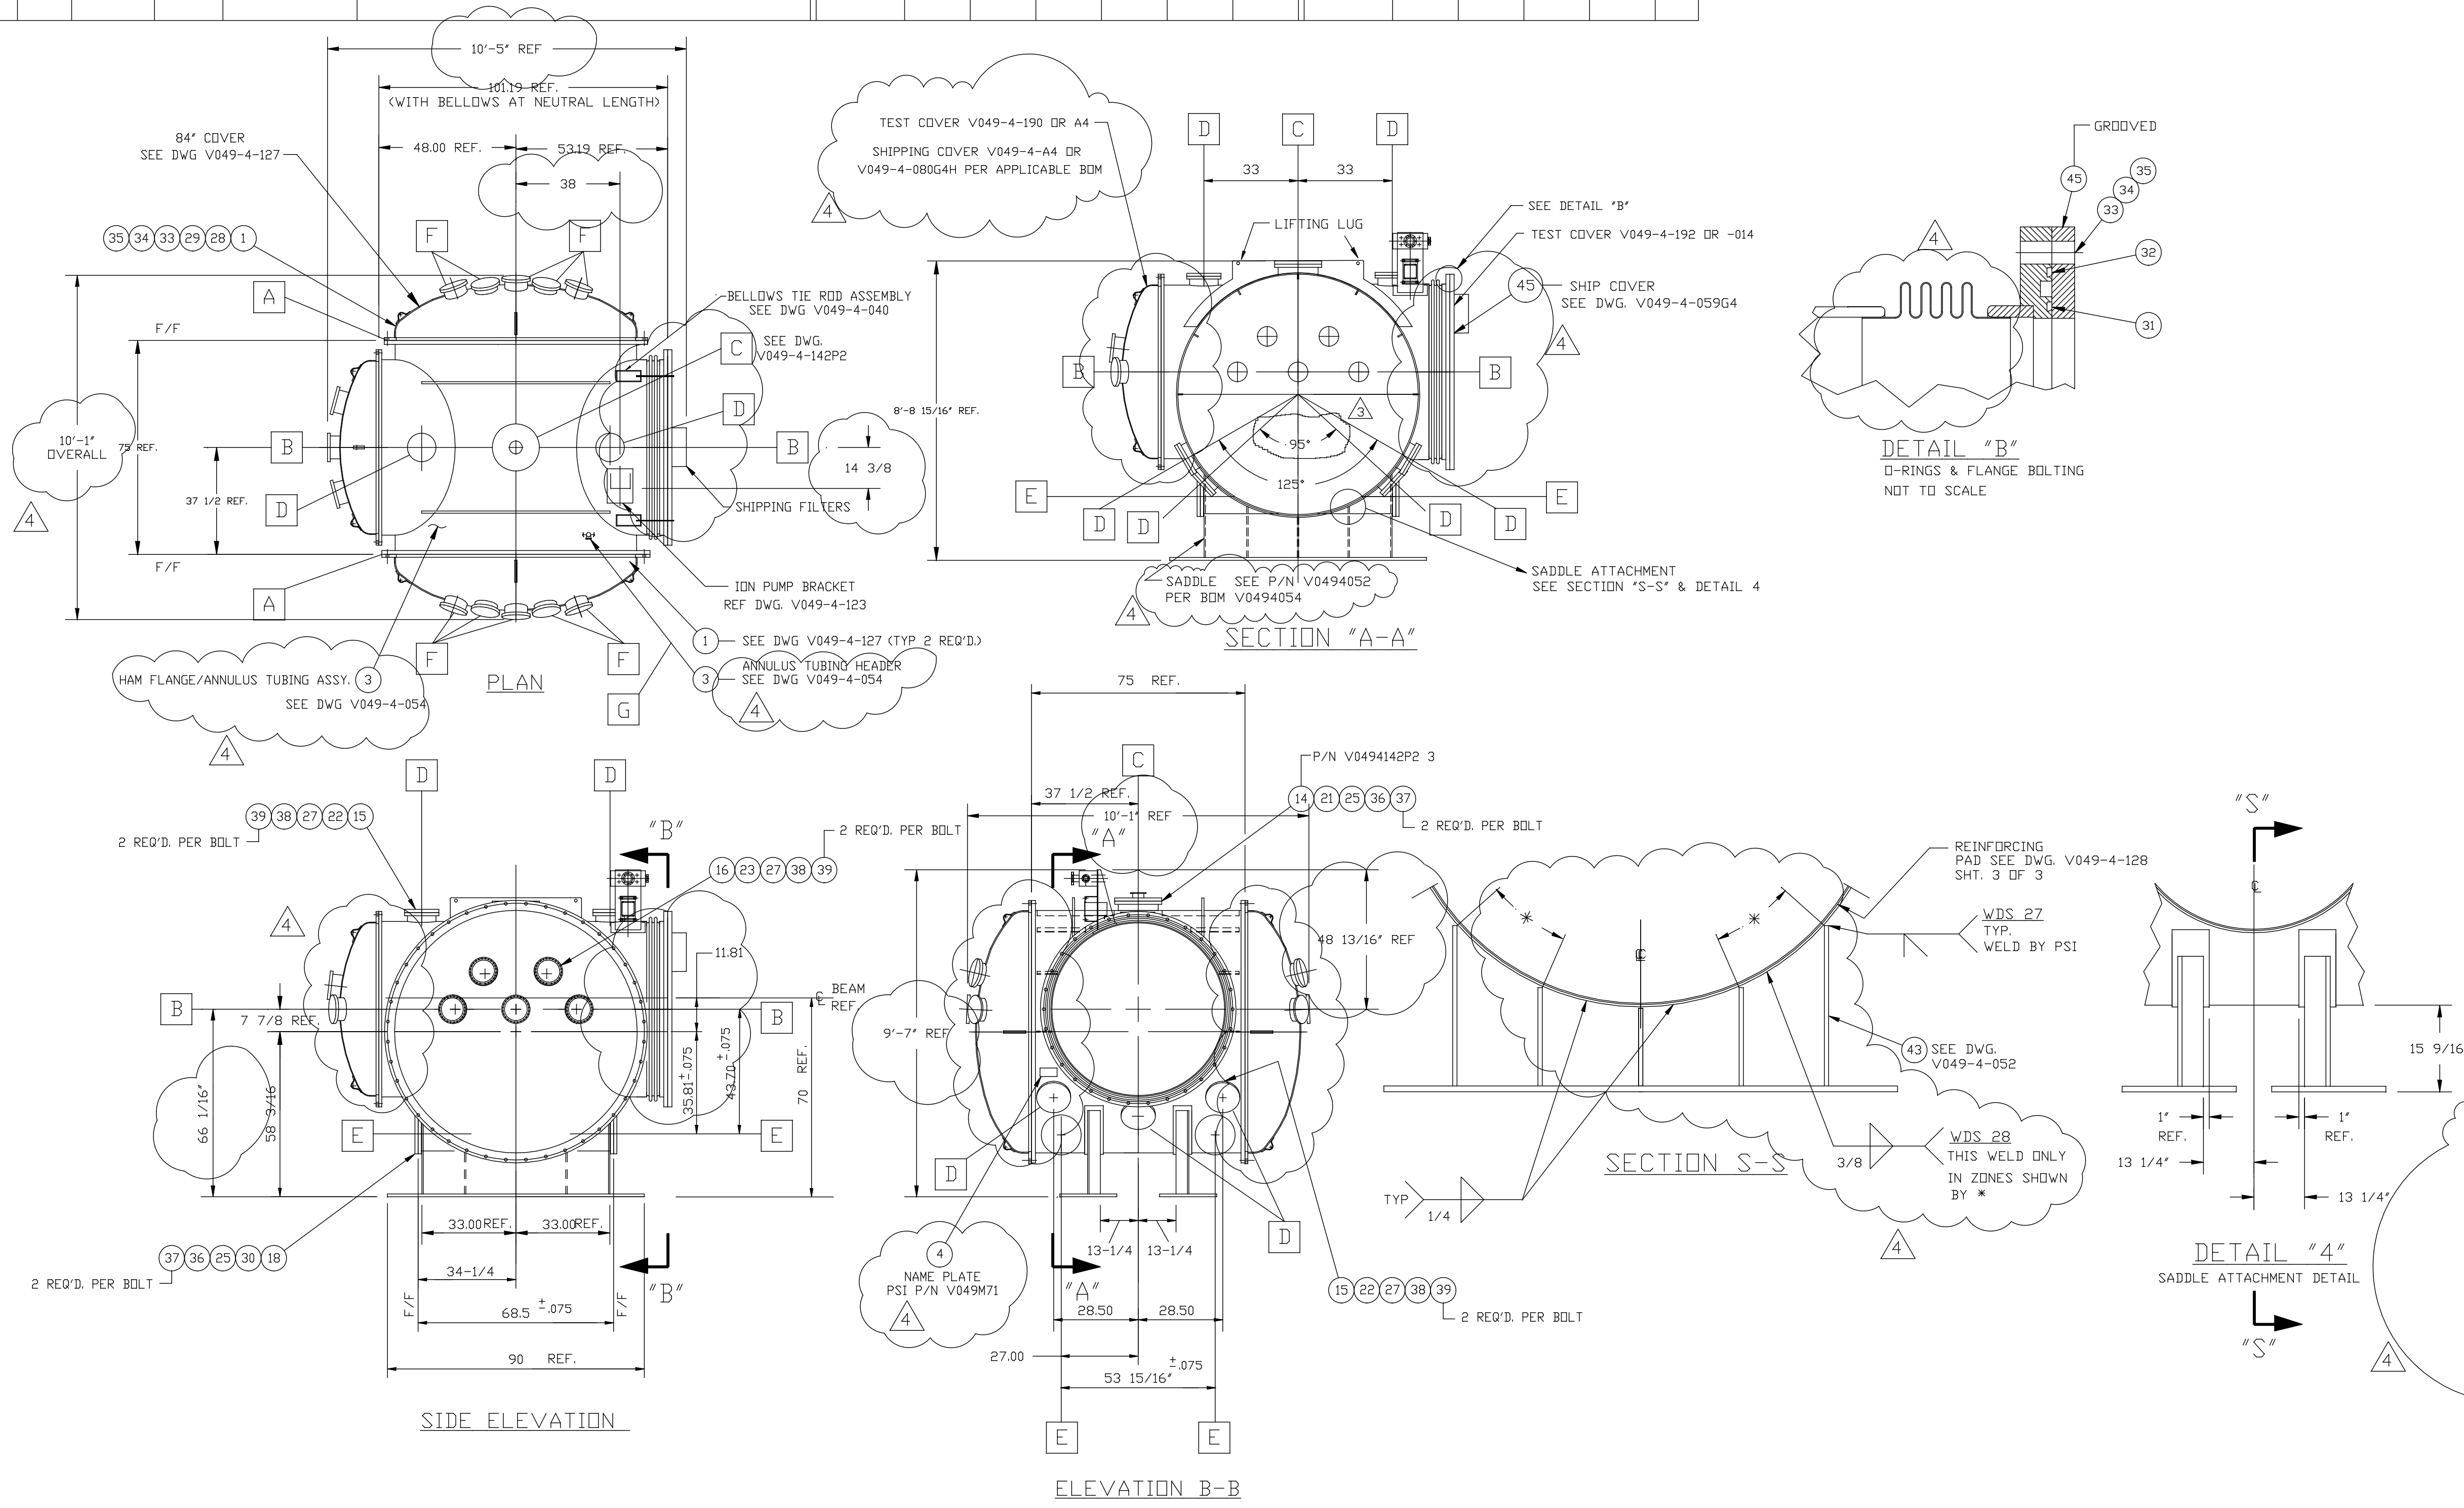


NOZZLE SCHEDULE					NOZZLE TYPE						WELD TYPE							
MARK	QTY	SIZE	RATING	TYPE	DESCRIPTION	TYPE	A	B	C	D	E	F	TYPE	A	B	C	D	E
A	2	84 1/4" I.D.		SEE NOTE 2,3	MAJOR ACCESS (SEE DWG. V049-4-127)	NA	NA	NA	NA	NA	NA	NA	NA	NA	NA	NA	NA	NA
B	2	60 1/2" I.D.		SEE NOTE 2,3	LASER BEAM													
C	1	14" O.D. TUBE ***		16 1/2" O.D. CONFLAT W/ BLIND FLANGE	AIR SHOWERS (SEE DWG. V049-4-142)	I	14.0	.120	1/4				1	1/8"	SEE V049-4-128 SEE DETAIL #9 SHEET #1			
D	8	10" O.D. TUBE ***		12" O.D. CONFLAT W/ BLIND FLANGE	ELEC./INSTR. FEEDTHROUGHS, UTILITY	I	10.0	.120	1/4				1	1/8"	SEE V049-4-128 SEE DETAIL #9 SHEET #1			
E	4	12" O.D. TUBE		14" O.D. CONFLAT W/ BLIND FLANGE	SUPPORT BEAM	I	12.0	.120	1/4				1	1/8"	SEE V049-4-128 SEE DETAIL #9 SHEET #1			
F	10	8" O.D. TUBE ***		10" O.D. CONFLAT W/ BLIND FLANGE	OBSERVATION PICKOFFS (DWG. V049-4-127)	I	8.0	.250	3/16				1	3/16	SEE V049-4-127 SEE DETAIL #26 SHEET #1			
G	1	2 1/2" O.D. TUBE		4 1/2" O.D. CONFLAT W/ BLIND FLANGE	ANNULUS AUX. TURBO PUMPOUT PORT (SEE DWG. V049-4-054)													

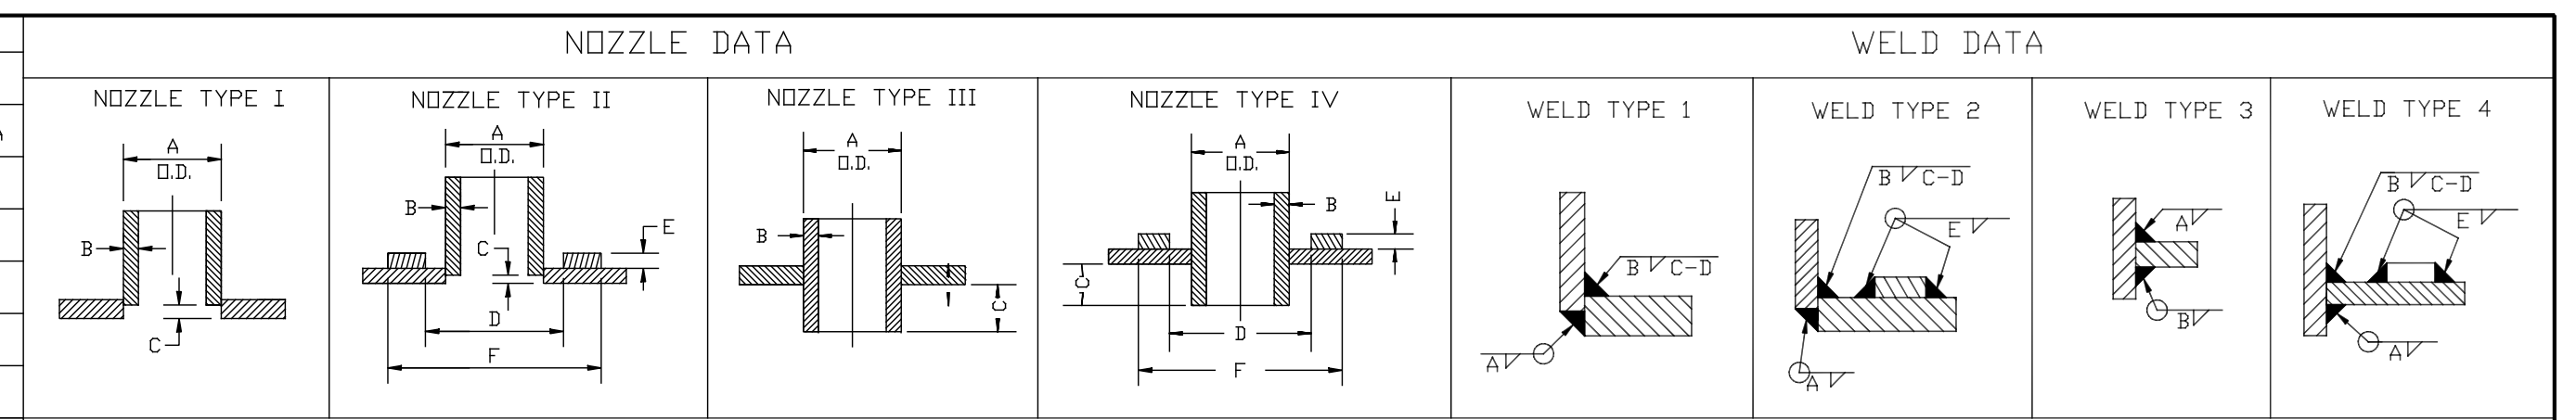

DESIGN DATA	
2 PSIG AT 120°/UHV AT 400° F	
CORROSION ALLOWANCE: 0	
POSTWELD HEAT TREATMENT: YES-SEE NOTE 15.	
FIREPROOFING: N.A.	
RADIOGRAPHING: NONE	
MATERIALS	
HEADS:	SA 240-304L
SHELL:	SA 240-304, 304L
FLANGES:	SA 182 GRADE F, 304L
PIPE NECKS:	304L
REINFORCING: EXTERNAL	SA 240-304
BOLTS & NUTS:	SA 193-B7
WEIGHTS	
EMPTY:	5,000 LBS
SHIPPING:	

- NOTES
- STRESS RELIEVE PER SPEC. V049-2-046.
  - WDS NO'S. REFER TO WELD DATA-SPEC V049-2-084
  - THESE FLANGE SURFACES ARE TO BE TANGENT TO THE SHELL O.D.
  - LEAK TEST & METHOD PER PSI SPEC: V049-2-014, BY PSI.
  - CERTIFIED MANUFACTURER'S MATERIAL TEST REPORTS REQUIRED, EXCEPT AS NOTED ON B.O.M.
  - FLANGE BOLT HOLES TO STRADDLE NATURAL CENTERLINES OF VESSEL UNLESS NOTED.
  - CLEAN PER SPEC: V049-2-015
  - ALL CONFLAT NOZZLES TO BE CONTOURED TO MEDIAN SHELL DIA, UNLESS OTHERWISE NOTED.
  - DO NOT USE CARBON STEEL BRUSHES OR BRUSHES CONTAMINATED WITH CARBON STEEL ON STAINLESS OR ALUMINUM MATERIAL. GRINDING TO INTERNAL VACUUM BOUNDARY SURFACES IS NOT ALLOWED.
  - MACHINING & ROLLING TO BE IN ACCORDANCE WITH SPEC. V049-2-136.
  - HEADS ARE ASME F&D.
  - CHAMBER FABRICATION TO BE IN ACCORDANCE WITH SPEC. V049-2-078. CHAMBER FABRICATION PLAN TO BE IN ACCORDANCE WITH SPEC. V049-2-081. CHAMBER QUALITY PLAN TO BE IN ACCORDANCE WITH SPEC. V049-2-087.
  - FOR FLANGE DETAILS SEE DWG. V049-4-021, V049-4-027 & V049-4-031.
  - THESE FLANGES EACH INCLUDE AN ANNULAR CHANNEL BETWEEN O-RINGS, MANIFOLD TO A SINGLE PUMPOUT PORT ON EACH CHAMBER, SEE DWG. V049-4-054
  - USE THIS DWG WITH THE FOLLOWING BOM'S:
    - V0494009 HAM TEST/BAKE ASSY, (WITH A4 COVER)
    - V0494309 HAM SHIPPING ASSY, (WITH A4 COVER)
    - V0494013 HAM TEST/BAKE ASSY, (WITHOUT A4 COVER)
    - V0494313 HAM SHIPPING ASSY, (WITHOUT A4 COVER)
    - V0494054 HAM FLANGE/ANNULUS TUBING ASSY.

NOTE: THIS DRAWING IS USED WITH MULTIPLE BOM'S, SEE NOTE 1. ABOVE

PROPRIETARY AND CONFIDENTIAL	DESCRIPTION	QTY	SYMBOL	CHARACTERISTIC	UNLESS OTHERWISE SPECIFIED	ISSUE DESCRIPTION	DATE	BY	CHKD	DRWN	DATE	DECD
V049-4-A4	60" ACCESS PORT COVER-END UNITS	2		FLATNESS	DIMENSIONS ARE IN INCHES	4	6/6/97	0470				
V049-4-054	HAM FLANGE/ANNULUS TUBING ASSEMBLY	1		CYLINDRICITY	TOLERANCES:	3	9/27/96	0278				
V049-0-100	DRAWING TREE / BOM STRUCTURE	1		PARALLELISM	FRACTIONAL ± .1	2	7/11/96	0200				
V049-4-128	HAM WELDMENT	1		ANGULARITY	ANGULAR ± 0°-30' BEND ± 2°	1	6/21/96	0208				
V049-4-127	84 1/4 ID ACCESS COVER	1		TRUE POSITION	TWO PLACE DECIMAL ± .03	0	5/1/96	0118				
V049-4-123	HAM-75 ION PUMP SUPPORT	1		CONCENTRICITY	THREE PLACE DECIMAL ± .015	P3	04-05-96	0112				
V049-4-040	HAM BELLOWS TIE ROD ASSEMBLY	1			FINISHED SURFACE RMS 6.3	REV						
1101010	LIGO HORIZONTAL ACCESS MODULE (HAM)	1			BREAK CORNERS IN							
					REMOVE ALL BURRS							
					DD NOT SCALE THIS DRAWING							
					USED ON:							
					NEXT ASSY: V049-4-009/013							

**PROCESS SYSTEMS INTERNATIONAL INC.**  
 20 WALKUP DR. WESTBOROUGH, MASSACHUSETTS 01581 USA

HAM ASSEMBLY  
 LIGO VACUUM EQUIPMENT

CAD FILE: V0494002/400251  
 SHEET: 1 OF 1

SCALE: 3/8"=1'-0"