
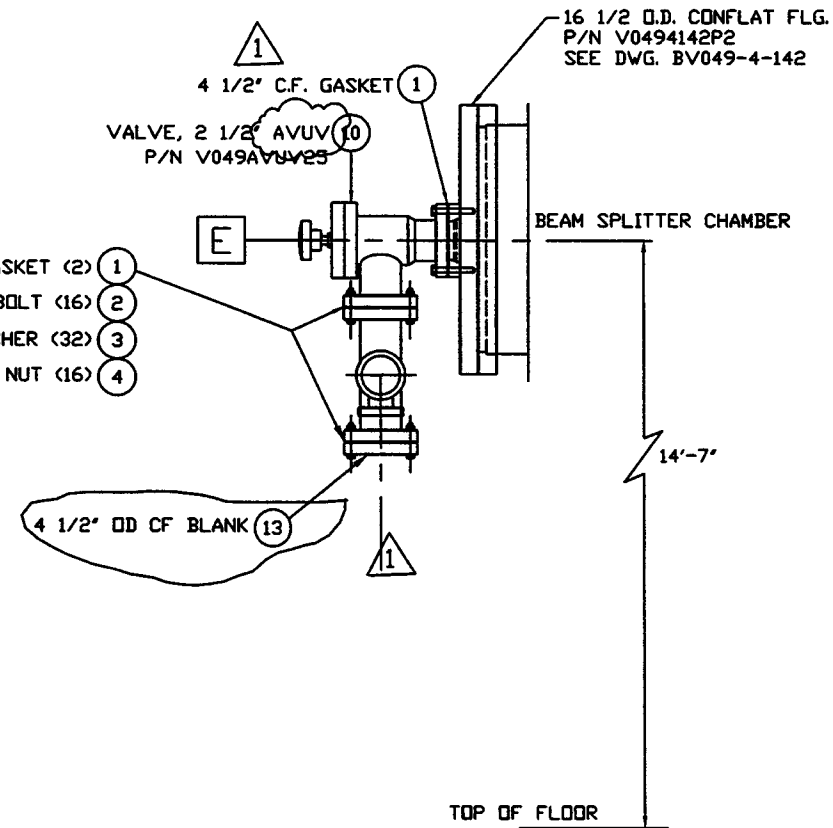


PLAN - BSC GAS ANALYZER

SCALE: 1 1/2" = 1'-0"

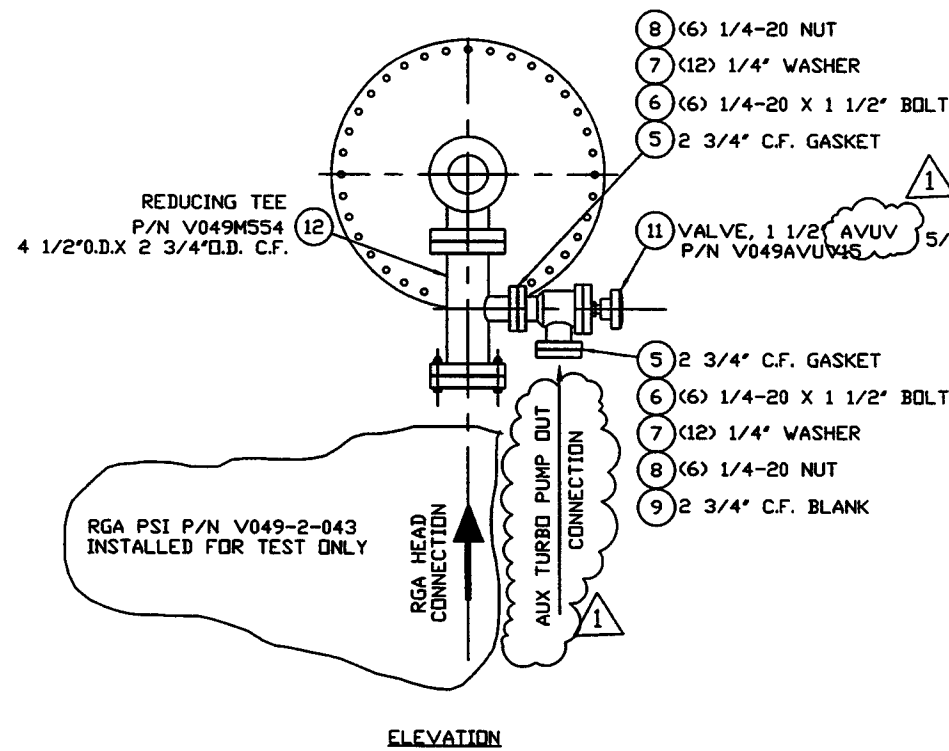

WASHINGTON SITE: WBSC1
WBSC3
LOUISIANA SITE: LBSC1
LBSC3

PROPRIETARY AND CONFIDENTIAL

THIS DOCUMENT CONTAINS PROPRIETARY INFORMATION BELONGING TO PROCESS SYSTEMS INTERNATIONAL, INC. OR ITS AFFILIATED COMPANIES AND SHALL BE USED ONLY FOR THE PURPOSE FOR WHICH IT WAS SUPPLIED. IT SHALL NOT BE COPIED, REPRODUCED OR OTHERWISE USED, NOR SHALL SUCH INFORMATION BE FURNISHED IN WHOLE OR IN PART TO OTHERS EXCEPT IN ACCORDANCE WITH THE TERMS OF ANY AGREEMENT UNDER WHICH IT WAS SUPPLIED OR WITH THE PRIOR WRITTEN CONSENT OF PROCESS SYSTEMS INTERNATIONAL, INC. AND SHALL BE RETURNED UPON REQUEST.

DWG. NO.	DESCRIPTION	USED ON:	REV.	DESCRIPTION
	REFERENCE DRAWINGS			
		NEXT ASS'Y:		ISSUE DESCRIPTION

UNLESS OTHERWISE SPECIFIED		DIMENSIONS ARE IN INCHES		TOLERANCES		ANGULARS		SURFACE FINISH	
1	REISSUED FOR FABRICATION/INSTALLATION AS NOTED								
0	ISSUED FOR FDR								

PROCESS SYSTEMS INTERNATIONAL, INC. 20 WALKUP DR. WESTBOROUGH, MASSACHUSETTS 01581 USA	
RGA/AUX. TURBO CONN. ASSY.	
LIGO VACUUM EQUIPMENT	
CAD FILE: V0494045	SIZE: C
DWG. NO.: V049-4-045	REV.: 1
SCALE: 1 1/2" = 1'-0"	SHEET: 1 OF 1

Jun 10, 1997 - 16:56:05