

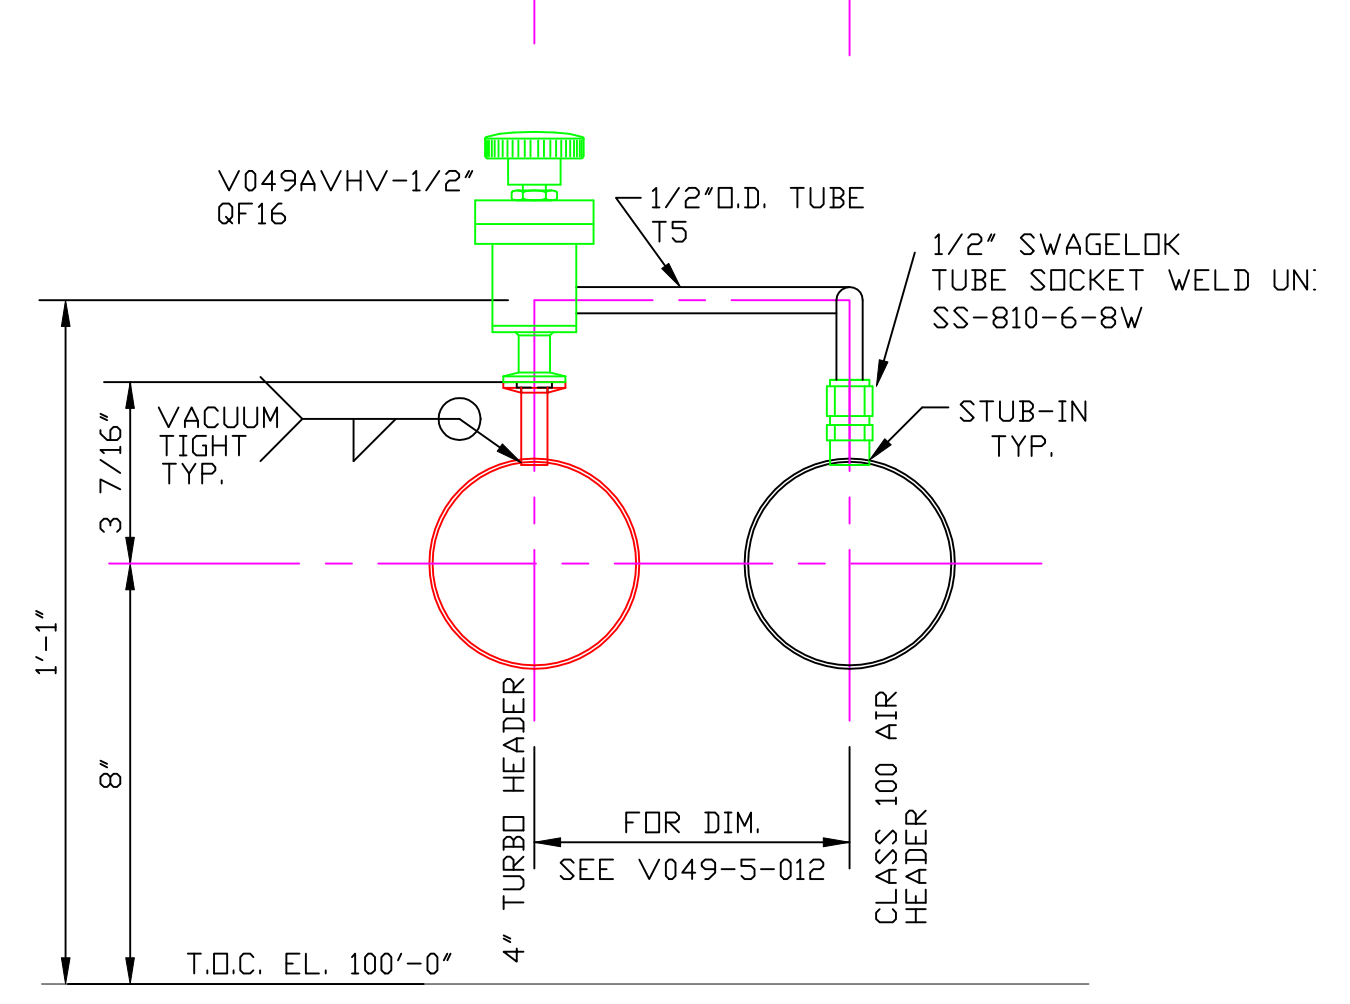




DETAIL 2
SCALE: 3"=1'-0" V049-5-012, SHT.1 & 2

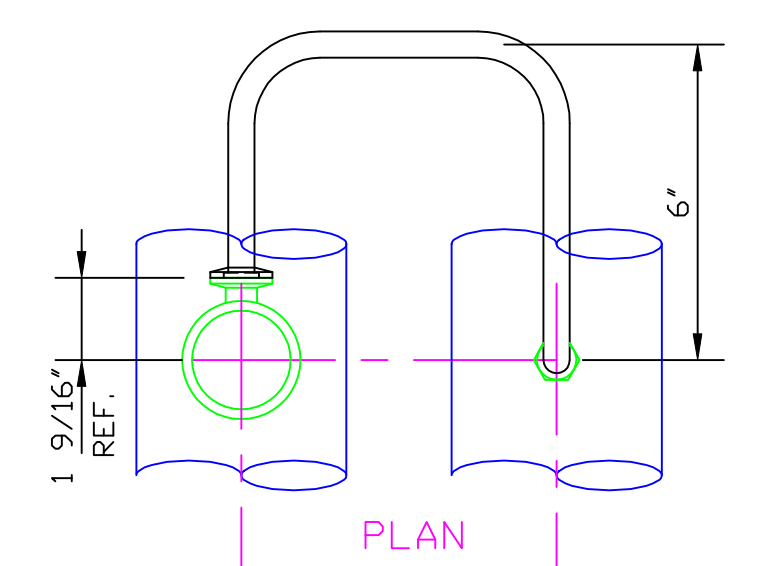

DETAIL 3
SCALE: 3"=1'-0" V049-5-012, SHT.1, 3 & 4

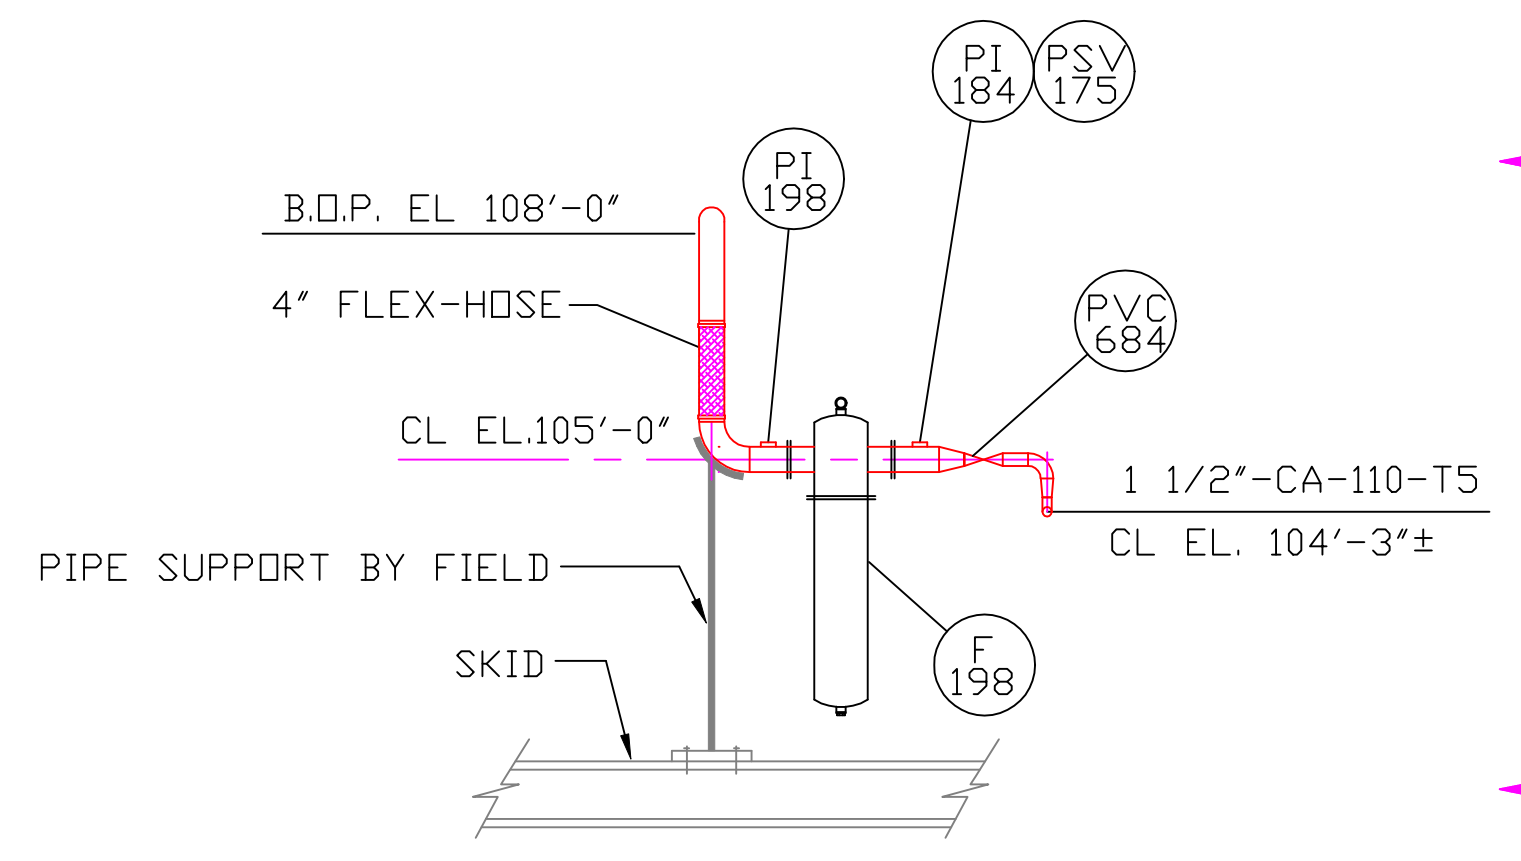


SECTION Y
SCALE: 3/8"=1'-0" V049-5-012, SHT.1

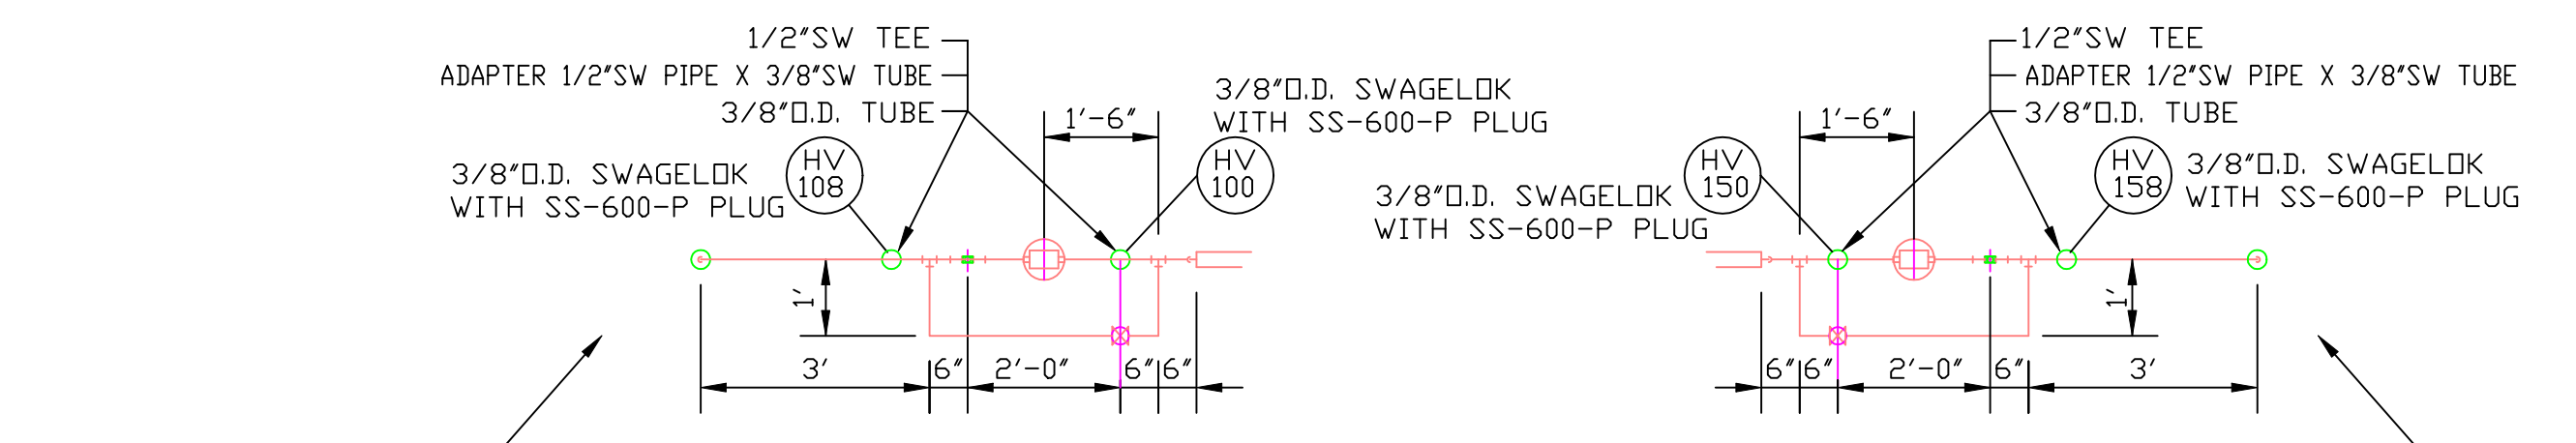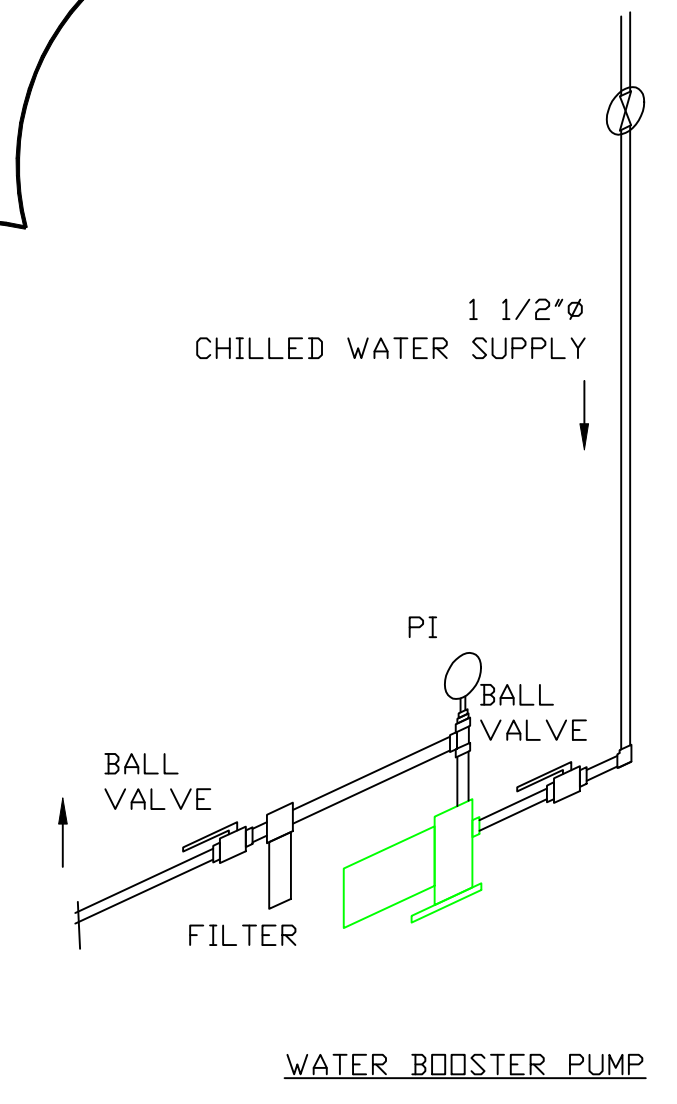

SECTION Q
SCALE: 3/8"=1'-0" V049-5-012, SHT.4

SECTION R
SCALE: 3/8"=1'-0" V049-5-012, SHT.3

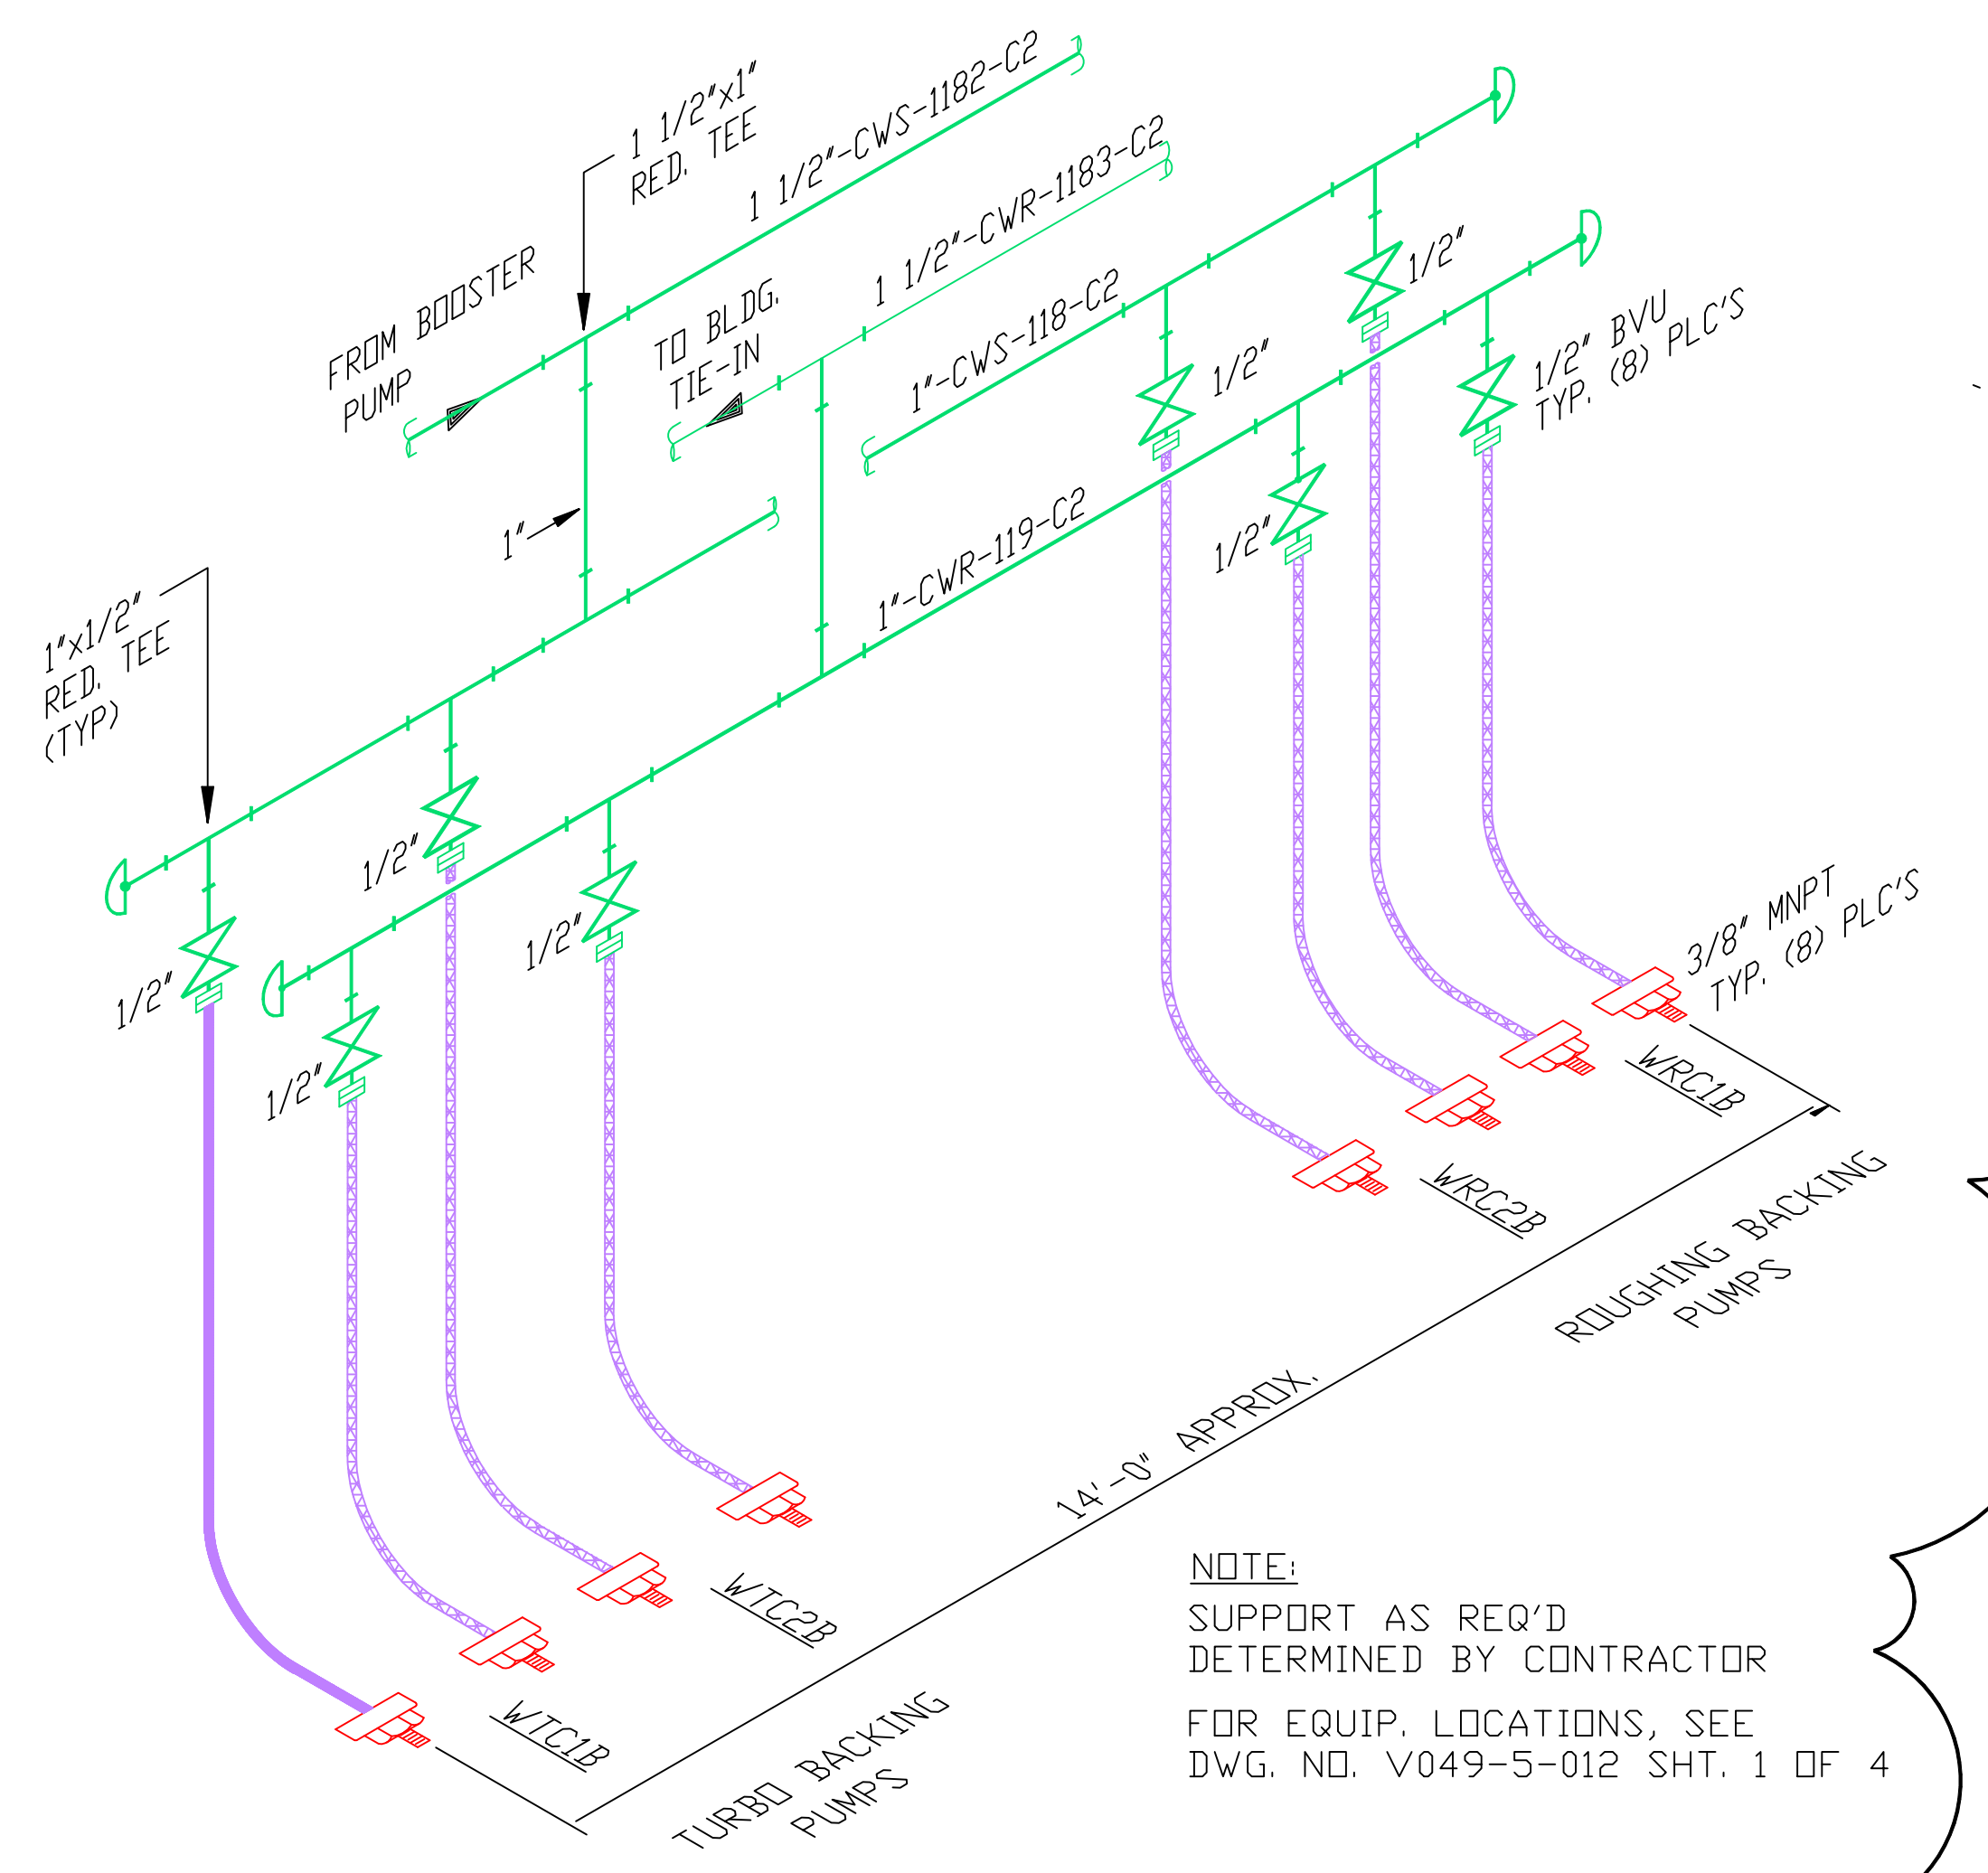

PROCESS SYSTEMS INTERNATIONAL INC.
20 WALKUP DR. WESTBOROUGH, MASSACHUSETTS 01581 USA

PIPING ARRANGEMENT
SECTIONS
CORNER STATION WASHINGTON
LIGO VACUUM EQUIPMENT

CAD FILE V0495014/5014S3	SIZE D	DWG. NO. V049-5-014	REV. 5
SCALE AS NOTED	SHEET 3 OF 3		

Jun 18, 1998 - 16:44:17

EDUCATION VERSION...NOT FOR COMMERCIAL USE