




PLAN AT TYPICAL BAY
 1/8" = 1'-0" REF LA-S-502A LA-S-502

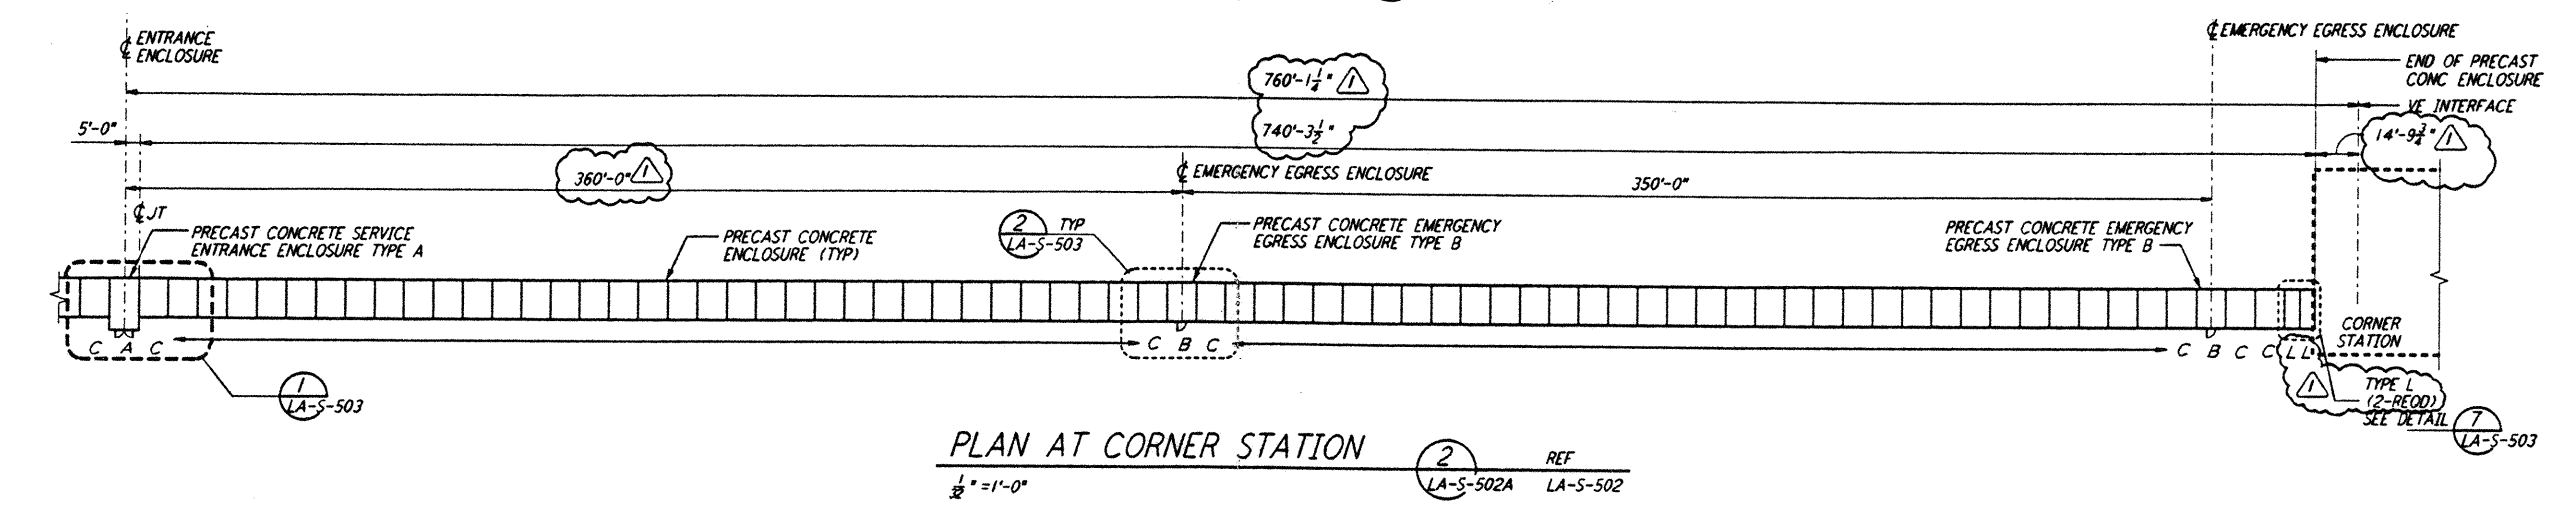


PLAN AT CORNER STATION

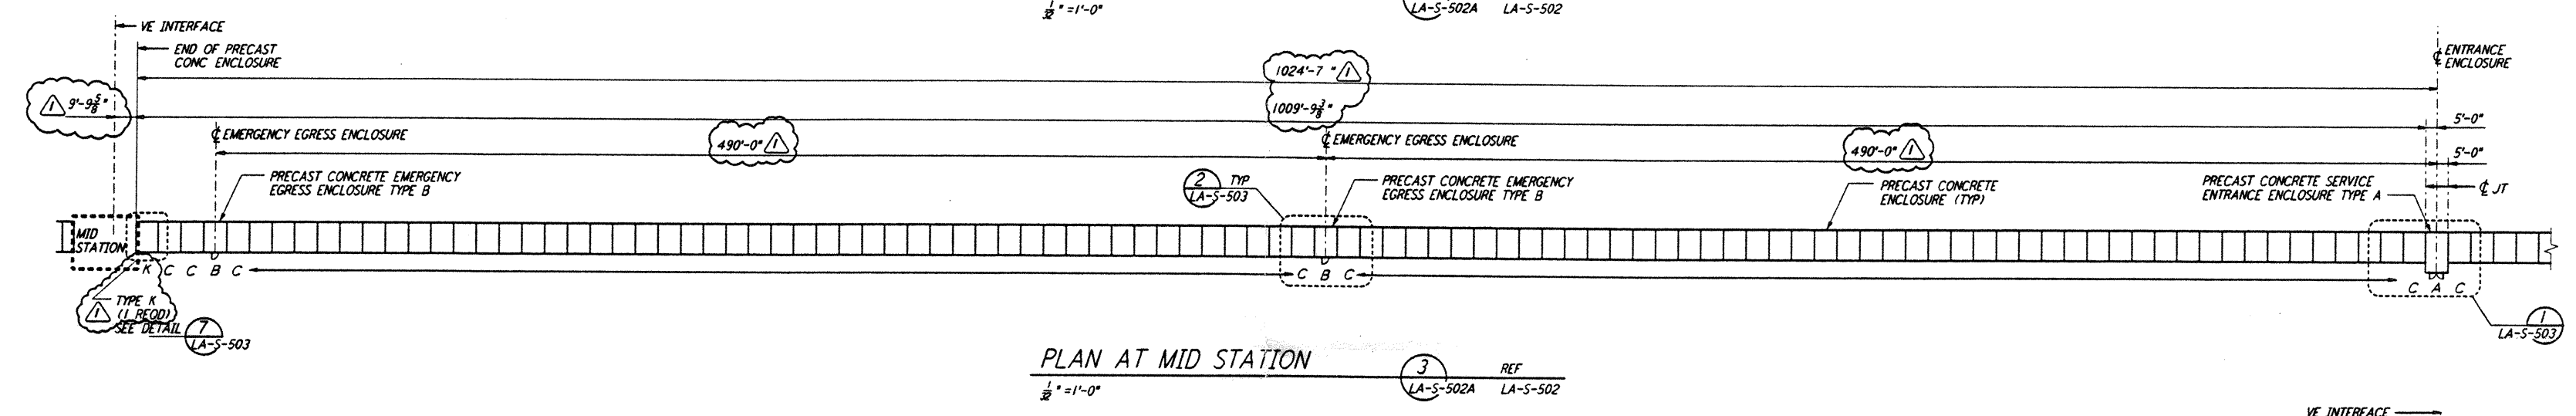

PLAN AT MID STATION

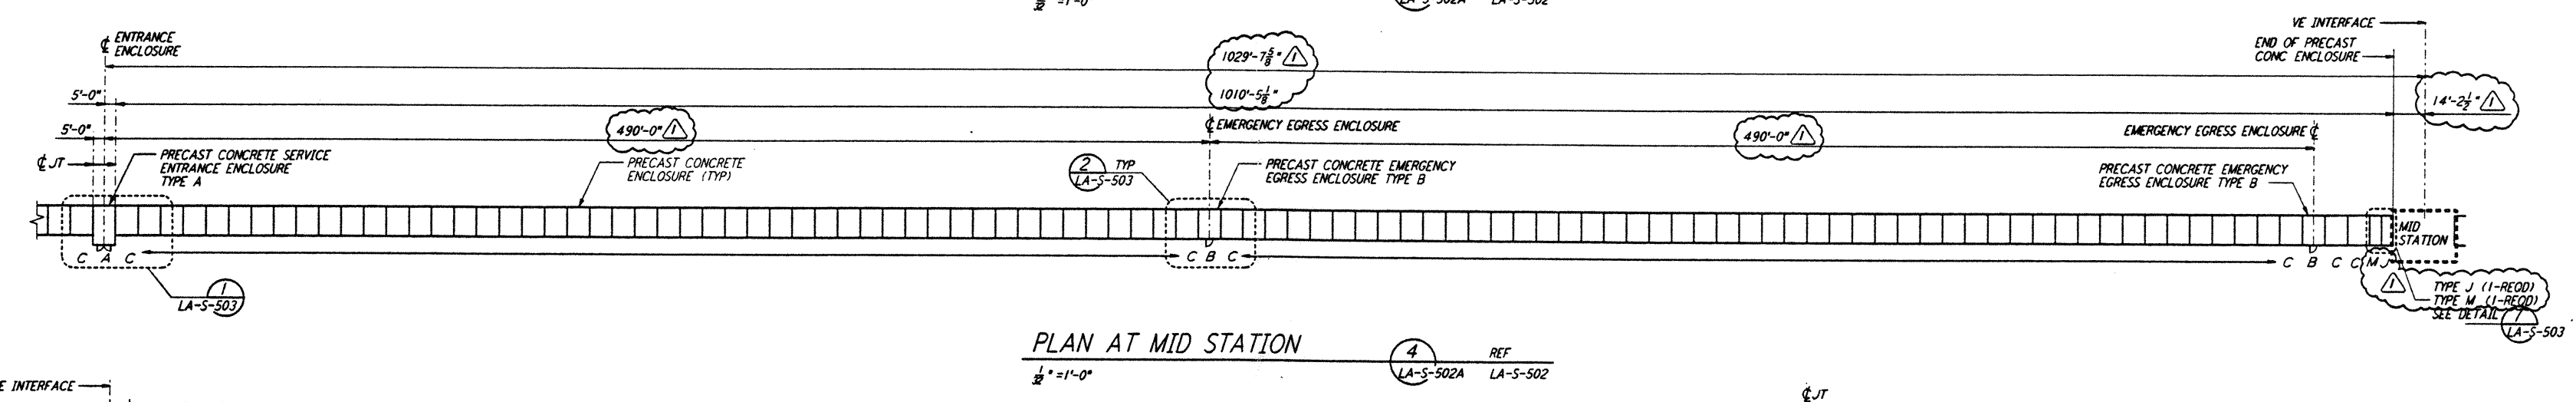


PLAN AT MID STATION

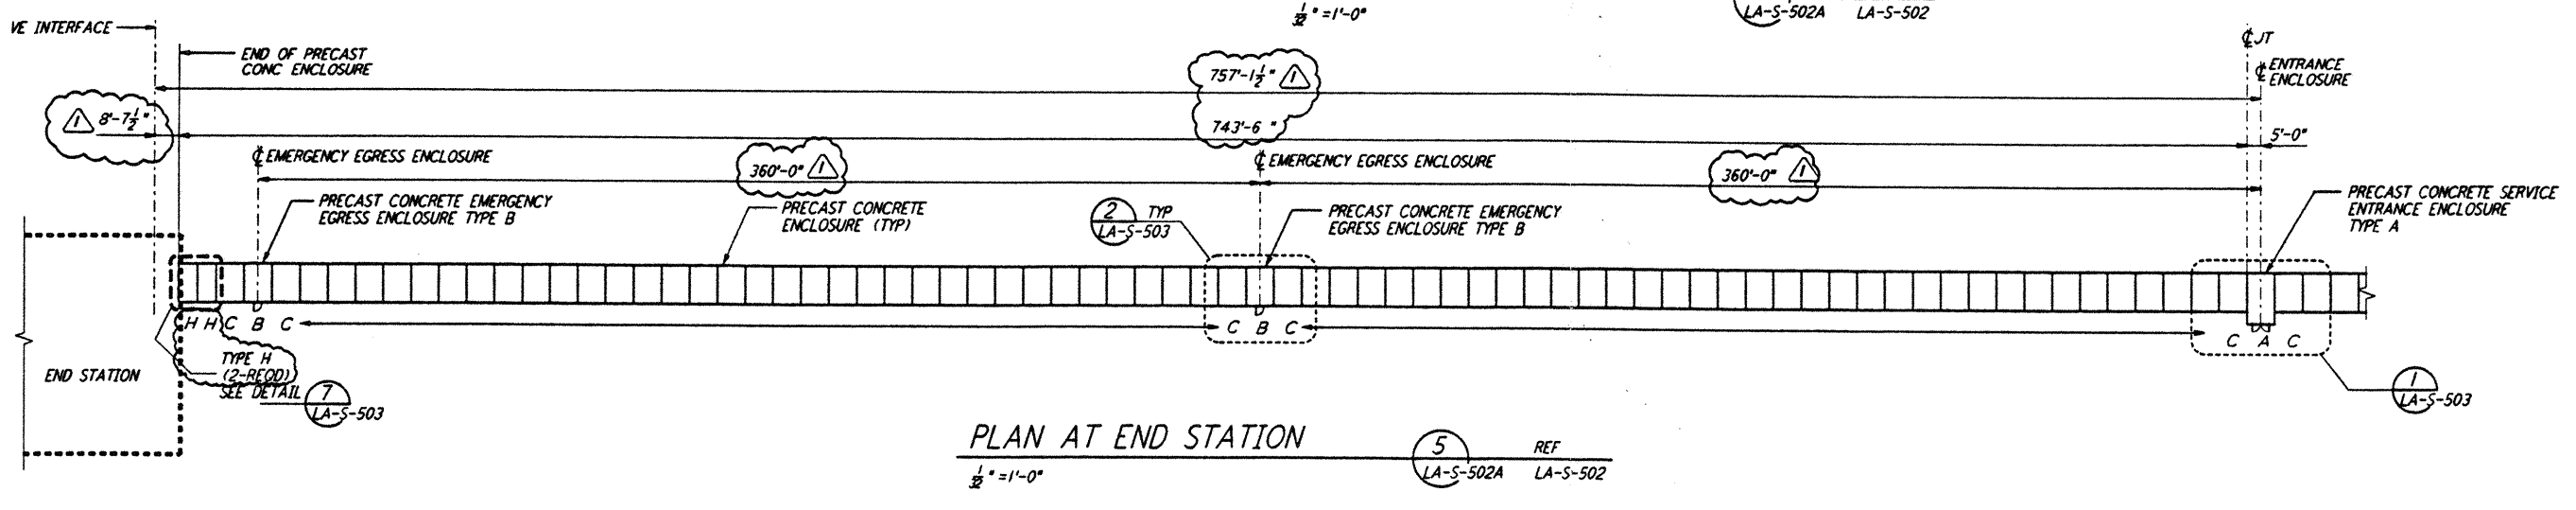

PLAN AT END STATION

NOTE:
 1. FOR GENERAL NOTES, ABBREVIATIONS AND LEGEND SEE DRAWING LA-S-501.

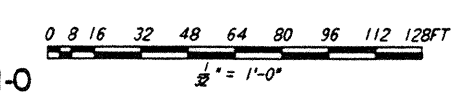

LIGO-D961237-01-0


This document and the design it covers are the property of PARSONS. They are loaned only with the borrower's expressed written agreement that they will not be reproduced, copied, loaned, exhibited, or used in any other way, except by written consent from PARSONS to the borrower.

FILE NO: 41 000000 1171 53-Y-0000 REV: 01/05/96 11:00:00 AM

FILE NO: 21 000000 1171 53-Y-0000 REV: 01/05/96 11:00:00 AM

NO.	DATE	BY	CHKD	ENGR	PROJ	REV	DESCRIPTION
1	2-28-97	GP	GP	GP	GP		REV DIMENSIONS & ENCLOSURE TYPES

ISSUED FOR CONSTRUCTION	
DRAWN	MCS 11-15-96
CHECKED	DDM 11-15-96
ENGINEER	BP 11-15-96
PROJ	TDM 11-15-96

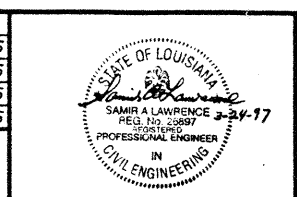

PARSONS
 100 WEST WALNUT STREET
 PASADENA, CALIFORNIA

LIGO
 CALIFORNIA INSTITUTE OF TECHNOLOGY
 MASSACHUSETTS INSTITUTE OF TECHNOLOGY

LASER INTERFEROMETER
 GRAVITATIONAL-WAVE OBSERVATORY
 BEAM TUBE ENCLOSURE - LIVINGSTON, LA

SCALE: AS NOTED CONTRACT NUMBER: PPI50969 PROJECT NUMBER: 8094

SHEET NUMBER: **LA-S-502A**