


not be reproduced, copied, loaned, exhibited, or used in any other way, except by written consent from PARSONS to the borrower.


This document and the design it covers are the property of PARSONS. They are loaned only with the borrower's expressed written agreement that they will

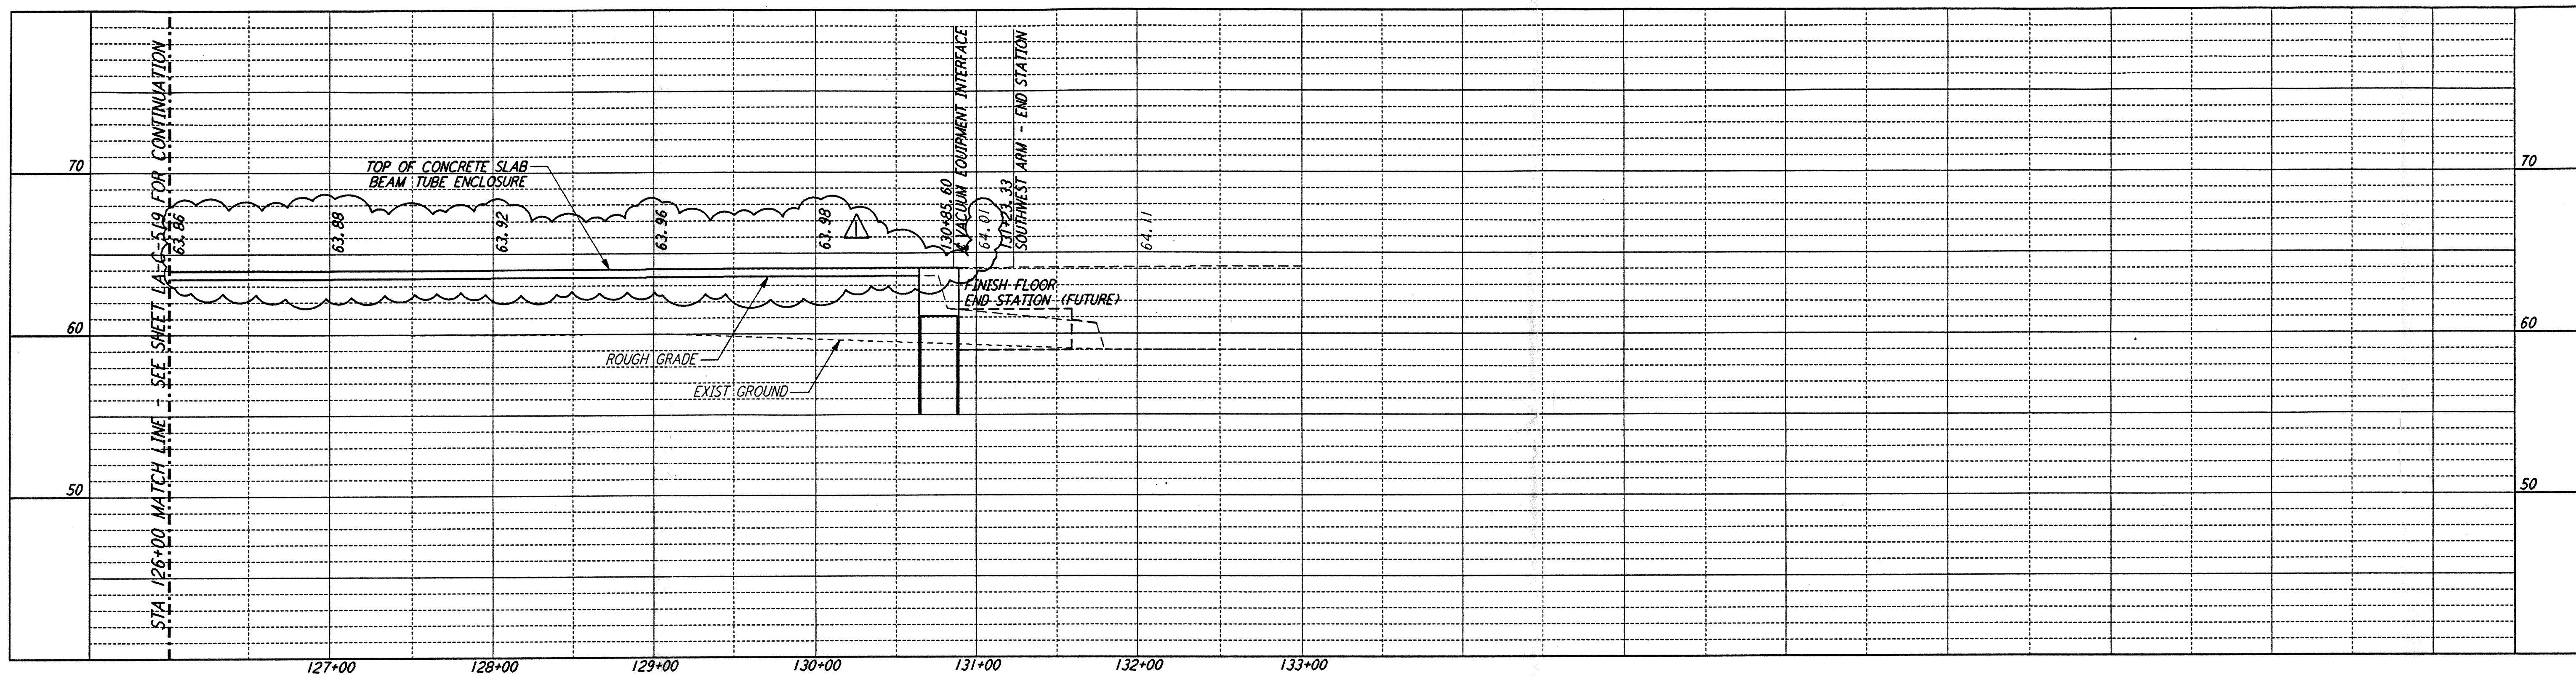


PROFILE
 SCALES: HORIZ: 1" = 50'
 VERT: 1" = 5'

CURVE DATA					
Δ	RADIUS	LENGTH	TANGENT	REMARK	
1 35°00'00"	110'	67.19'	34.68'	⊥ ROAD	
2 35°00'00"	100'	61.07'	31.53'	⊥ ROAD	



- NOTES:**
- SEE SHEET LA-C-502 FOR GENERAL NOTES, LEGEND AND ABBREVIATIONS.
 - SEE SHEET LA-C-504 FOR TYPICAL SECTIONS AND DETAILS.

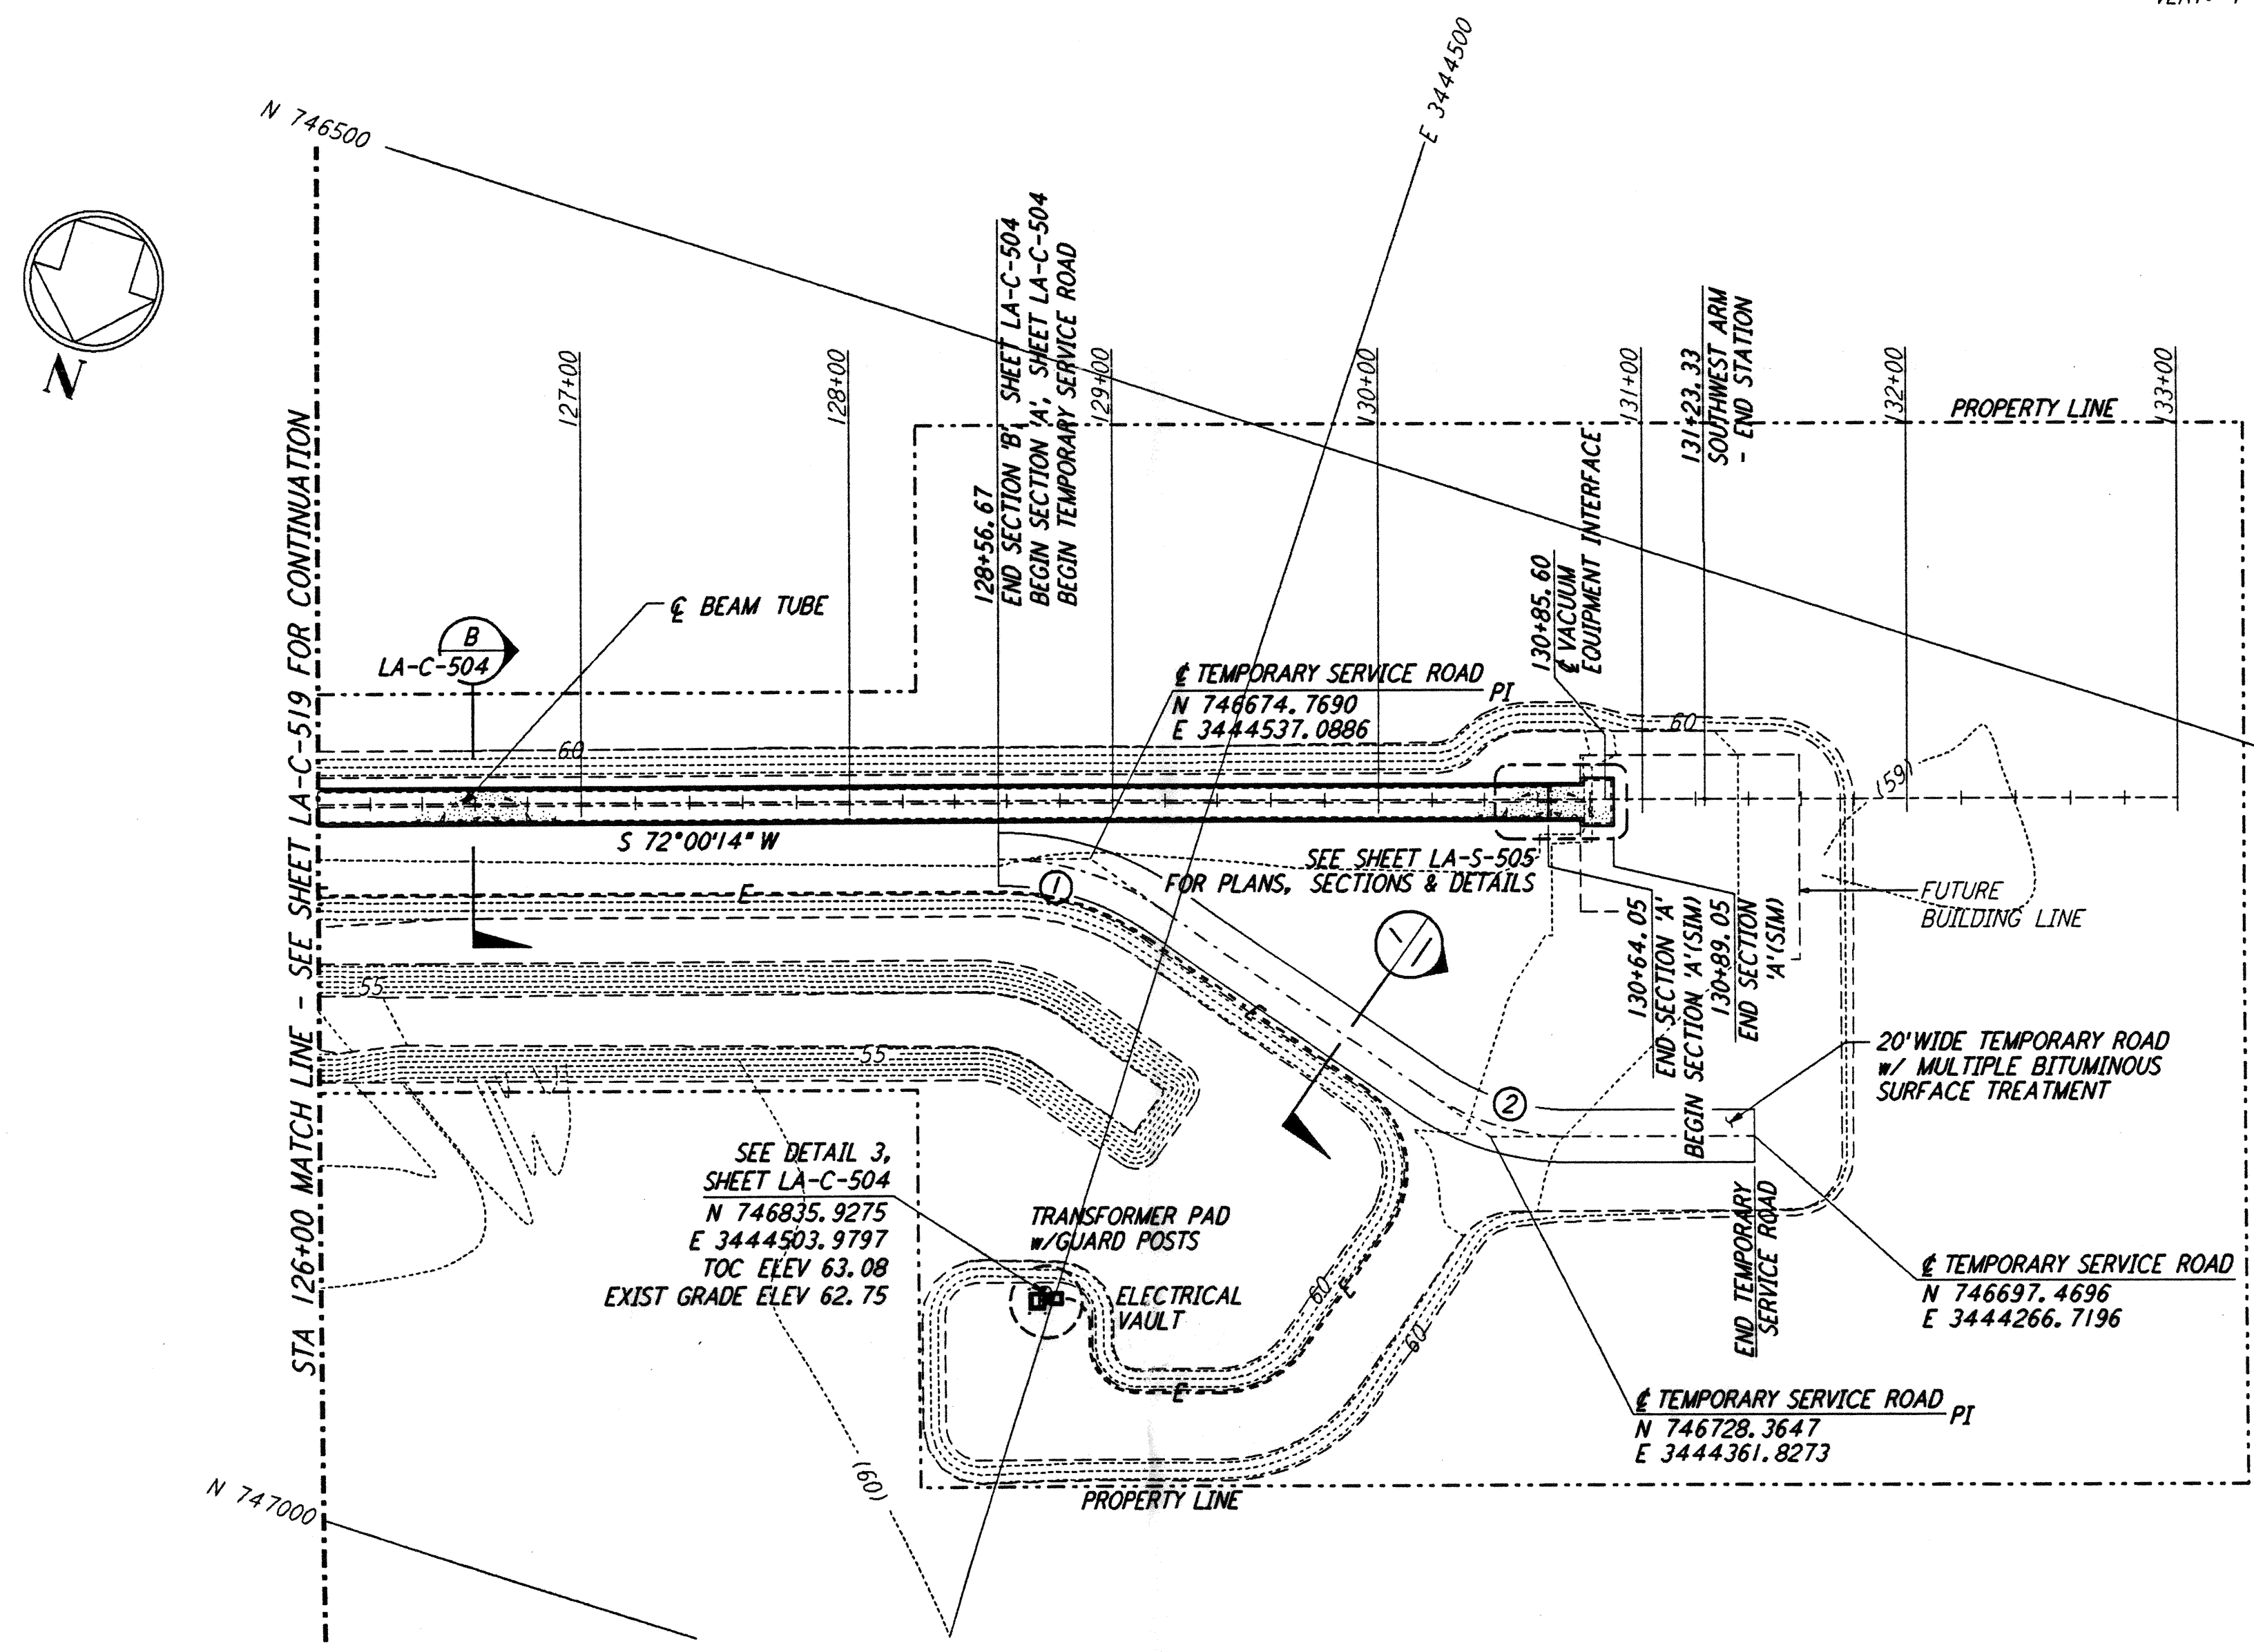

PLAN
 SCALE: 1" = 50'

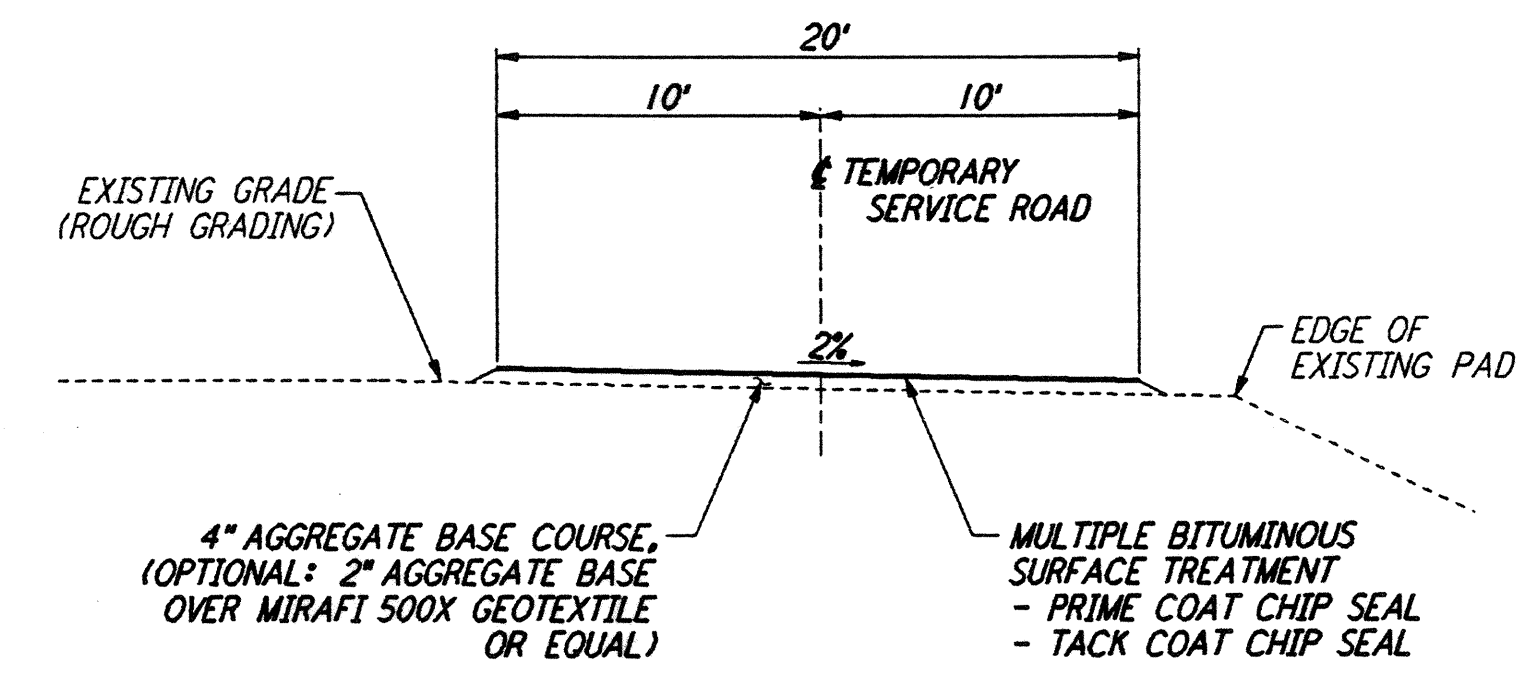


TEMPORARY SERVICE ROAD
 NOT TO SCALE

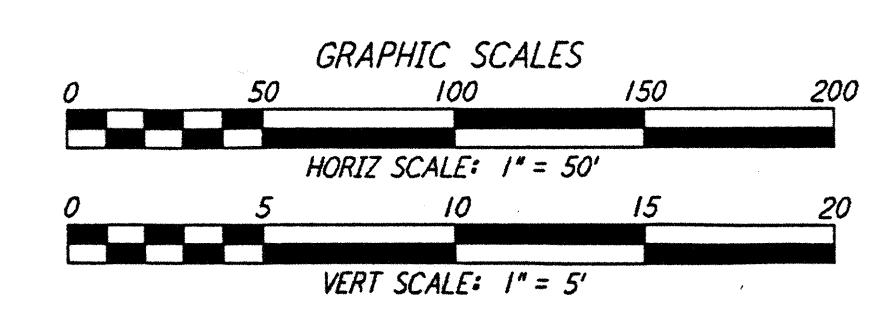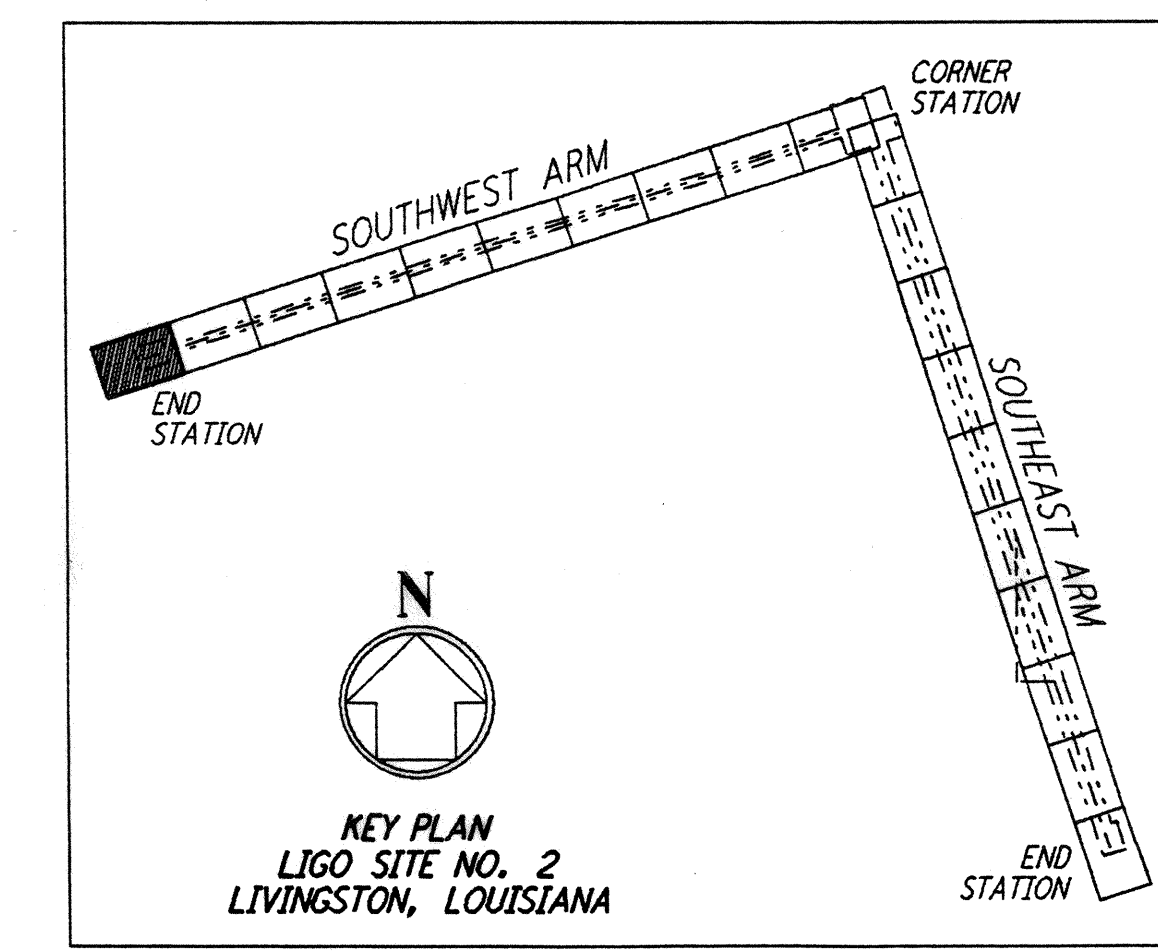

NO.	DATE	BY	CHKD	ENGR	PROJ	REVISIONS	DESCRIPTION
1	2-3-97	WRB	CL	JB	TDM	REVISED PROFILE ELEVATIONS	

ISSUED FOR CONSTRUCTION			
DRAWN	WRB	11-15-96	
CHECKED	ML	11-15-96	
ENGINEER	JB	11-15-96	
PROJ	TDM	11-15-96	

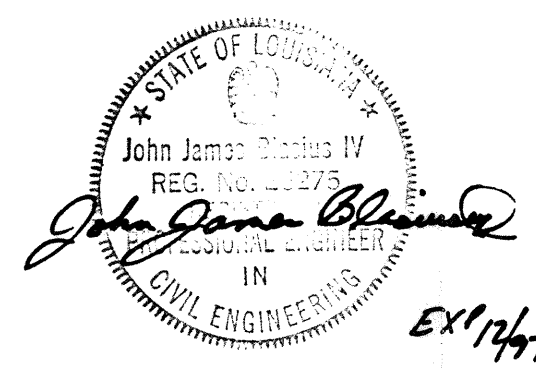

PARSONS
 100 WEST WALNUT STREET
 PASADENA, CALIFORNIA

LIGO
 CALIFORNIA INSTITUTE OF TECHNOLOGY
 MASSACHUSETTS INSTITUTE OF TECHNOLOGY

LASER INTERFEROMETER GRAVITATIONAL-WAVE OBSERVATORY BEAM TUBE ENCLOSURE - LIVINGSTON, LA

TITLE	CIVIL	CONTRACT NUMBER	PP150969	PROJECT NUMBER	8094
SHEET NUMBER	LA-C-520	SCALE	AS NOTED		

LIGO-D961274-01-0