
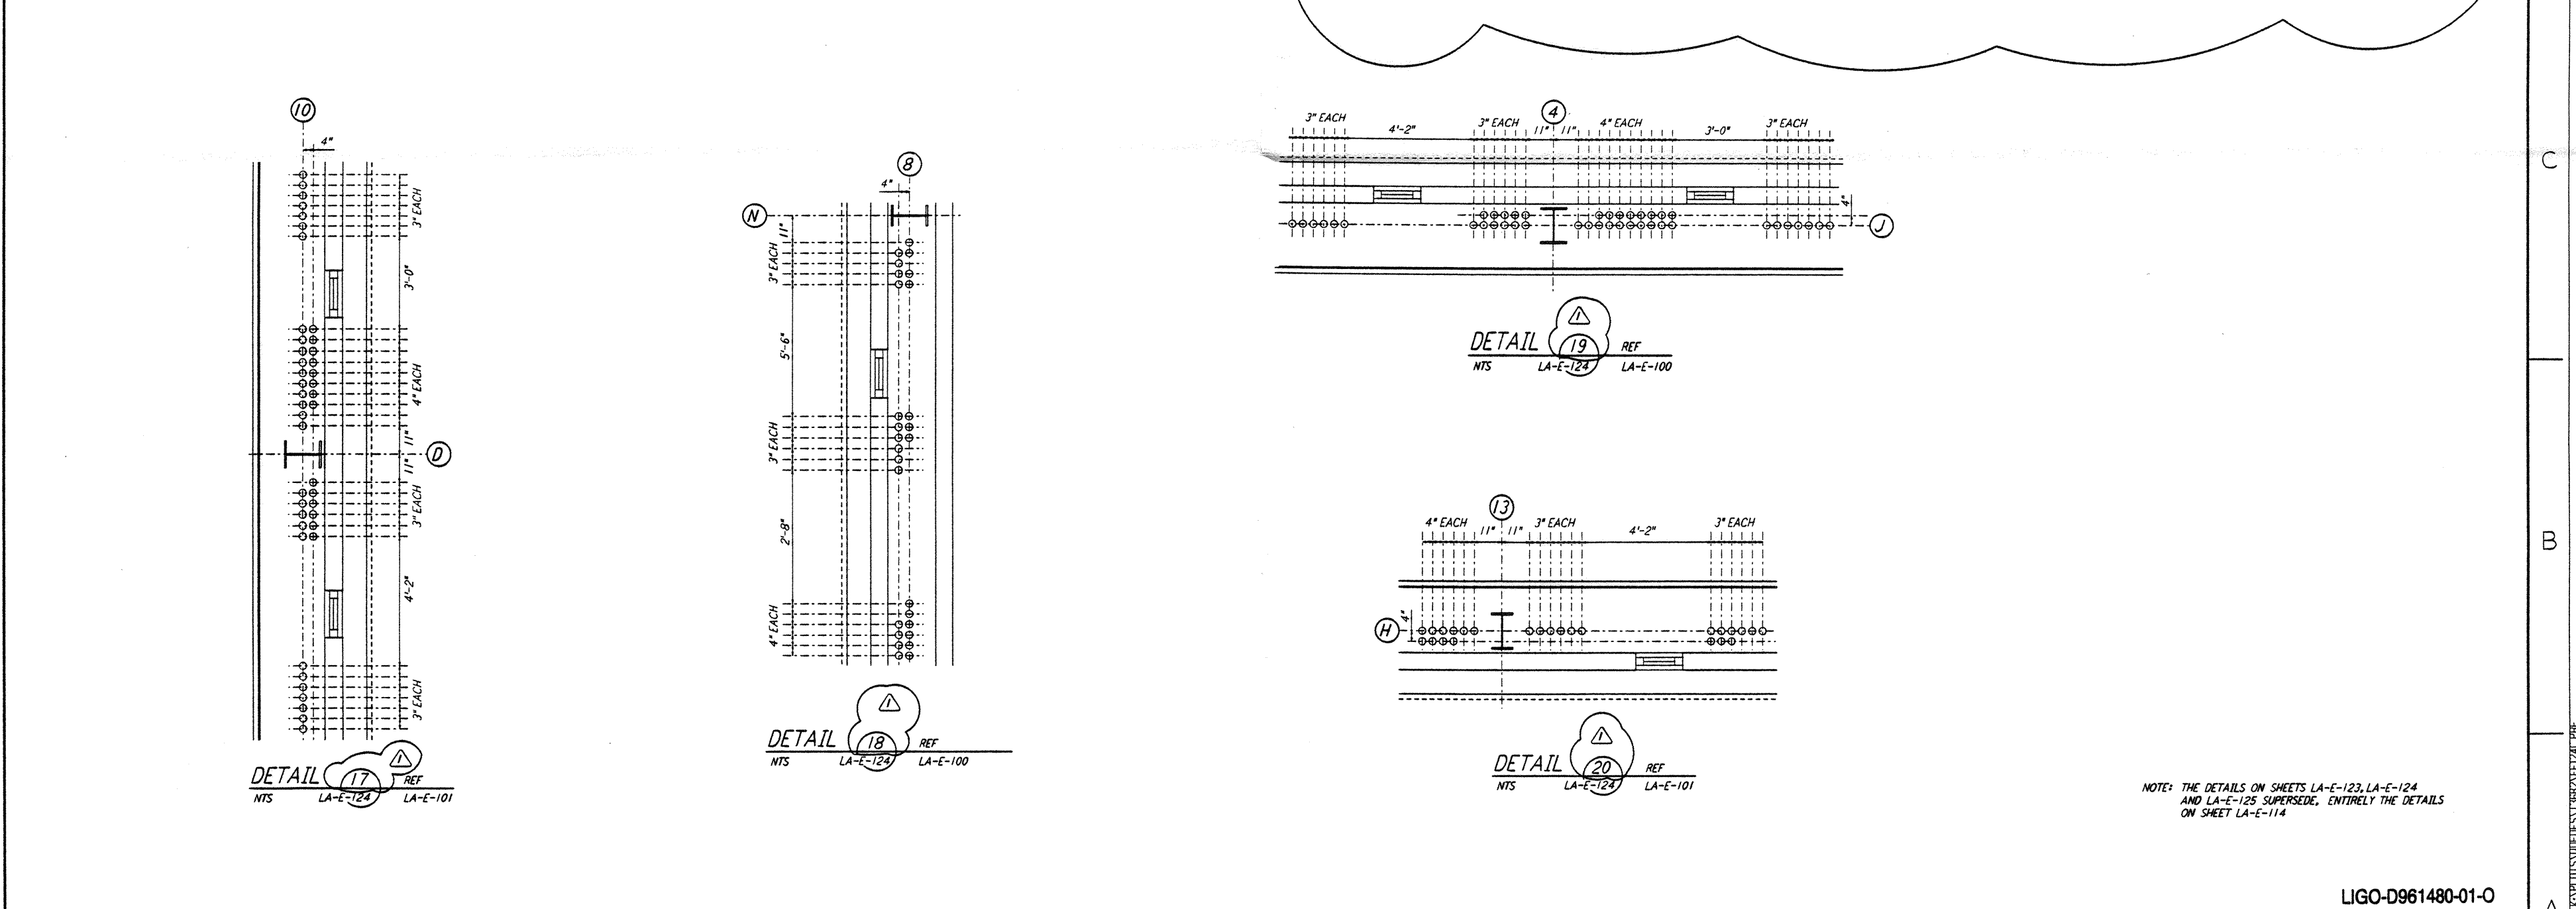


This document and the design it covers are the property of PARSONS. They are loaned only with the borrower's expressed written agreement that they will not be reproduced, copied, loaned, exhibited, or used in any other way, except by written consent from PARSONS to the borrower.

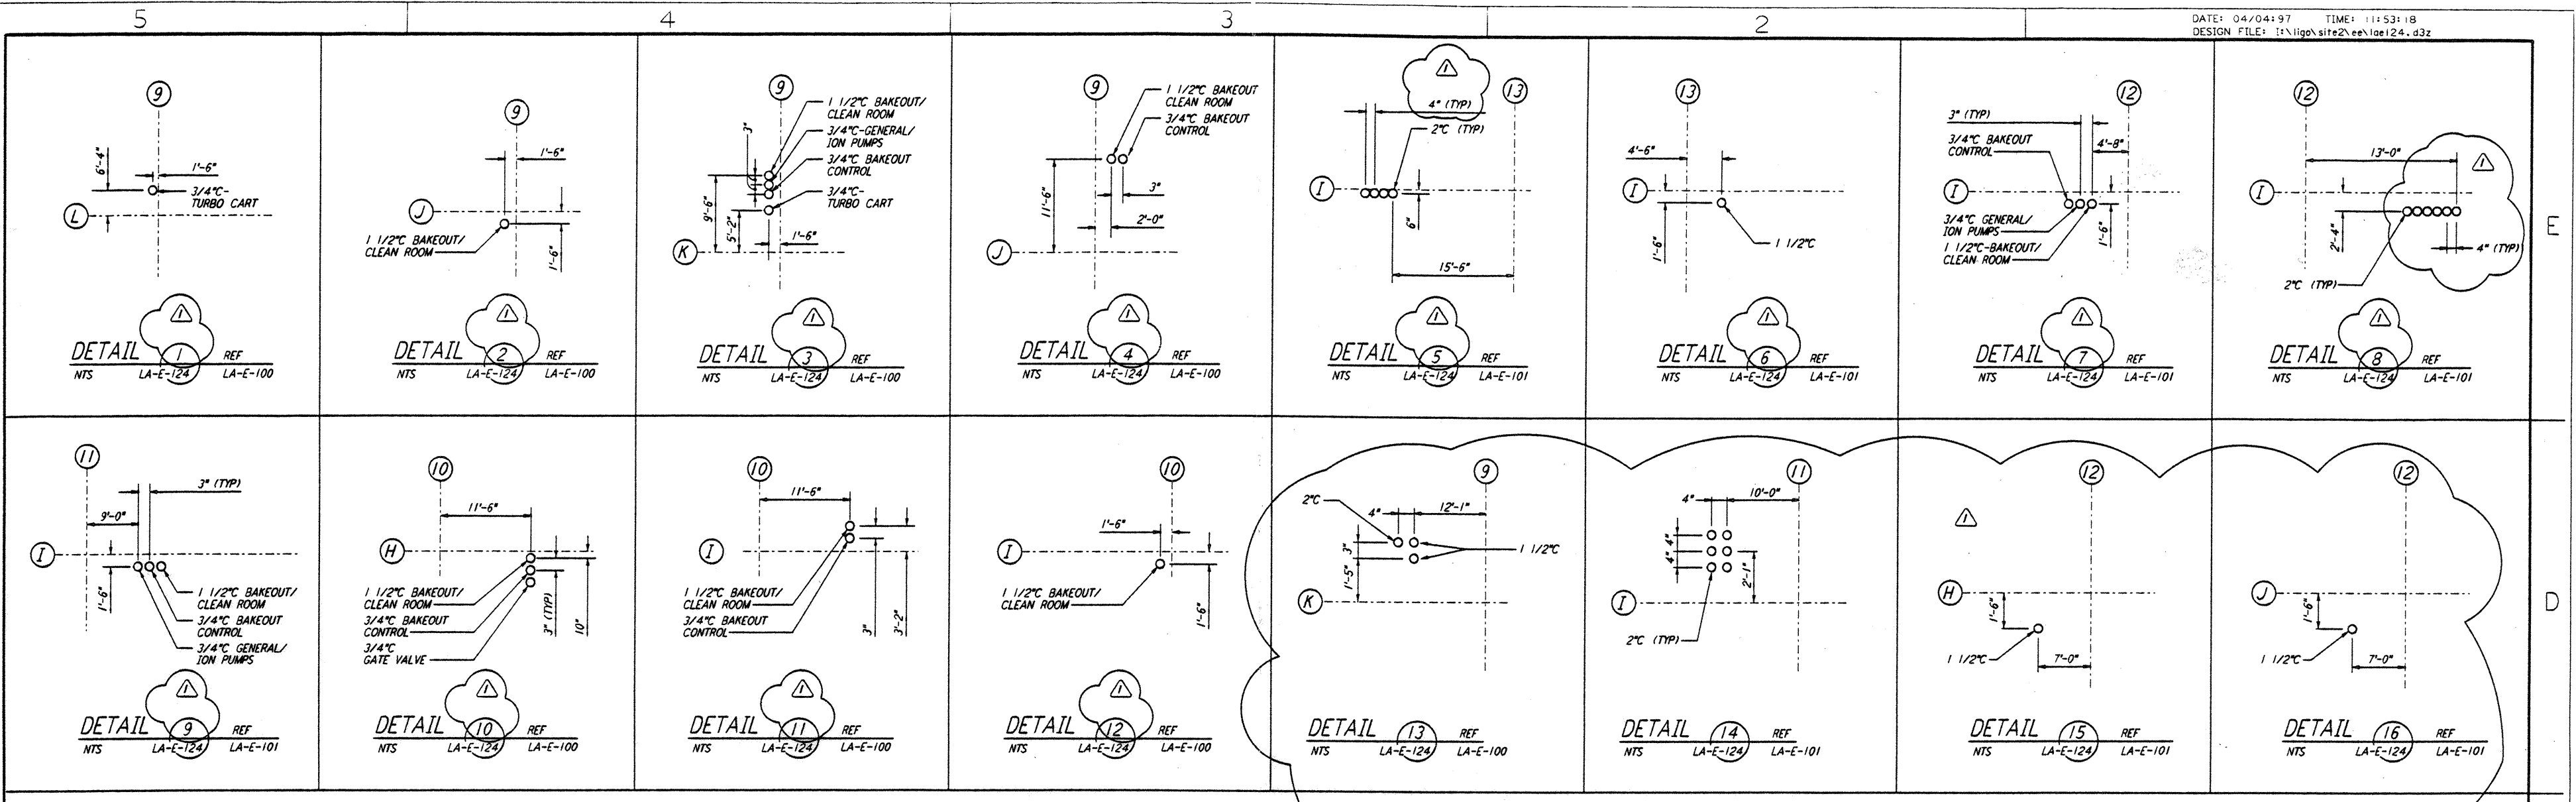

NOTE: THE DETAILS ON SHEETS LA-E-123, LA-E-124 AND LA-E-125 SUPERSEDE, ENTIRELY THE DETAILS ON SHEET LA-E-114

<p>ISSUED FOR CONSTRUCTION</p> <p>DRAWN J. G. 3-21-97</p> <p>CHECKED B. K. 3-21-97</p> <p>ENGINEER X. C. R. 3-21-97</p> <p>PROJ. T. D. M. 3-21-97</p>		<p>100 WEST WALNUT STREET PASADENA, CALIFORNIA</p>	<p>CALIFORNIA INSTITUTE OF TECHNOLOGY MASSACHUSETTS INSTITUTE OF TECHNOLOGY</p>	<p>LASER INTERFEROMETER GRAVITATIONAL-WAVE OBSERVATORY SITE NO. 2 - LIVINGSTON, LOUISIANA</p> <p>TITLE: ELECTRICAL CORNER STATION LVEA AREAS 101, 102, 103, 104 DETAILS</p> <p>SCALE: NONE CONTRACT NUMBER: PPI50969 PROJECT NUMBER: 8094</p> <p style="font-size: 1.2em; font-weight: bold;">LA-E-124</p>														
<p>REVISIONS</p> <table border="1" style="width: 100%; border-collapse: collapse;"> <tr> <th>NO.</th> <th>DATE</th> <th>BY</th> <th>CHKD</th> <th>ENGR</th> <th>PROJ</th> <th>DESCRIPTION</th> </tr> <tr> <td>1</td> <td>4-4-97</td> <td>J. G.</td> <td></td> <td></td> <td></td> <td>GENERAL REVISIONS</td> </tr> </table>	NO.	DATE	BY	CHKD	ENGR	PROJ	DESCRIPTION	1	4-4-97	J. G.				GENERAL REVISIONS				
NO.	DATE	BY	CHKD	ENGR	PROJ	DESCRIPTION												
1	4-4-97	J. G.				GENERAL REVISIONS												
<p>REFERENCES</p> <table border="1" style="width: 100%; border-collapse: collapse;"> <tr> <th>DRAWING NO.</th> <th>DESCRIPTION</th> </tr> <tr> <td> </td> <td> </td> </tr> </table>	DRAWING NO.	DESCRIPTION																
DRAWING NO.	DESCRIPTION																	