


REVISIONS			
REV.	DESCRIPTION	APPROVED	DATE
A	RELEASED		
B	REVISED (FOR 2 BEARINGS) AND REDRAWN	AJL	9-6-96
C	REDRAWN IN NEW BORDER	AJL	10-26-96

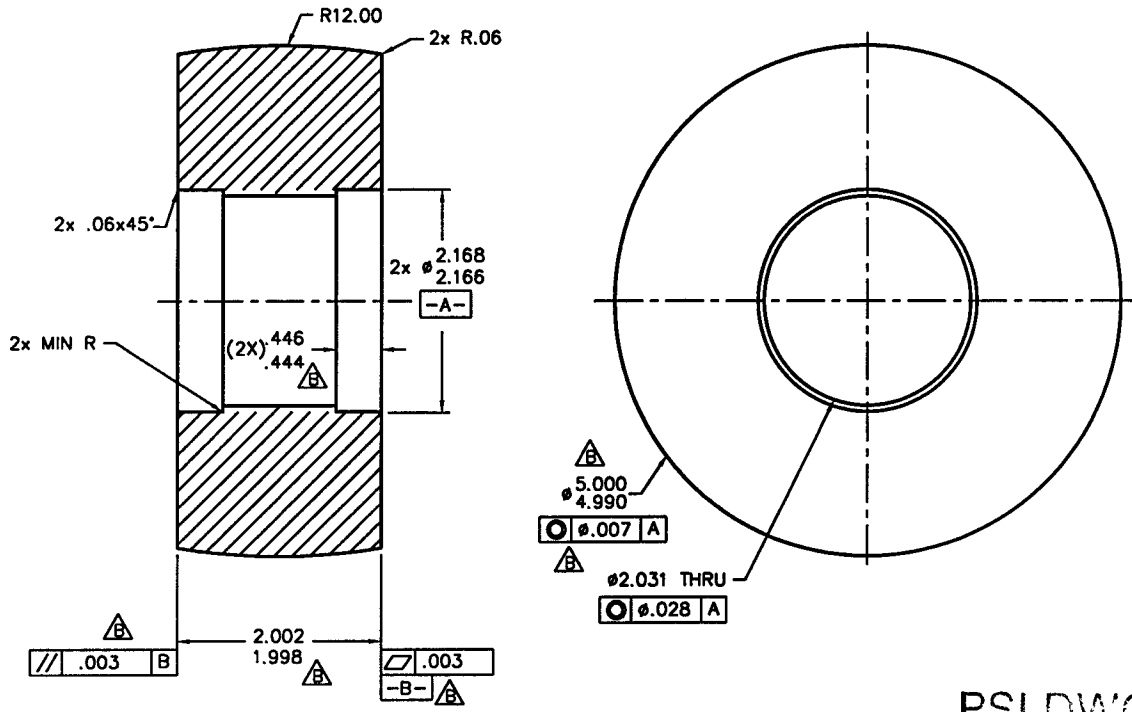

DEC 19 1996

PSI DWG # V049-8-495

ITEM	QTY.	PART NO.	DESCRIPTION
PART LIST			MATERIAL SPECIFICATION: 17-4PH, COND.H900
<small>UNLESS OTHERWISE SPECIFIED DIMENSIONS ARE IN INCHES TOLERANCES ARE:</small> DECIMALS .XX ± .01 ± 10° FINISH 32/ ANGLES .XXX ± .005 <small>UNSPECIFIED FILLETS: R.015 BREAK EDGES .010 x 45° REMOVE ALL BURRS</small>		CONTRACT OR SALES ORDER NO.	GNB Corporation SCIENTIFIC AND INDUSTRIAL EQUIPMENT 30971 San Benito Ct. HAYWARD, CALIFORNIA 94544 (510) 441-1900 FAX: (510) 441-0939
THIRD ANGLE PROJECTION		APPROX. WT.	
DRAFTER: AJL CHECKER: ENGINEER:		DATE: 10-28-96	
DO NOT SCALE DRAWING CADD FILE NAME: A103234C		TITLE: SIDE WHEEL G44, G48 DWG. NO. 103234 SCALE: NONE SHEET 1 OF 1	

A103253
USED ON

REV. C
A
DWG. NO. 103234

L190-D96 1611-C-V