
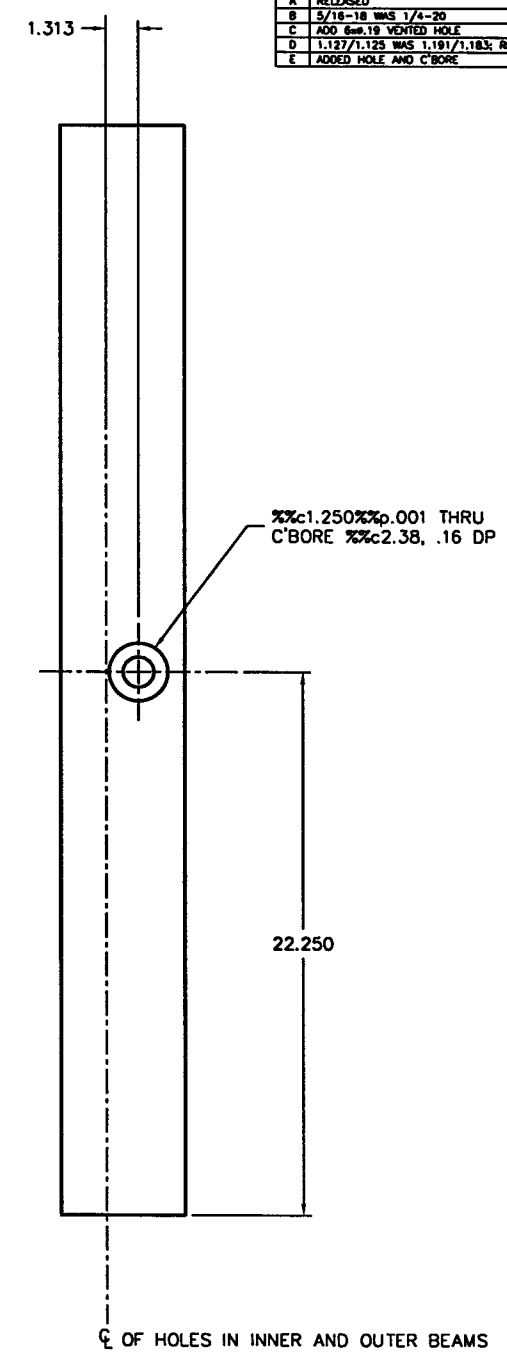


REV.	DESCRIPTION	APPROVED	DATE
A	RELEASED		
B	5/18-18 WAS 1/4-20		
C	ADD 6x .19 VENTED HOLE		
D	1.127/1.125 WAS 1.191/1.183; REDRAWN	A.J.L.	10-15-96
E	ADDED HOLE AND C'BORE	A.J.L.	10-29-96

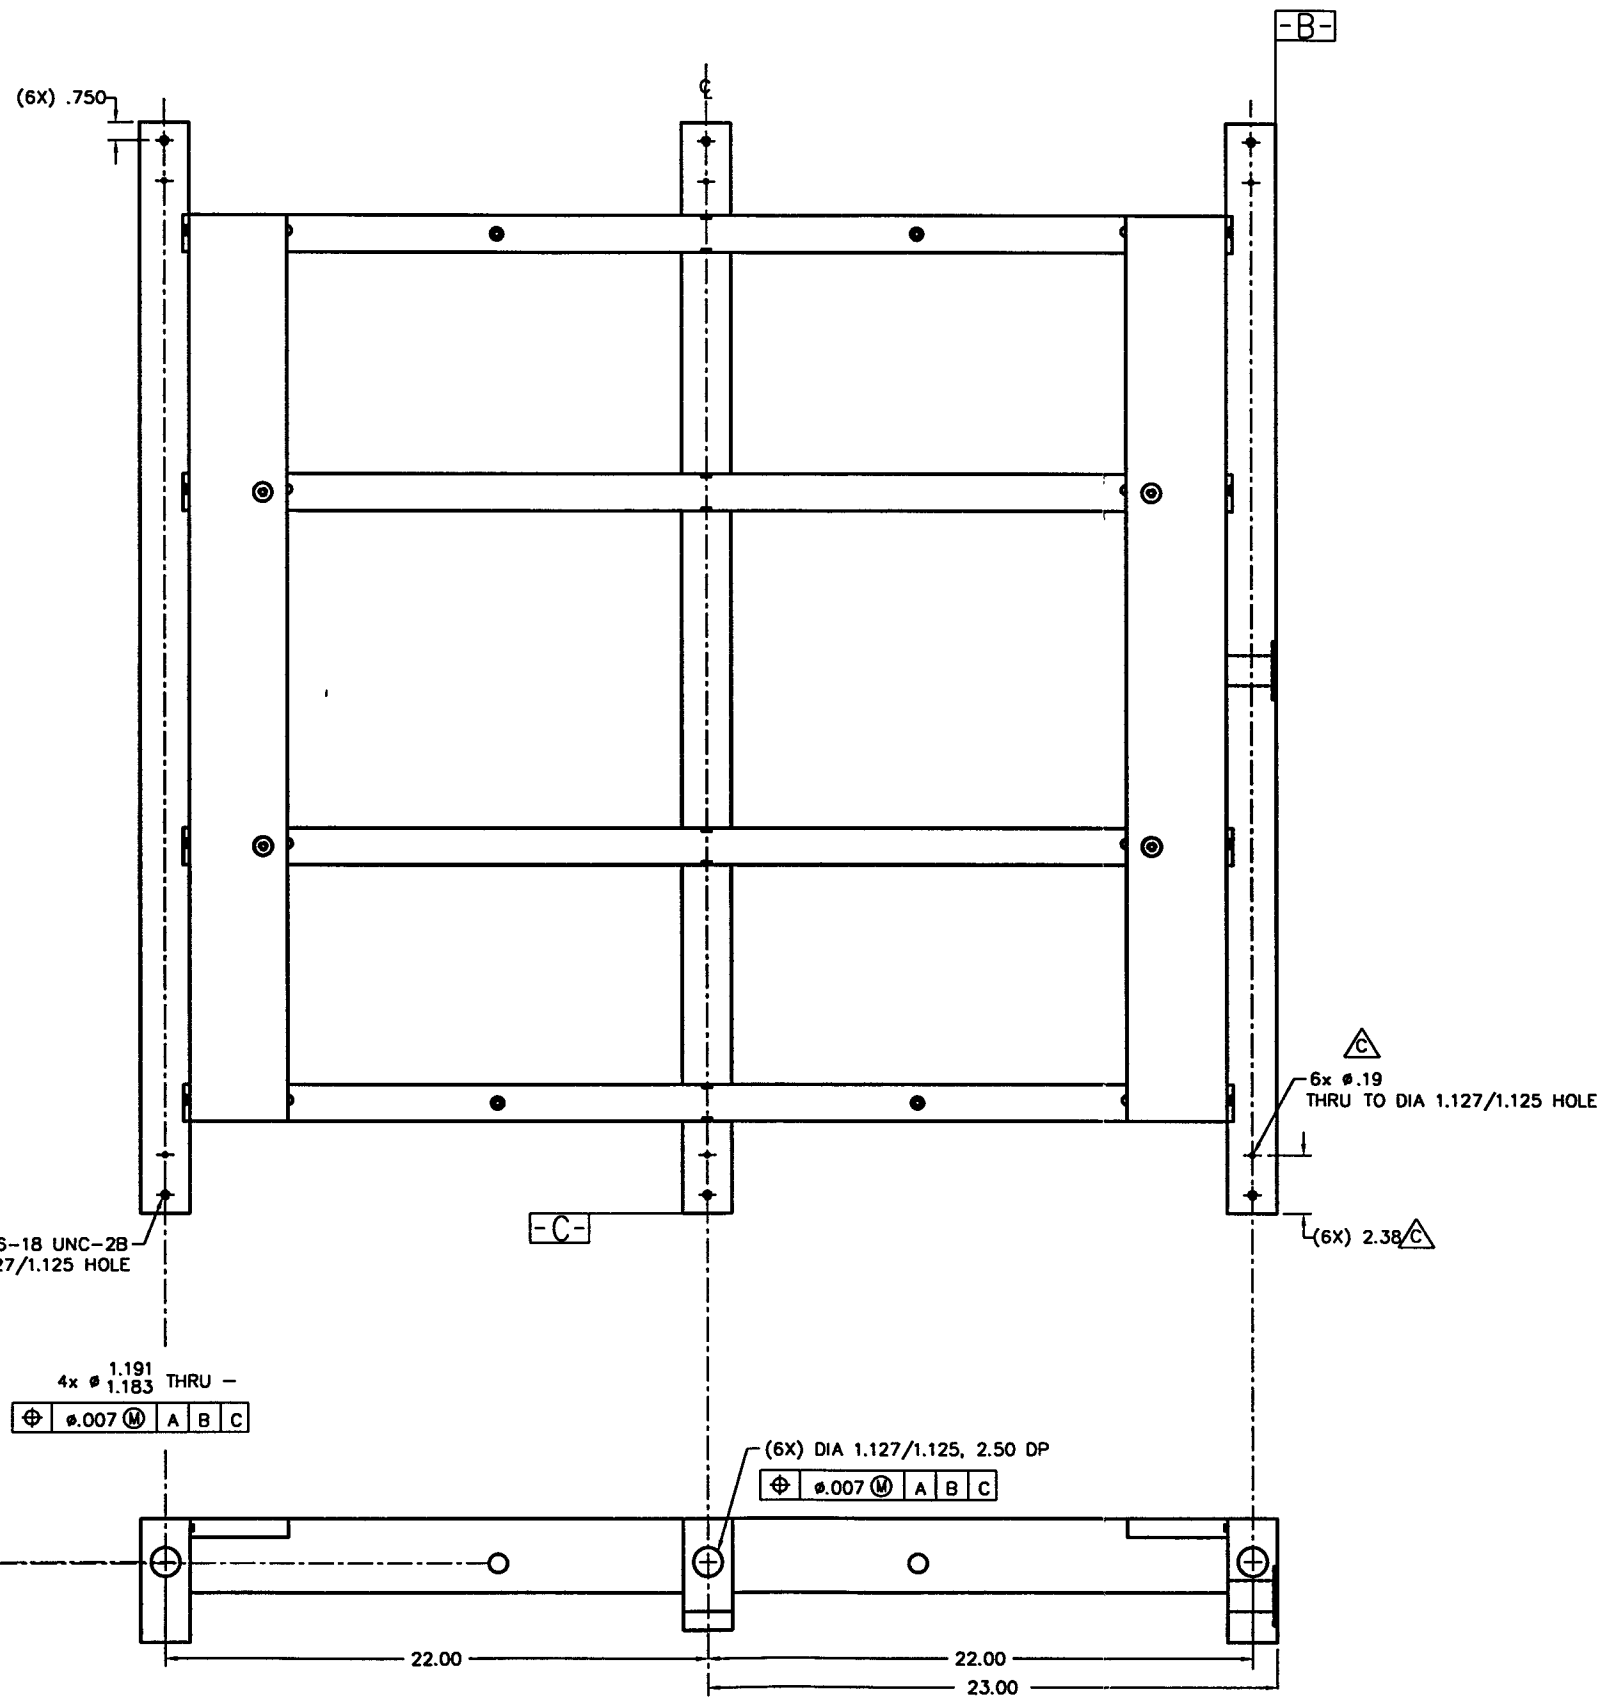

OF HOLES IN INNER AND OUTER BEAMS  
(6X) .062

DEC 19 1996

PSI DWG # V049-8-531  
LIGO-D9616A7-E-V

ITEM	QTY.	PART NO.	DESCRIPTION
		D103789	CARRIAGE WELDMENT (LESS ITEMS 1,9,10)
PART LIST			
MATERIAL SPECIFICATION			
<b>GNB Corporation</b> SCIENTIFIC AND INDUSTRIAL EQUIPMENT 3001 San Ramon Ct. Hayward, California 94544 (415) 881-1000 Fax: (415) 881-1009			
DATE		REV.	
A.J.L.		10-25-96	
D103789		D103236E	
USED ON		NONE	
		SHEET 1 OF 1	